


#22473  
 APPROVED  
 LORAIN CO.  
 MAP DEPT  
 DATE 3/20/98  
 PAGE 8-B  
 BY K. (01/201)bert  
 #22473

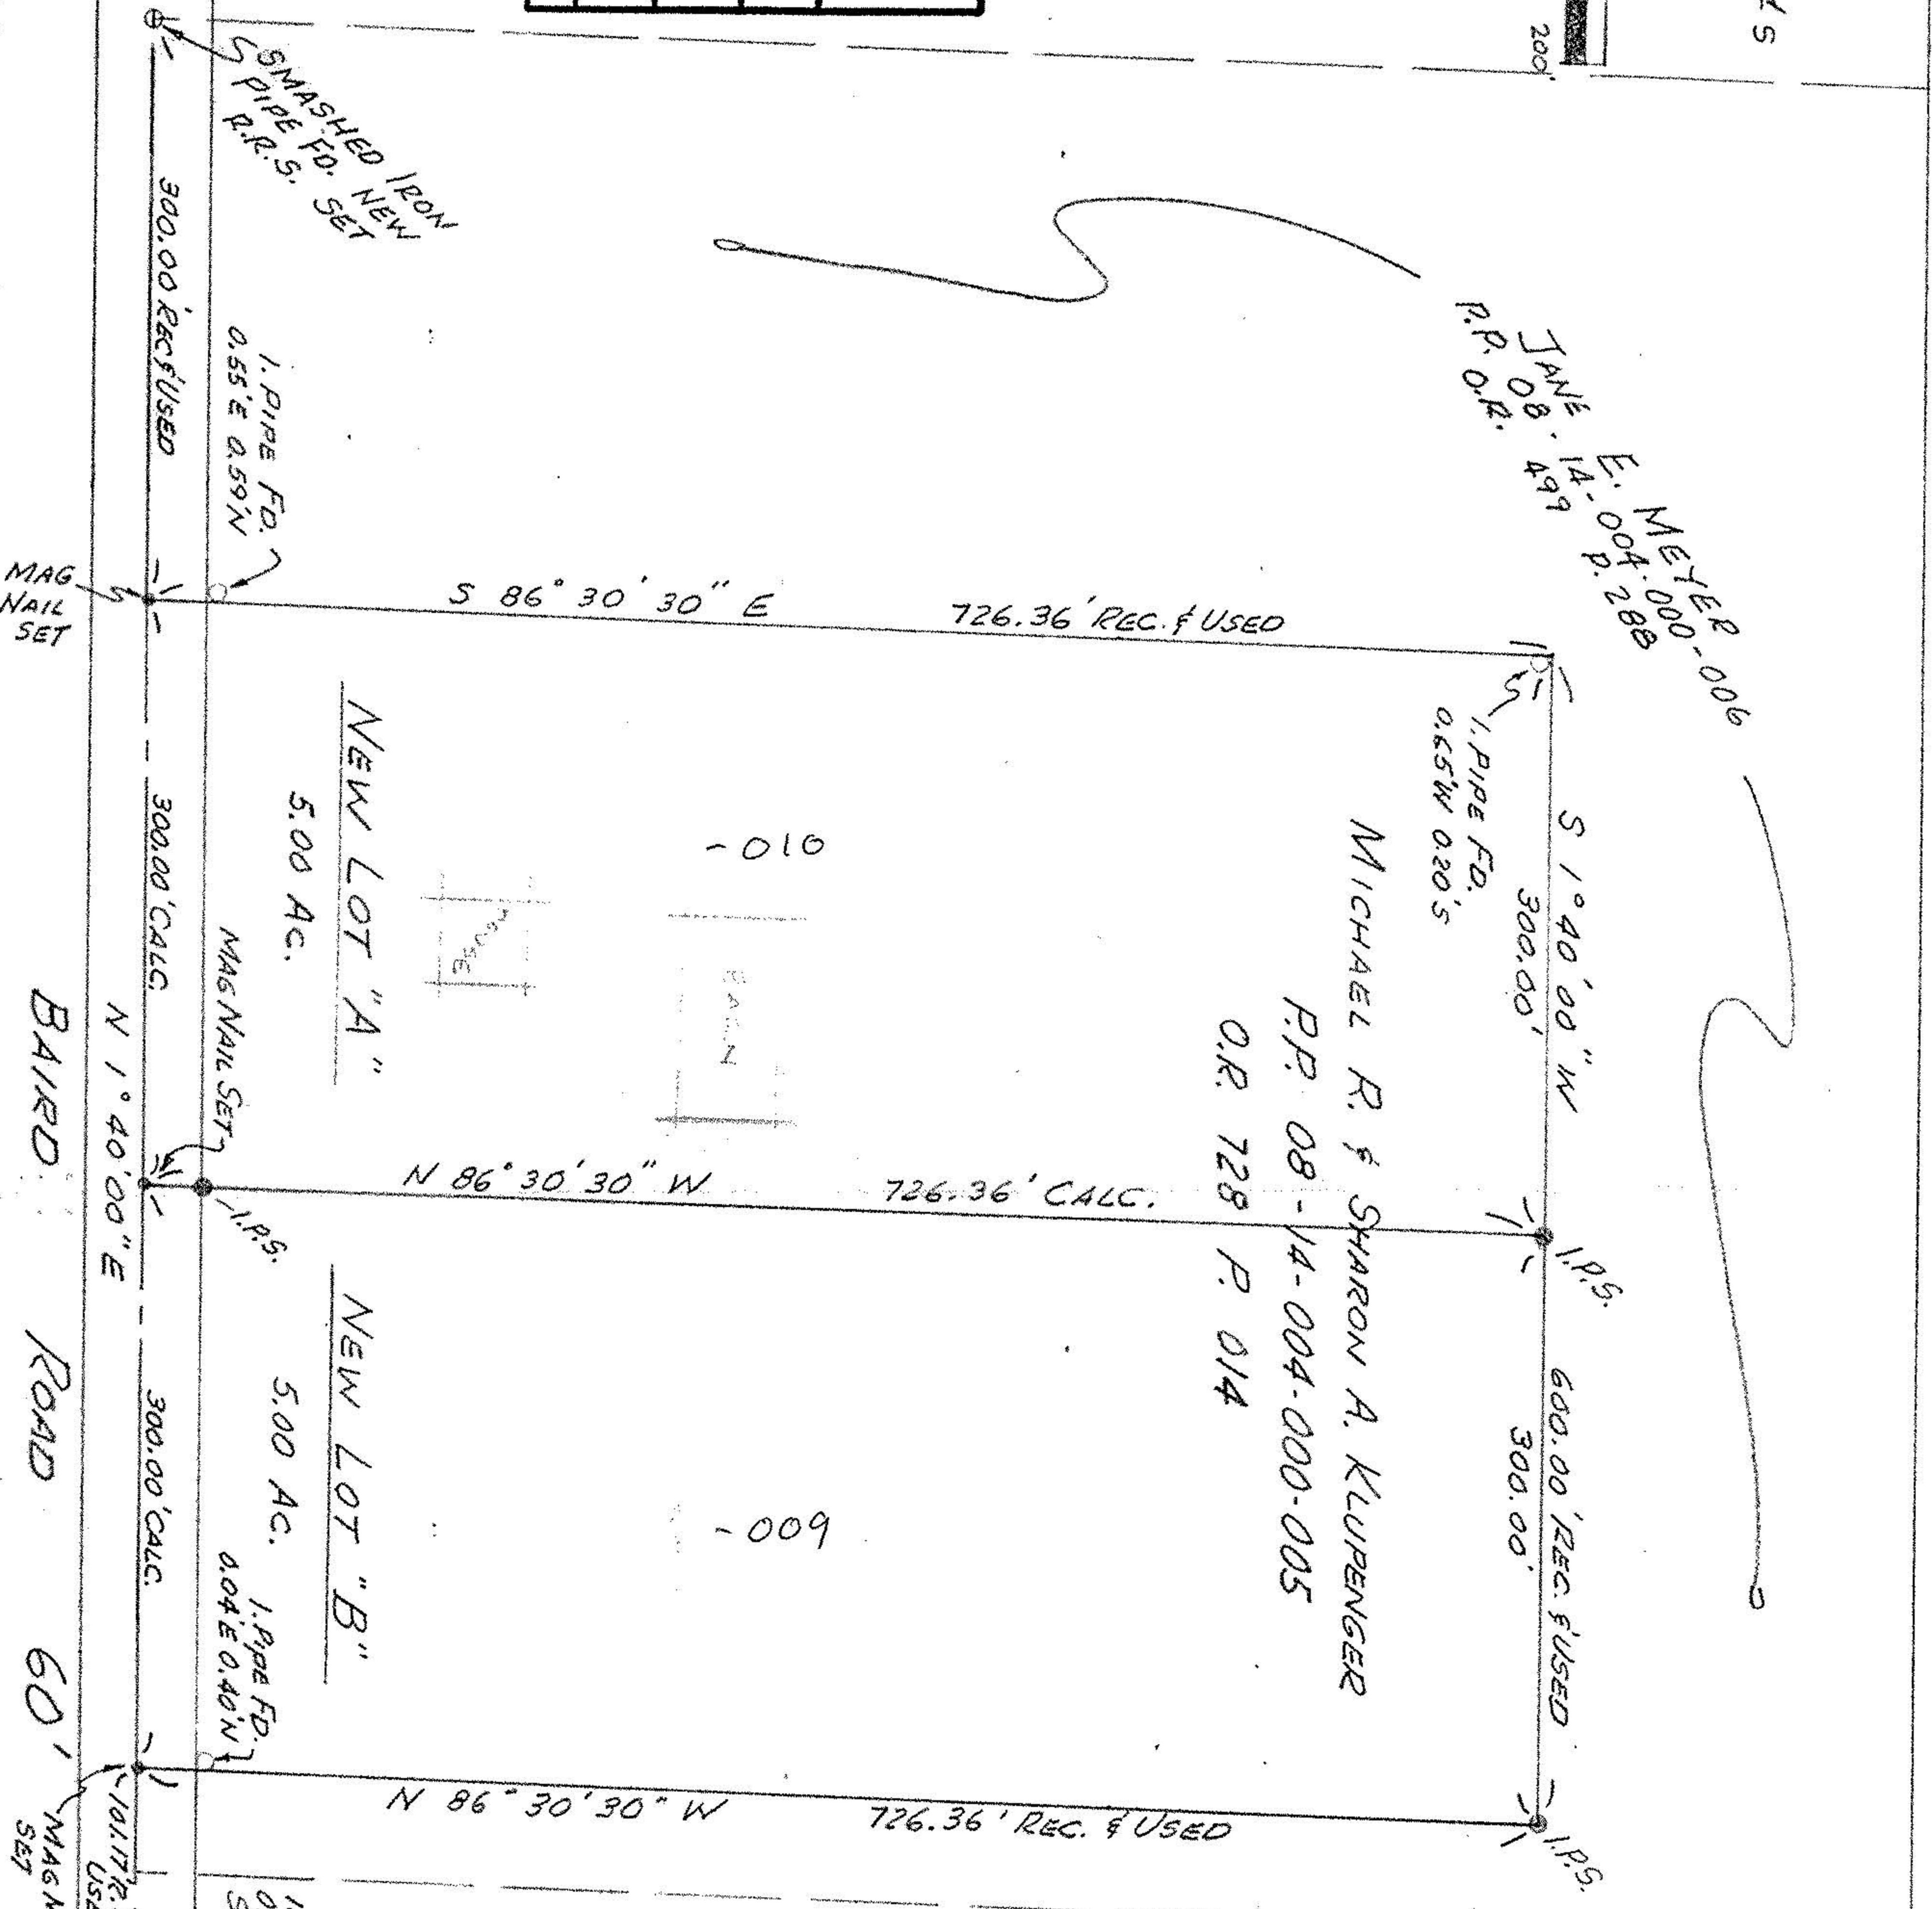

**MAP OF SURVEY AND LOT SPLIT**

PREPARED FOR

**MICHAEL R. & SHARON A. KLUPENGER**


SITUATED IN THE TOWNSHIP OF HENRIETTA, COUNTY OF LORAIN, STATE OF OHIO AND BEING KNOWN AS PART OF ORIGINAL HENRIETTA TOWNSHIP LOT 4, TRACT 14

**SURVEYOR'S STATEMENT**

DISTANCES ARE EXPRESSED IN FEET AND DECIMAL PARTS THEREOF. BEARINGS ARE TO AN ASSUMED MERIDIAN AND ARE USED TO INDICATE ANGLES ONLY. PERMANENT MONUMENTS WERE FOUND OR SET AS INDICATED HEREON. — O — I.P.S. INDICATES A 5/8" DIA IRON PIN WITH CAP SET. ALL OF WHICH I DECLARE TO BE CORRECT TO THE BEST OF MY ABILITIES AND BELIEF.

THOMAS M. SNEZEK, P.L.S. #7051

DATE 2-5-98

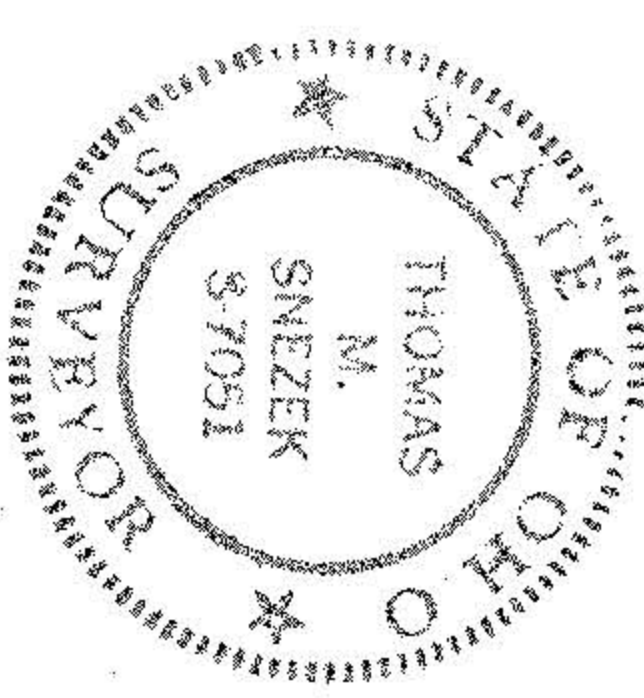

1. PIPE FOUND BENT 0.27'S. P.K. NAIL SET  
 1. P. W/ BRASS CAP IN NON. BOX FD. & USED  
 879.45' R. & USED  
 N 1° 55' 00" E  
 MAG NAIL SET  
 GARFIELD ROAD