


James C Born &  
William & Donna Born  
D, Vol 1113 Pg 230

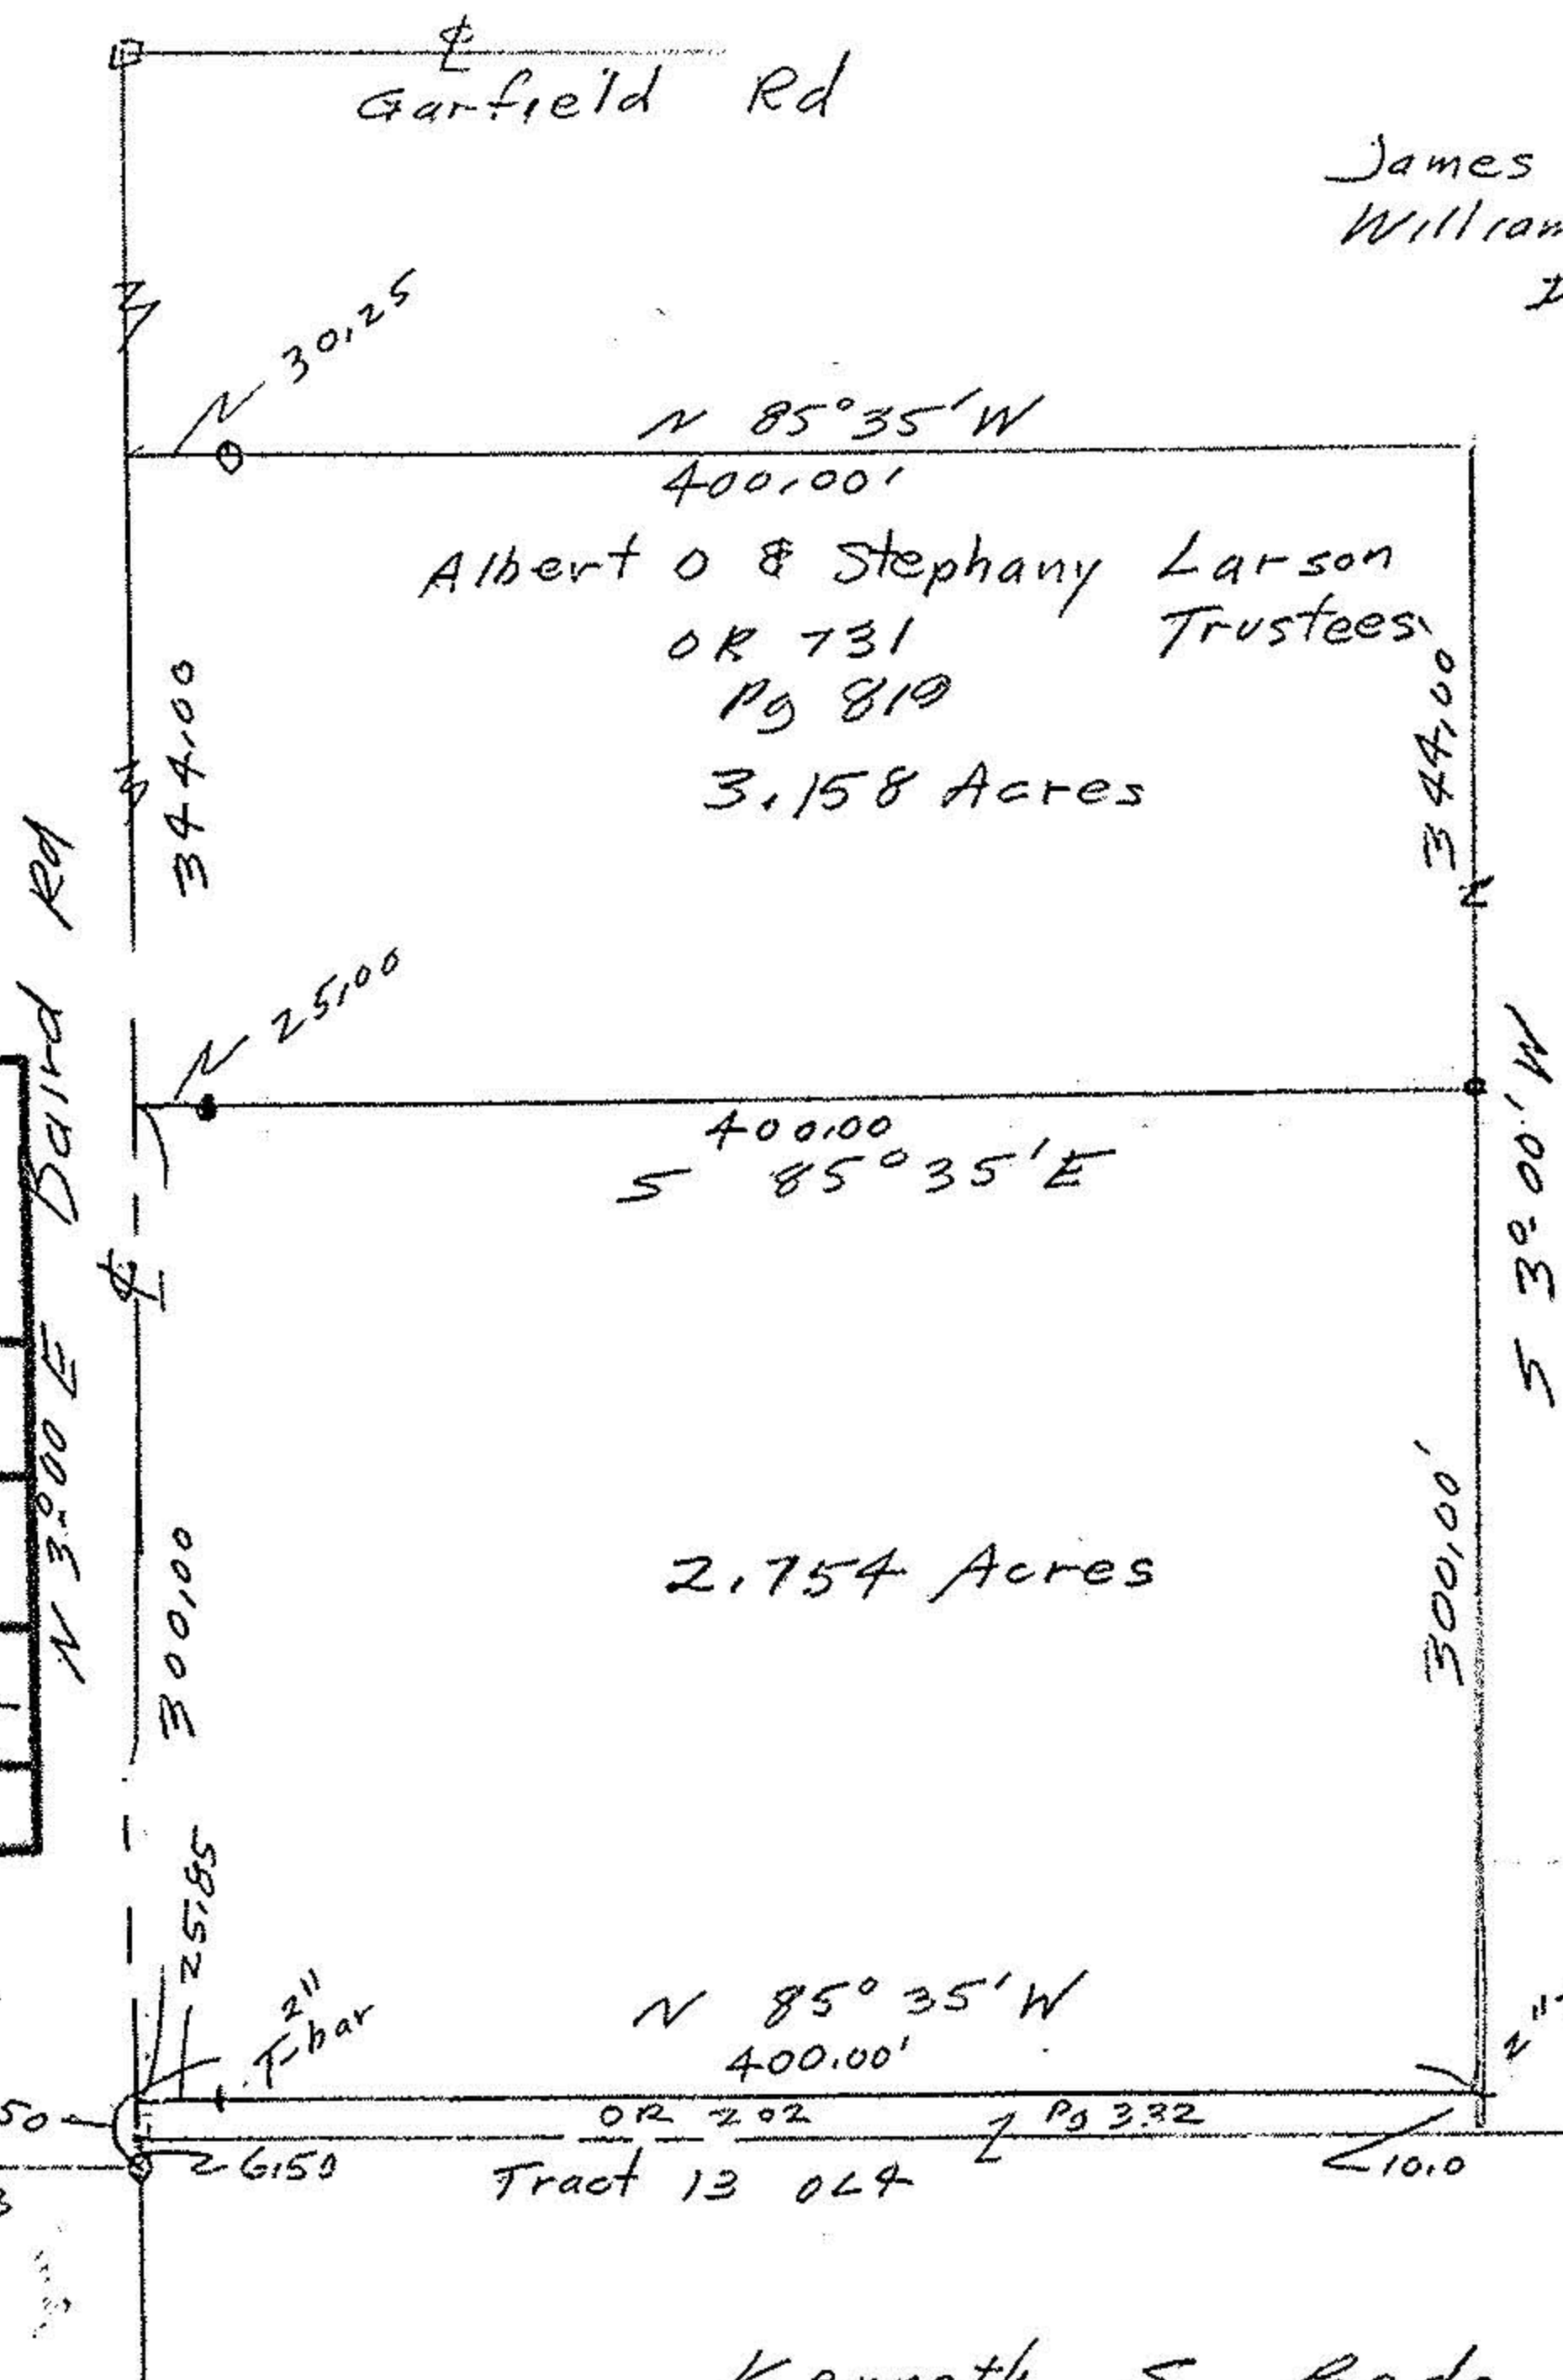

#22396


APPROVED  
LORAIN CO.  
MAP DEPT

DATE 12/30/97

PAGE 8-F

BY K. COLBERT

Kenneth S Bado  
OR 202 Pg 330

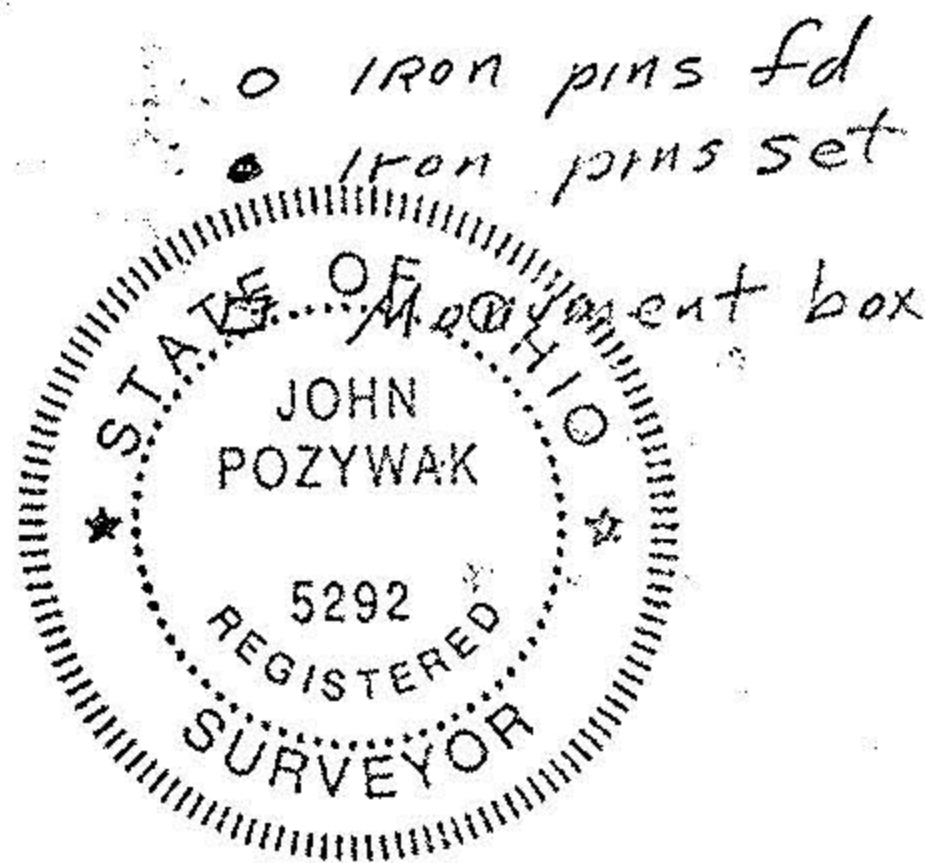

Survey for Parcel Split  
Original Lot 14 Tract 14  
Henritta Township  
Lorain County Ohio  
Scale 1" = 100' NOV 1997  
John Pozzywak  
Reg Surveyor 5292