

08-12-008-000


Map of Part of Lot 8 Tract 12 Henrietta Twp. Lorain Co  
Scale 1" 100'

By Arnold F. Koepf  
Reg. Surveyor No. 4306

Parcel Split Acreage Approx/	
Parcel 011	5.09 Acres
Parcel 008	1.26 Acres

APPROX. PARCEL LINE

BORN

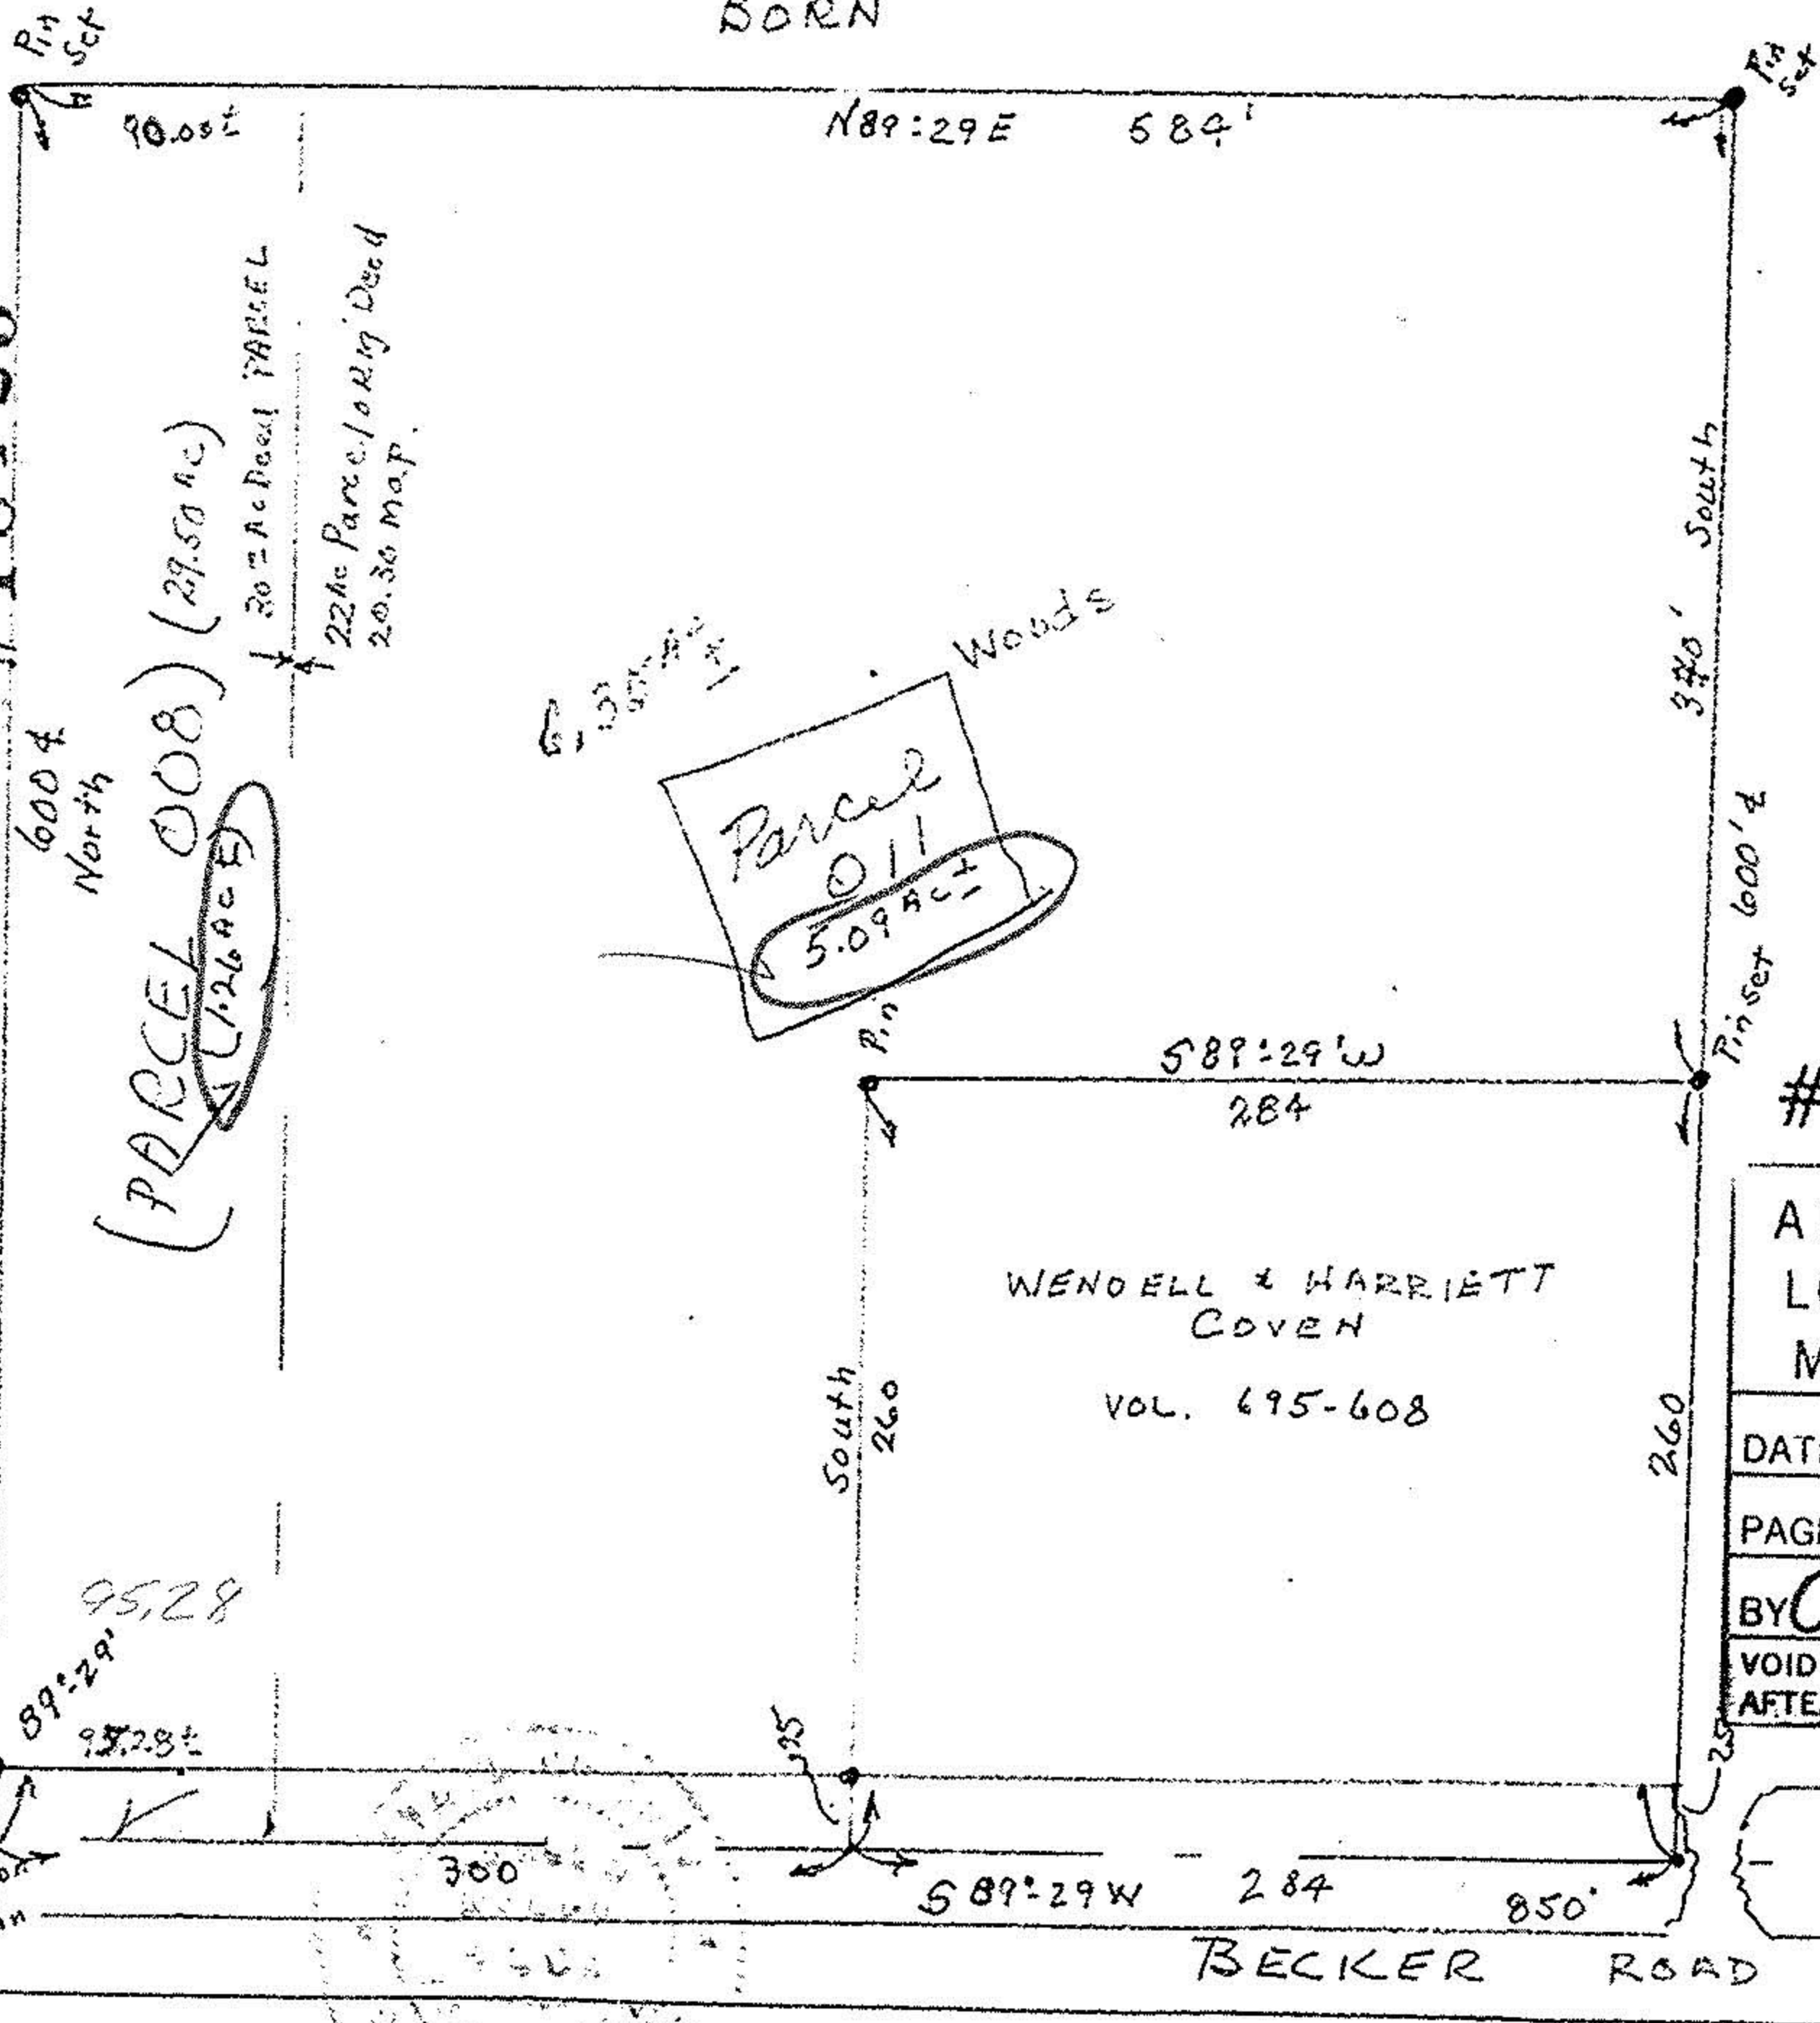

#18423

#18423

APPROVED  
LORAIN CO.  
MAP DEPT.

DATE 5-11-89

PAGE 8-E

BY Carol-Francis

VOID AFTER # 90-3-18423

566' Deed

