



MAP OF SURVEY FOR CORWIN BURRER
 RUSSIA TWP. - LORAIN CO. - D.L. #7
 FEB. 9, 1991 SCALE 1"=100'
 JOHN R. HAMILTON - REG. SURV. #6861

Corwin O. Burrer, et al
 DEED Vol. 1187, P. 466

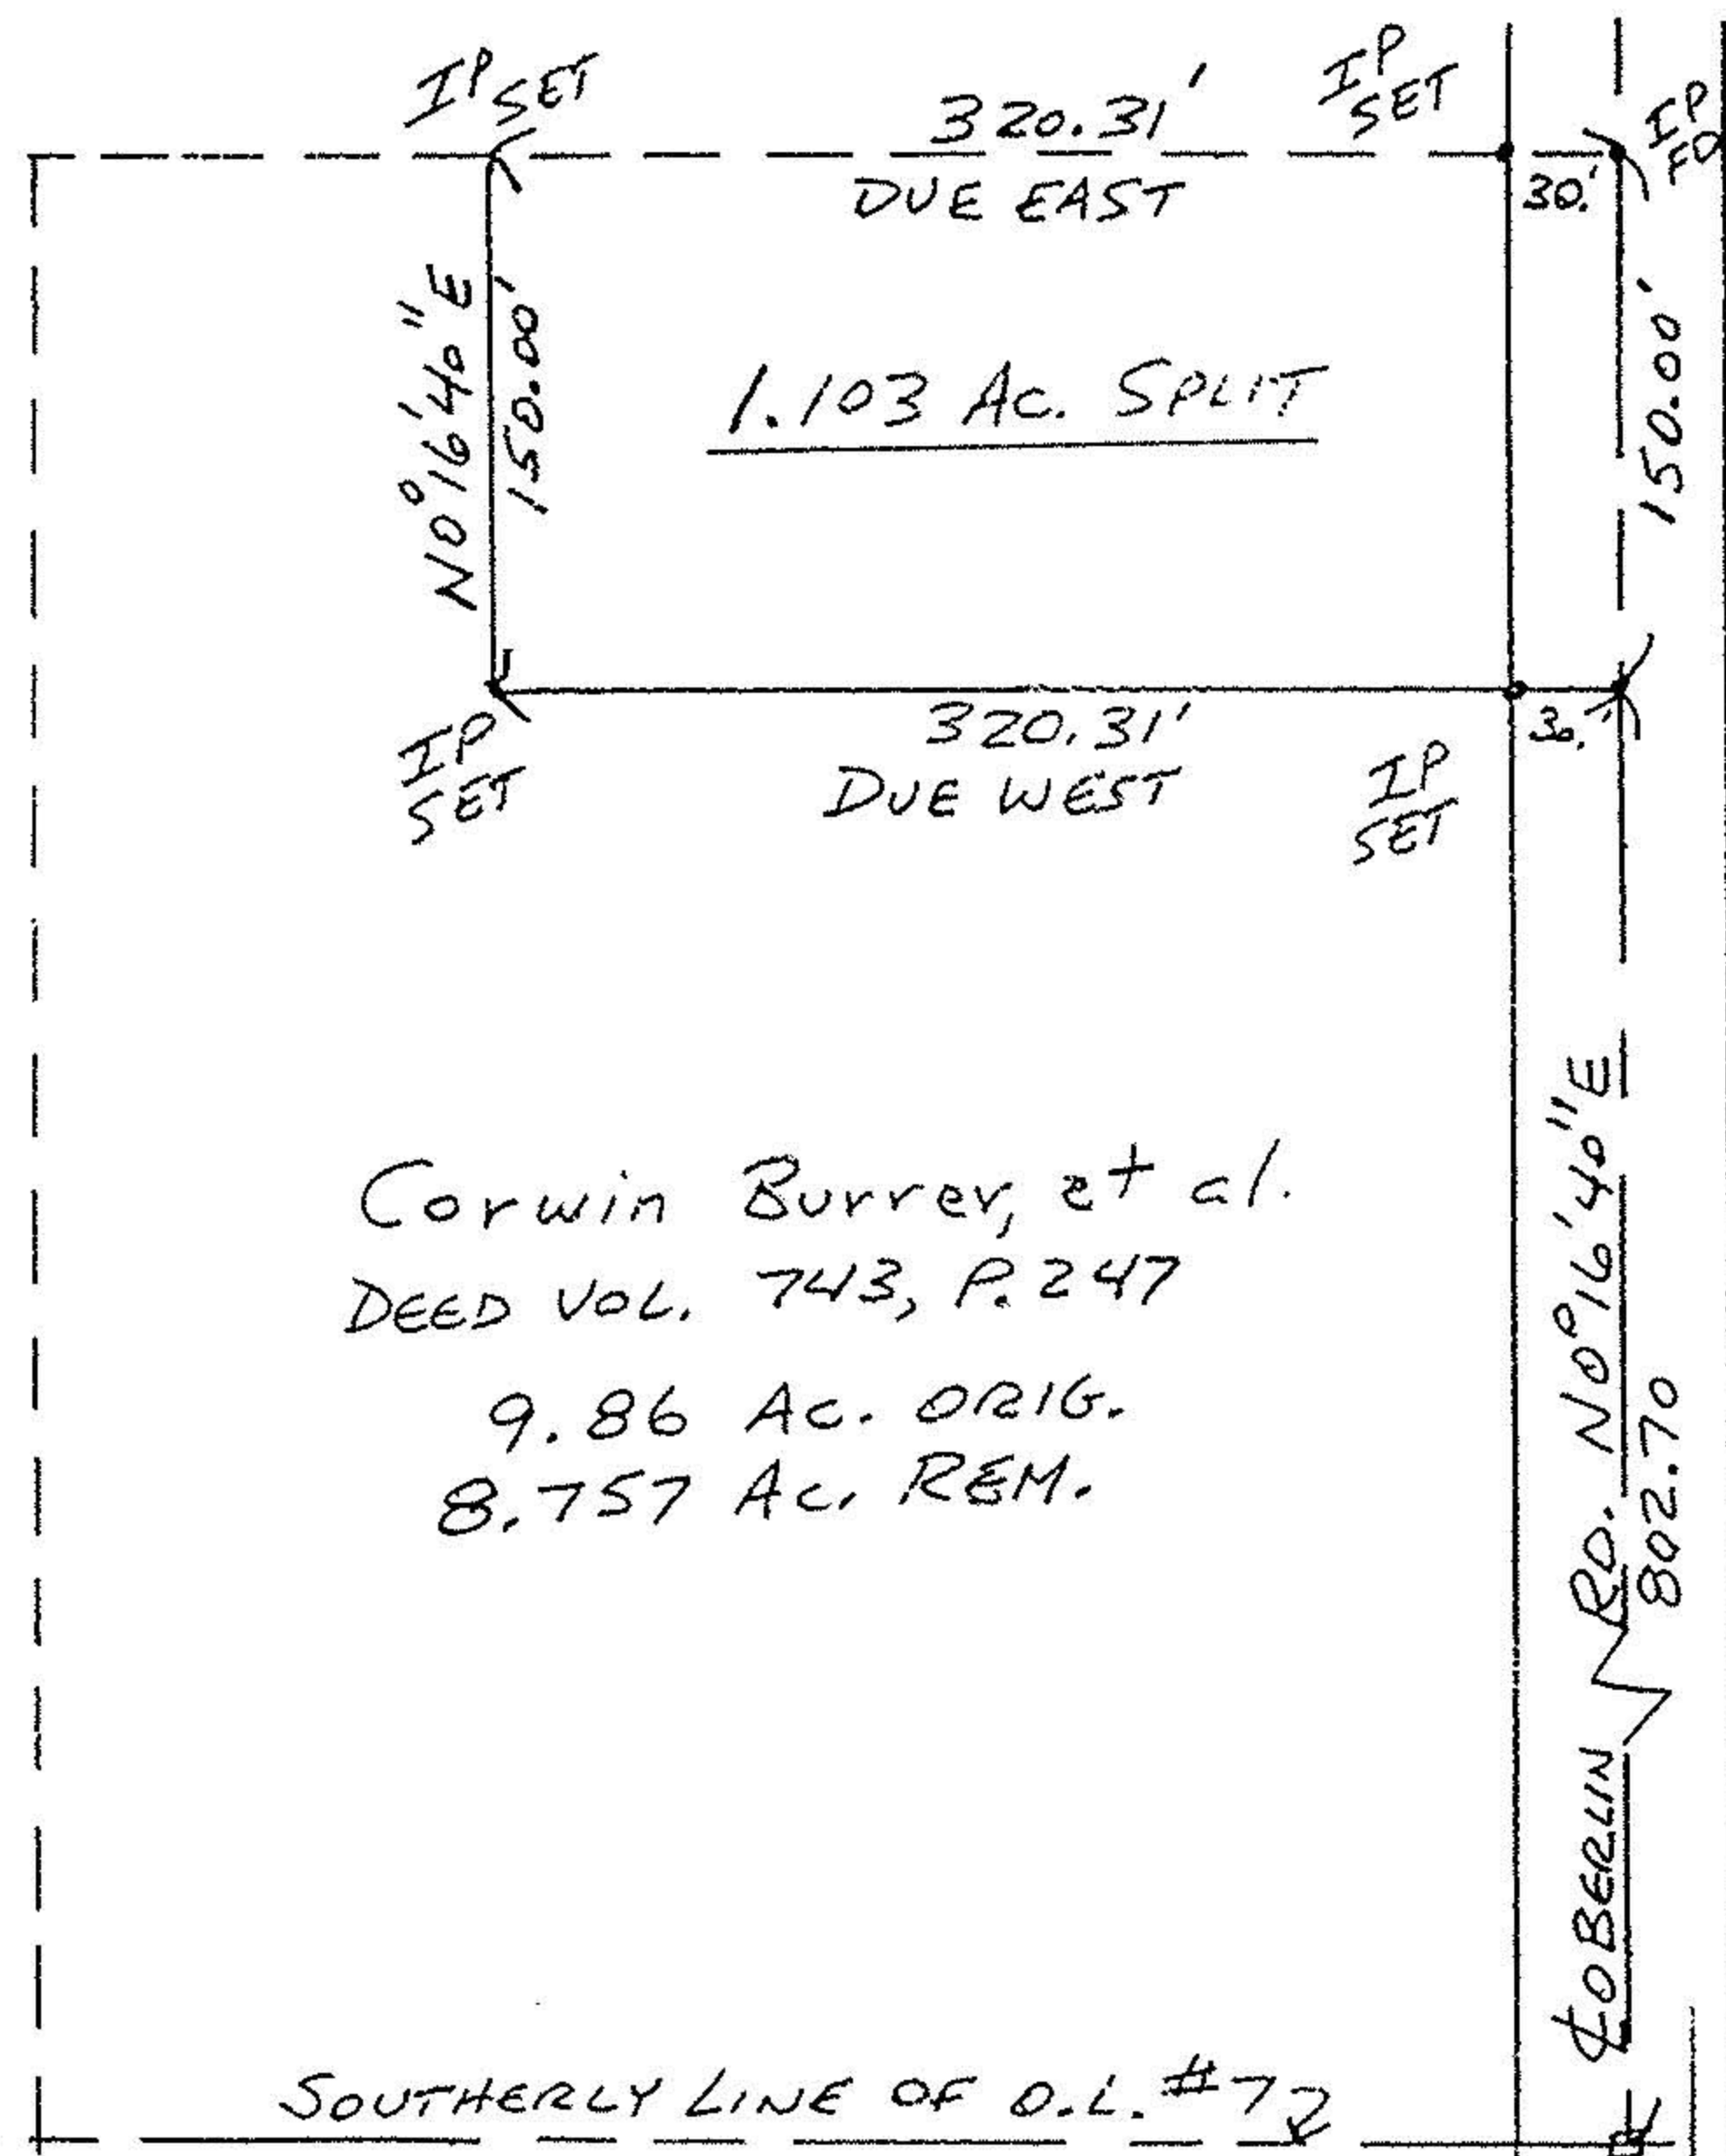

Corwin Burrer, et al.
 DEED VOL. 743, P. 247
 9.86 Ac. ORIG.
 8.757 Ac. REM.

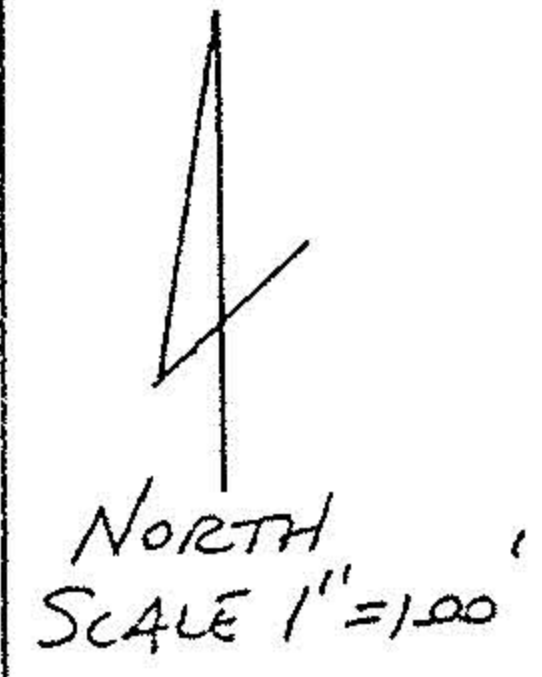

#19394

APPROVED
LORAIN CO.
MAP DEPT.
DATE 5-29-91
PAGE 9-C
BY CAROLYN FRANCIS
VOID AFTER #19394

IP IN MON. BOX

9-C #19394 09-00-007-000-