


11698

APPROVED	
L. TRALE CO.	
MAP DEPT.	
DATE	5/25/78
PAGE	8-11
BY	J. Johnson
VOID AFTER	11698

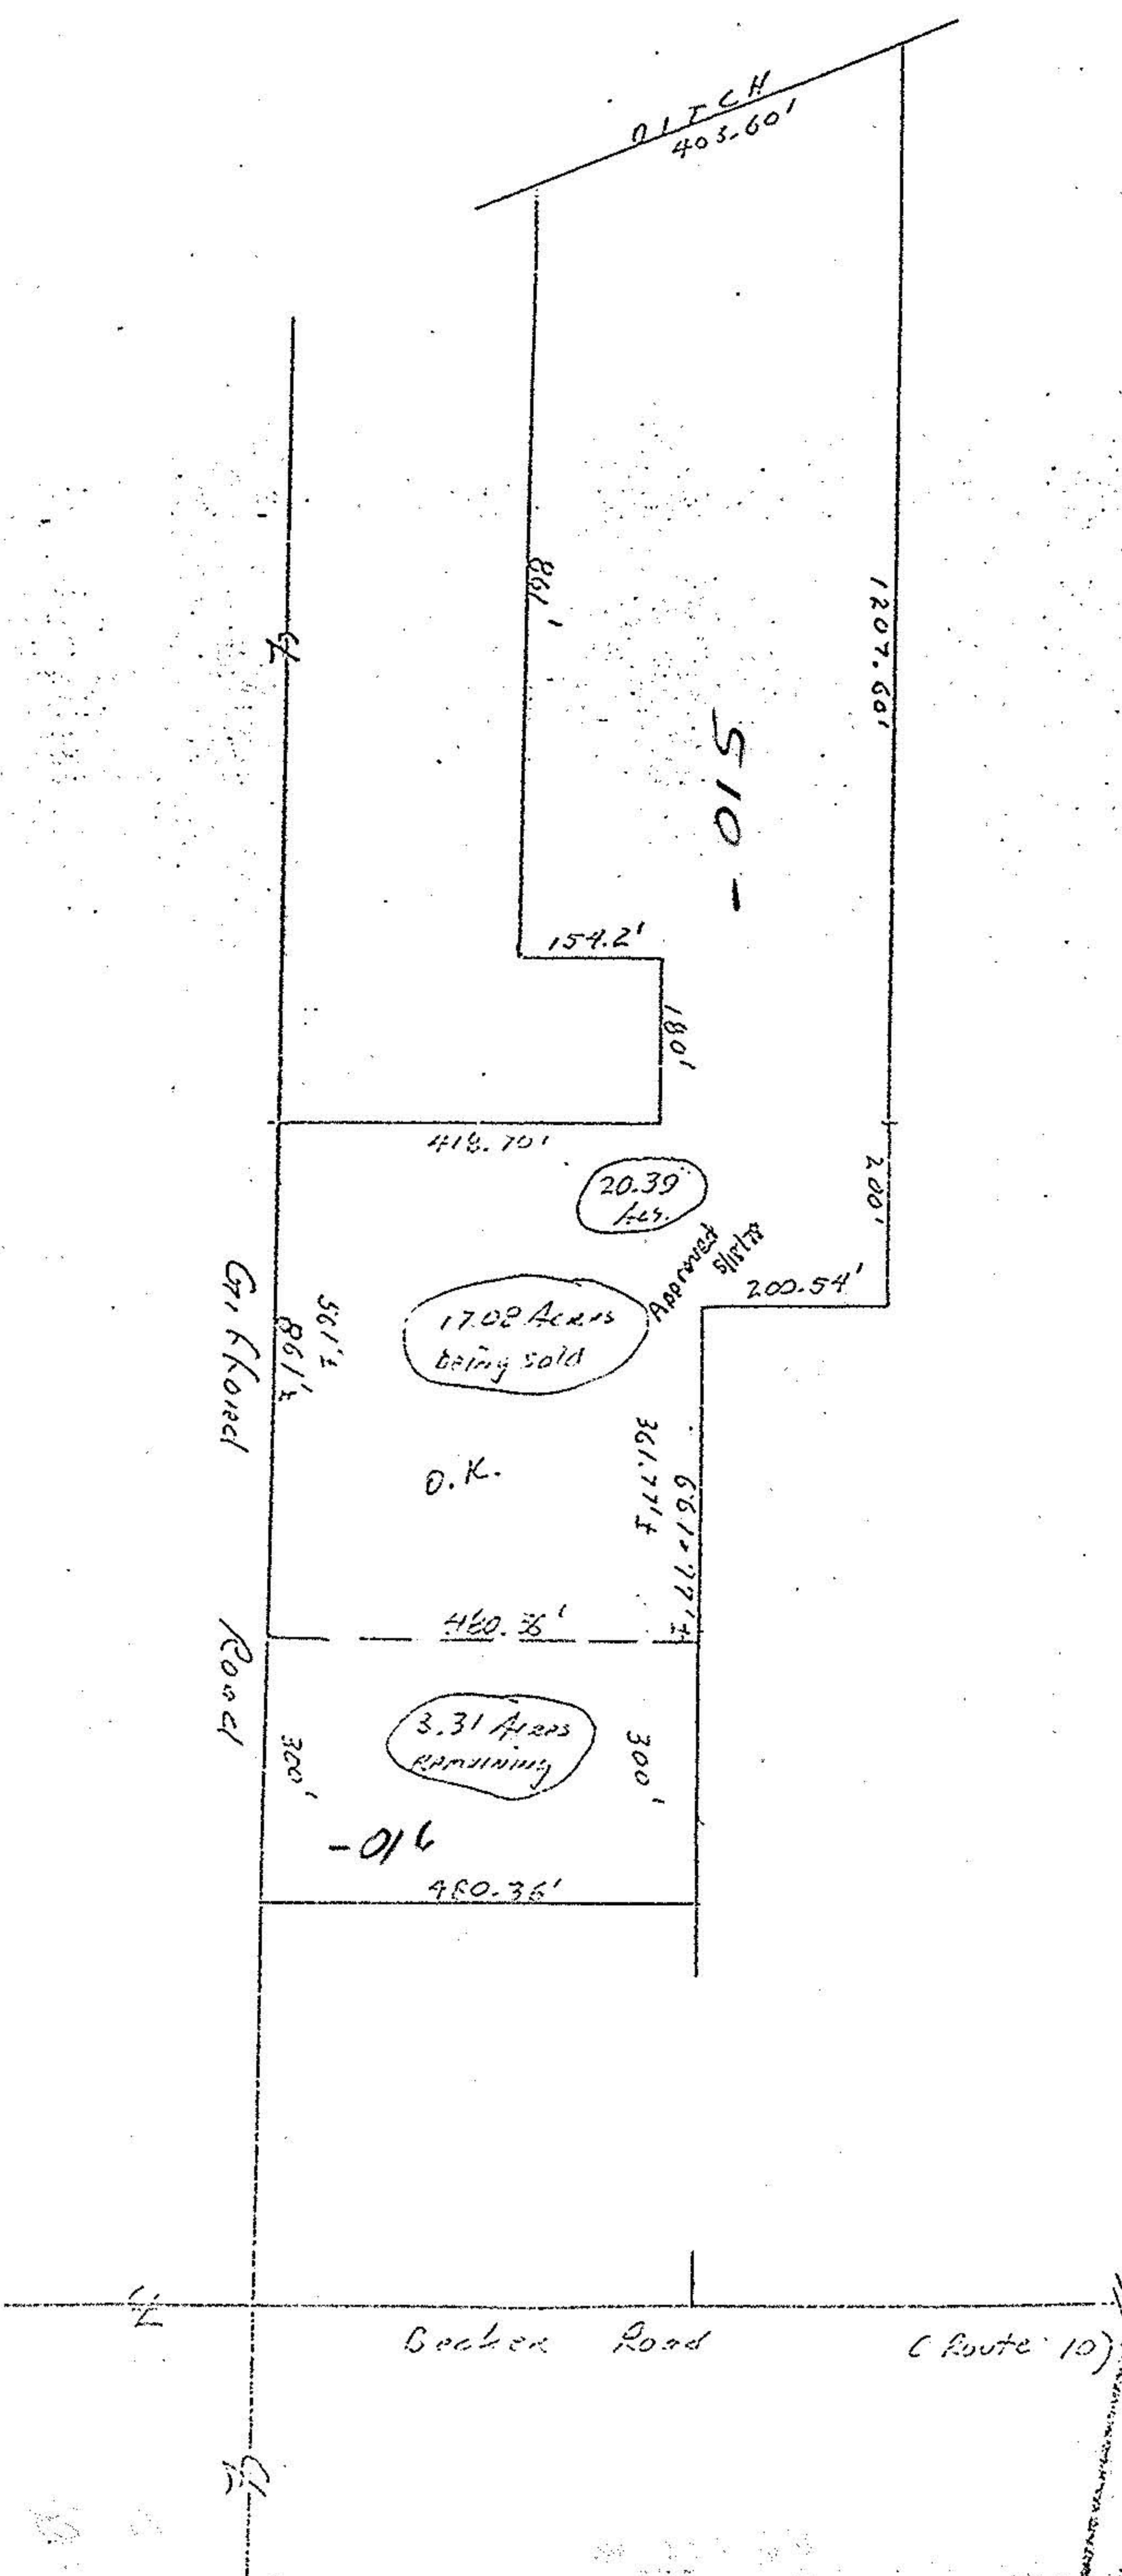

OL 3

2. H