


08-00-092-000

NORTH

8-00-092-B

J.R.L.

581.84
1.86 Ac ±

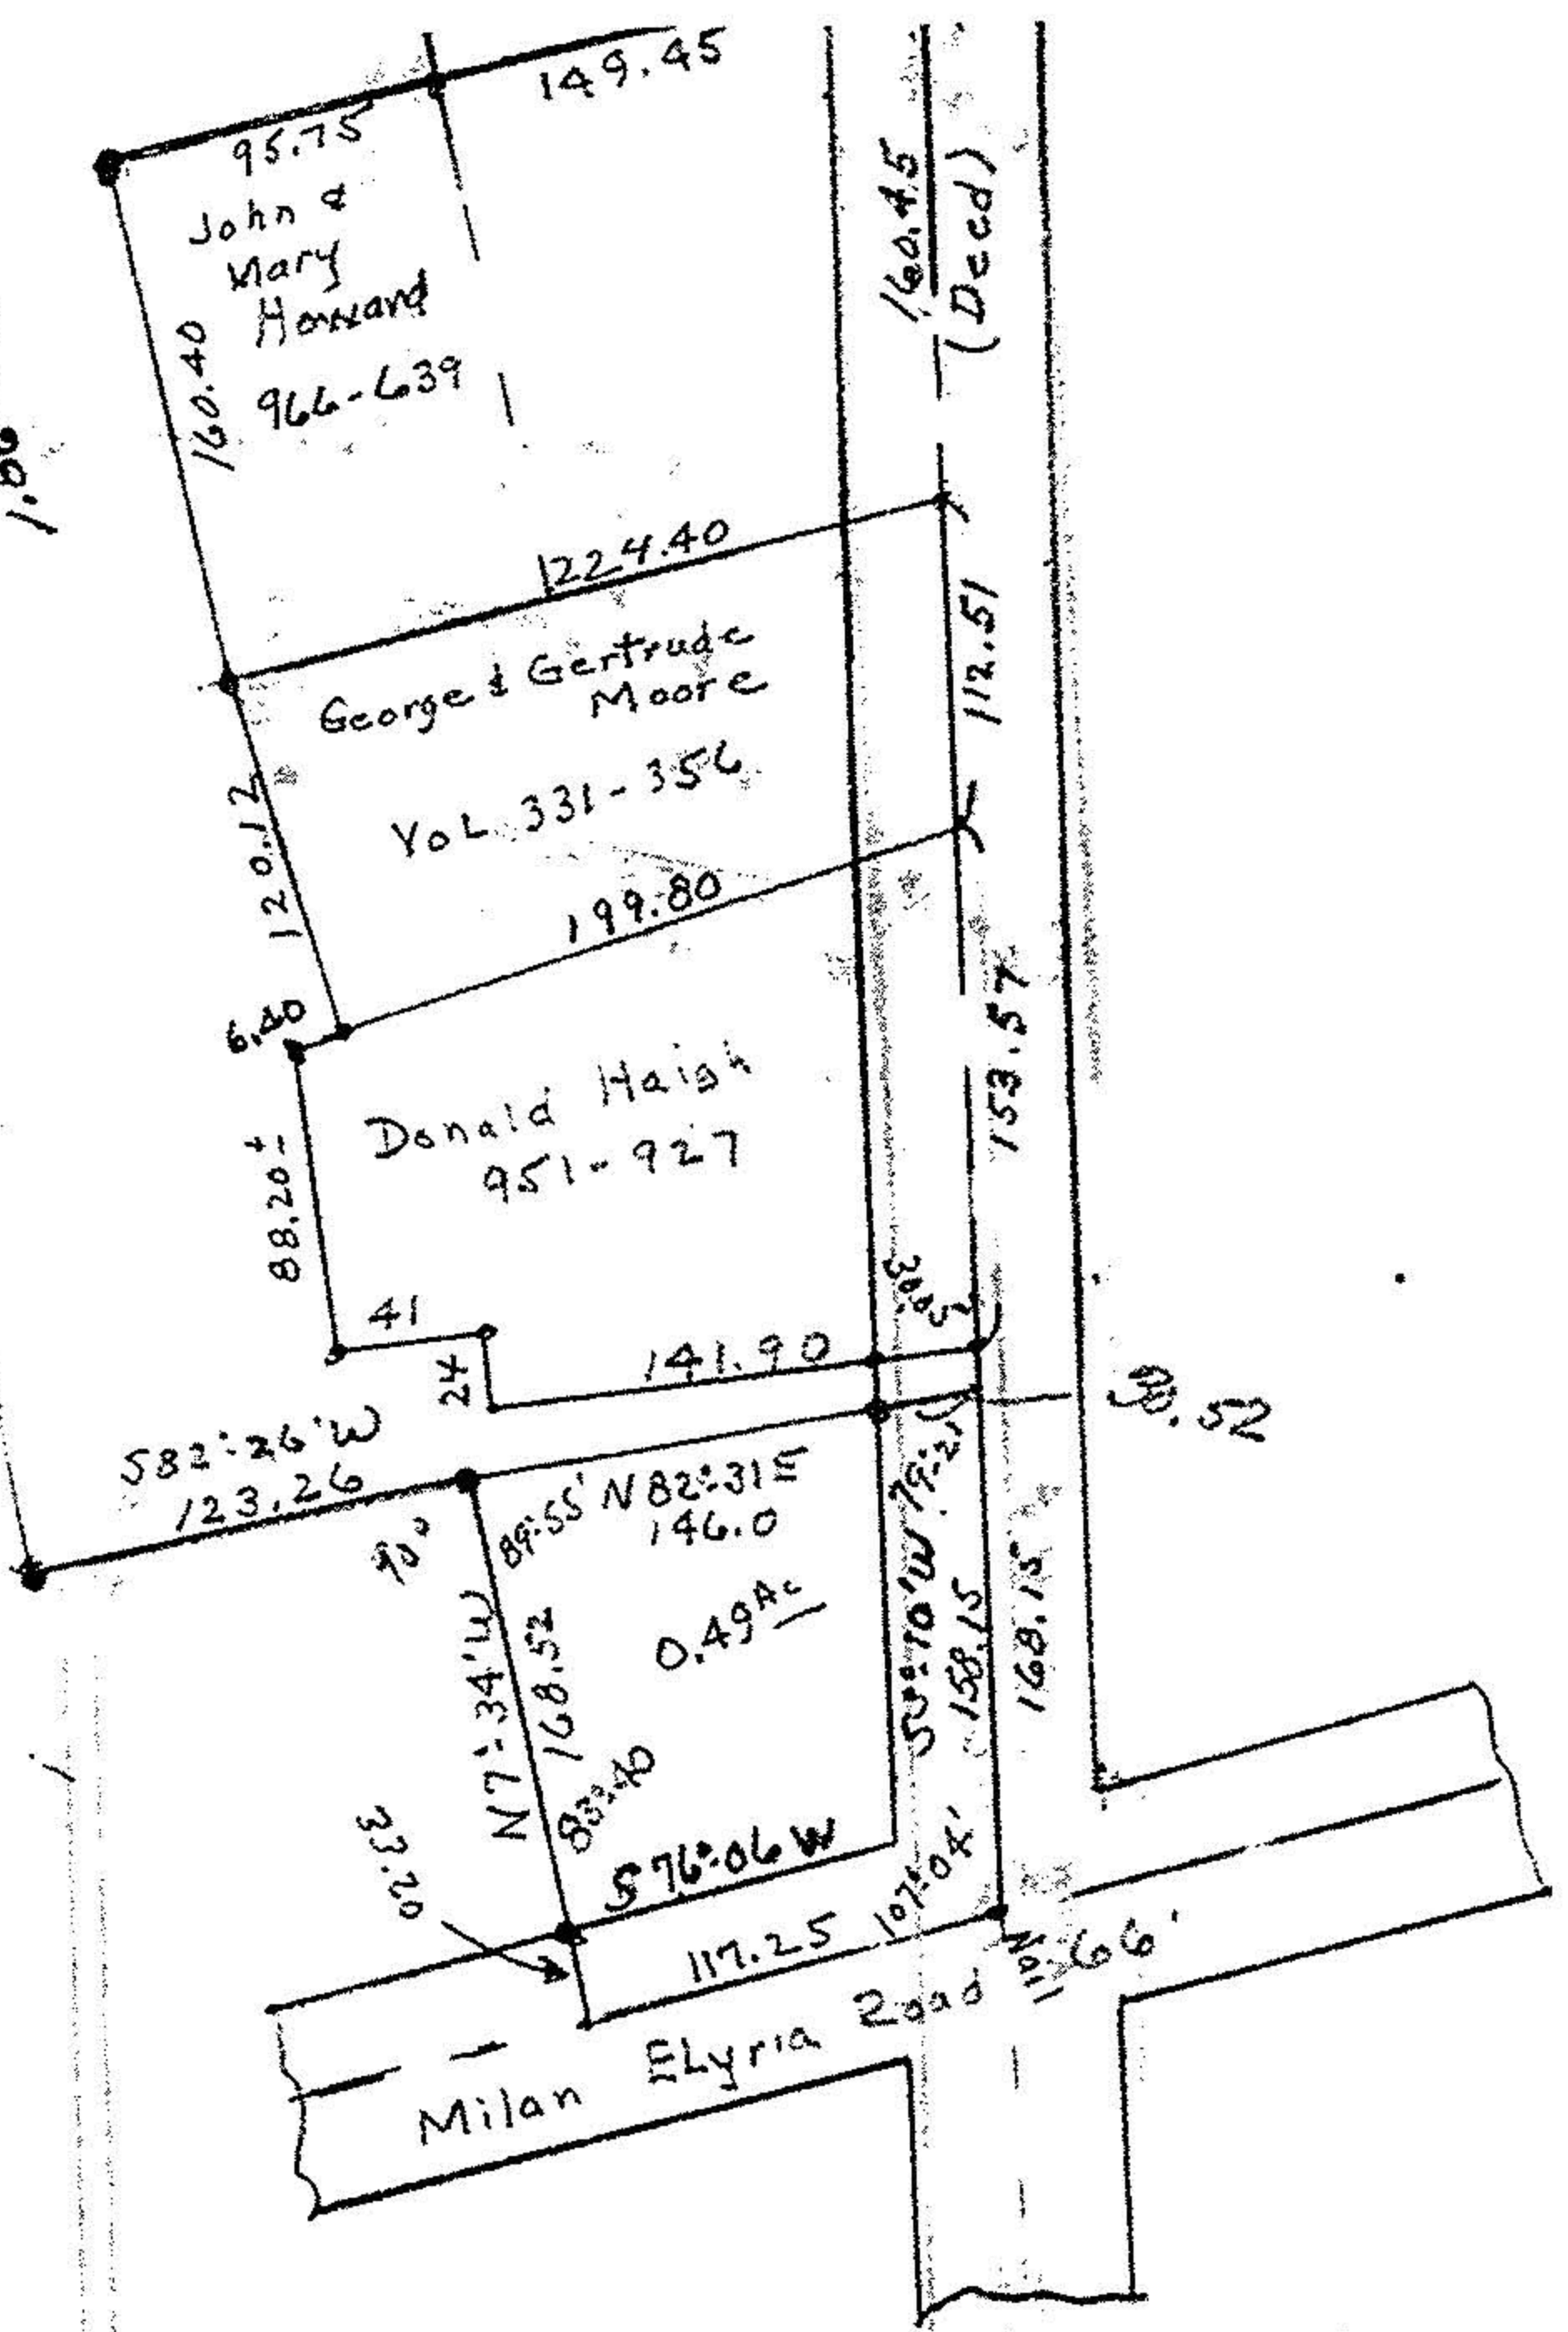

20248 A

APPROVED
LORAIN CO.
MAP DEPT.

DATE 4-28-93

PAGE 8-00-092-B

BY CAROLYN
FRANCIS


VOID
AFTER # 20248-A

CALL
WHEN
DONE →

CHARLES SMITH
965-8949

20248-A 08-00-092-101-

8-00-092-B

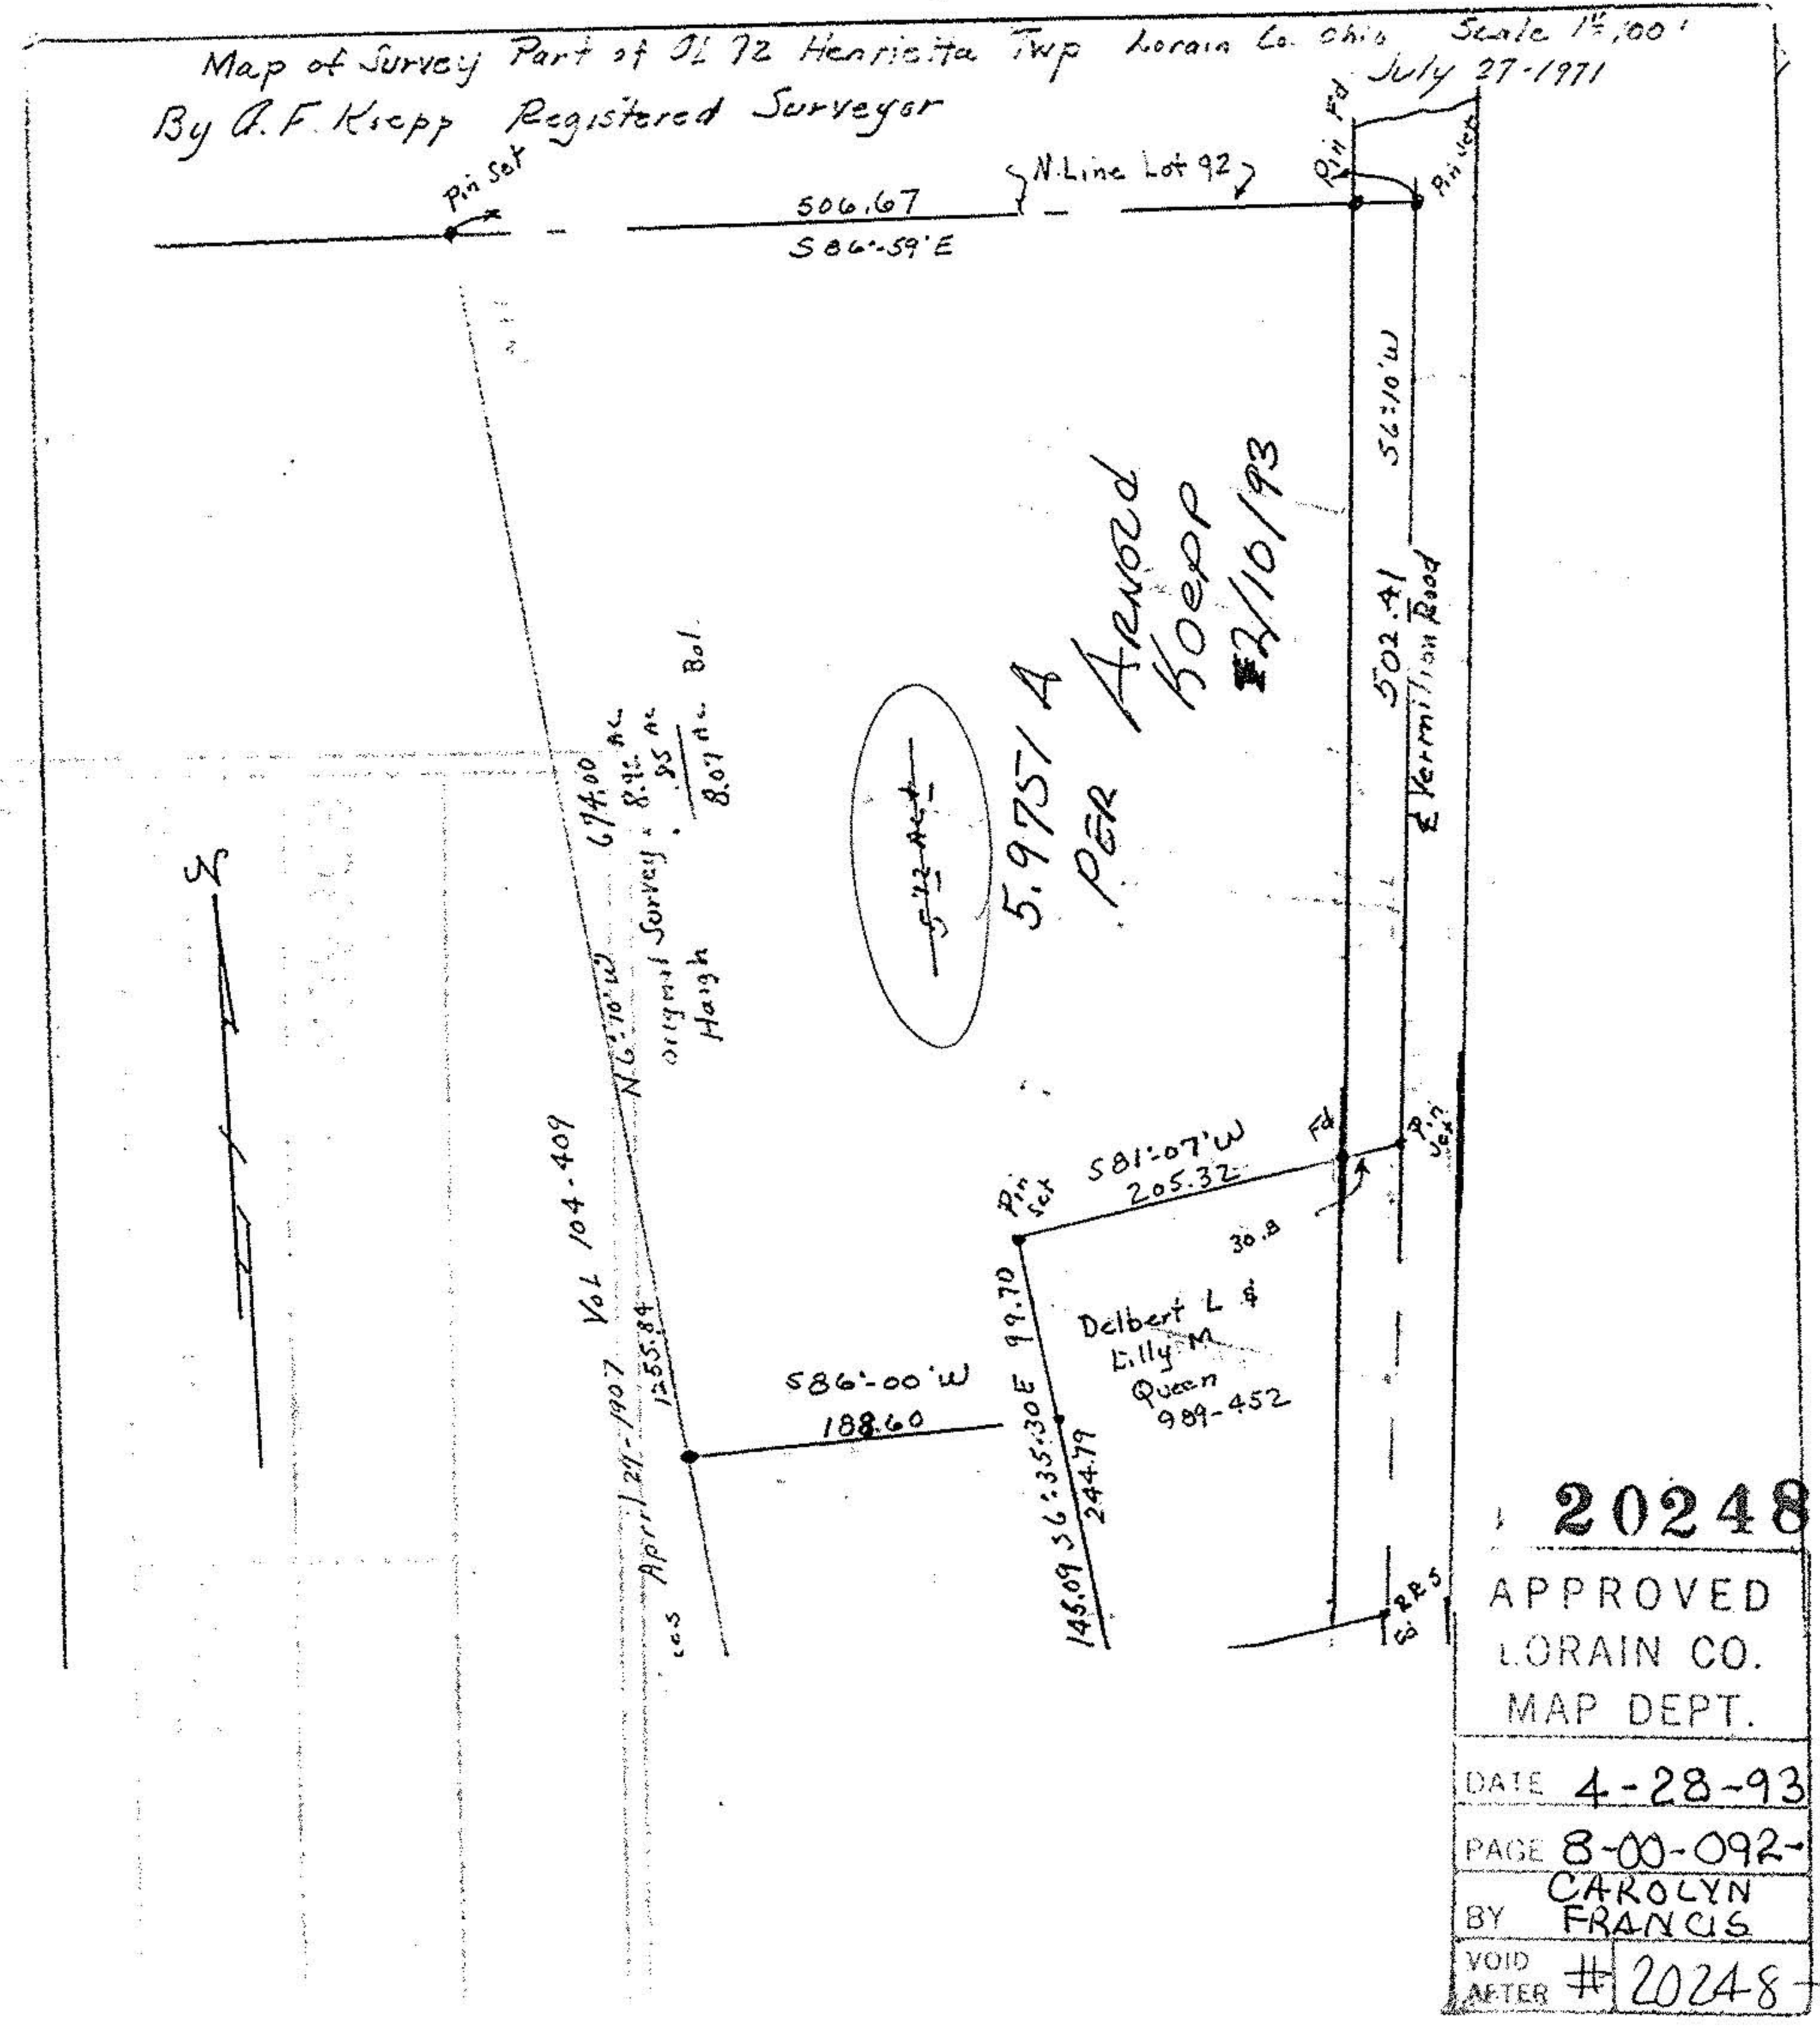

20248 A

APPROVED
LORAIN CO.
MAP DEPT.

DATE 4-28-93

PAGE 8-00-092-B

BY CAROLYN
FRANCIS

VOID
AFTER # 20248-A