


Map of Part of Lot 2 Russia Twp. Lorain Co. Ohio
 Scale 1" = 100'
 April 8, 1986
 By Arnold F. Koepf Reg. Surveyor No. 4306

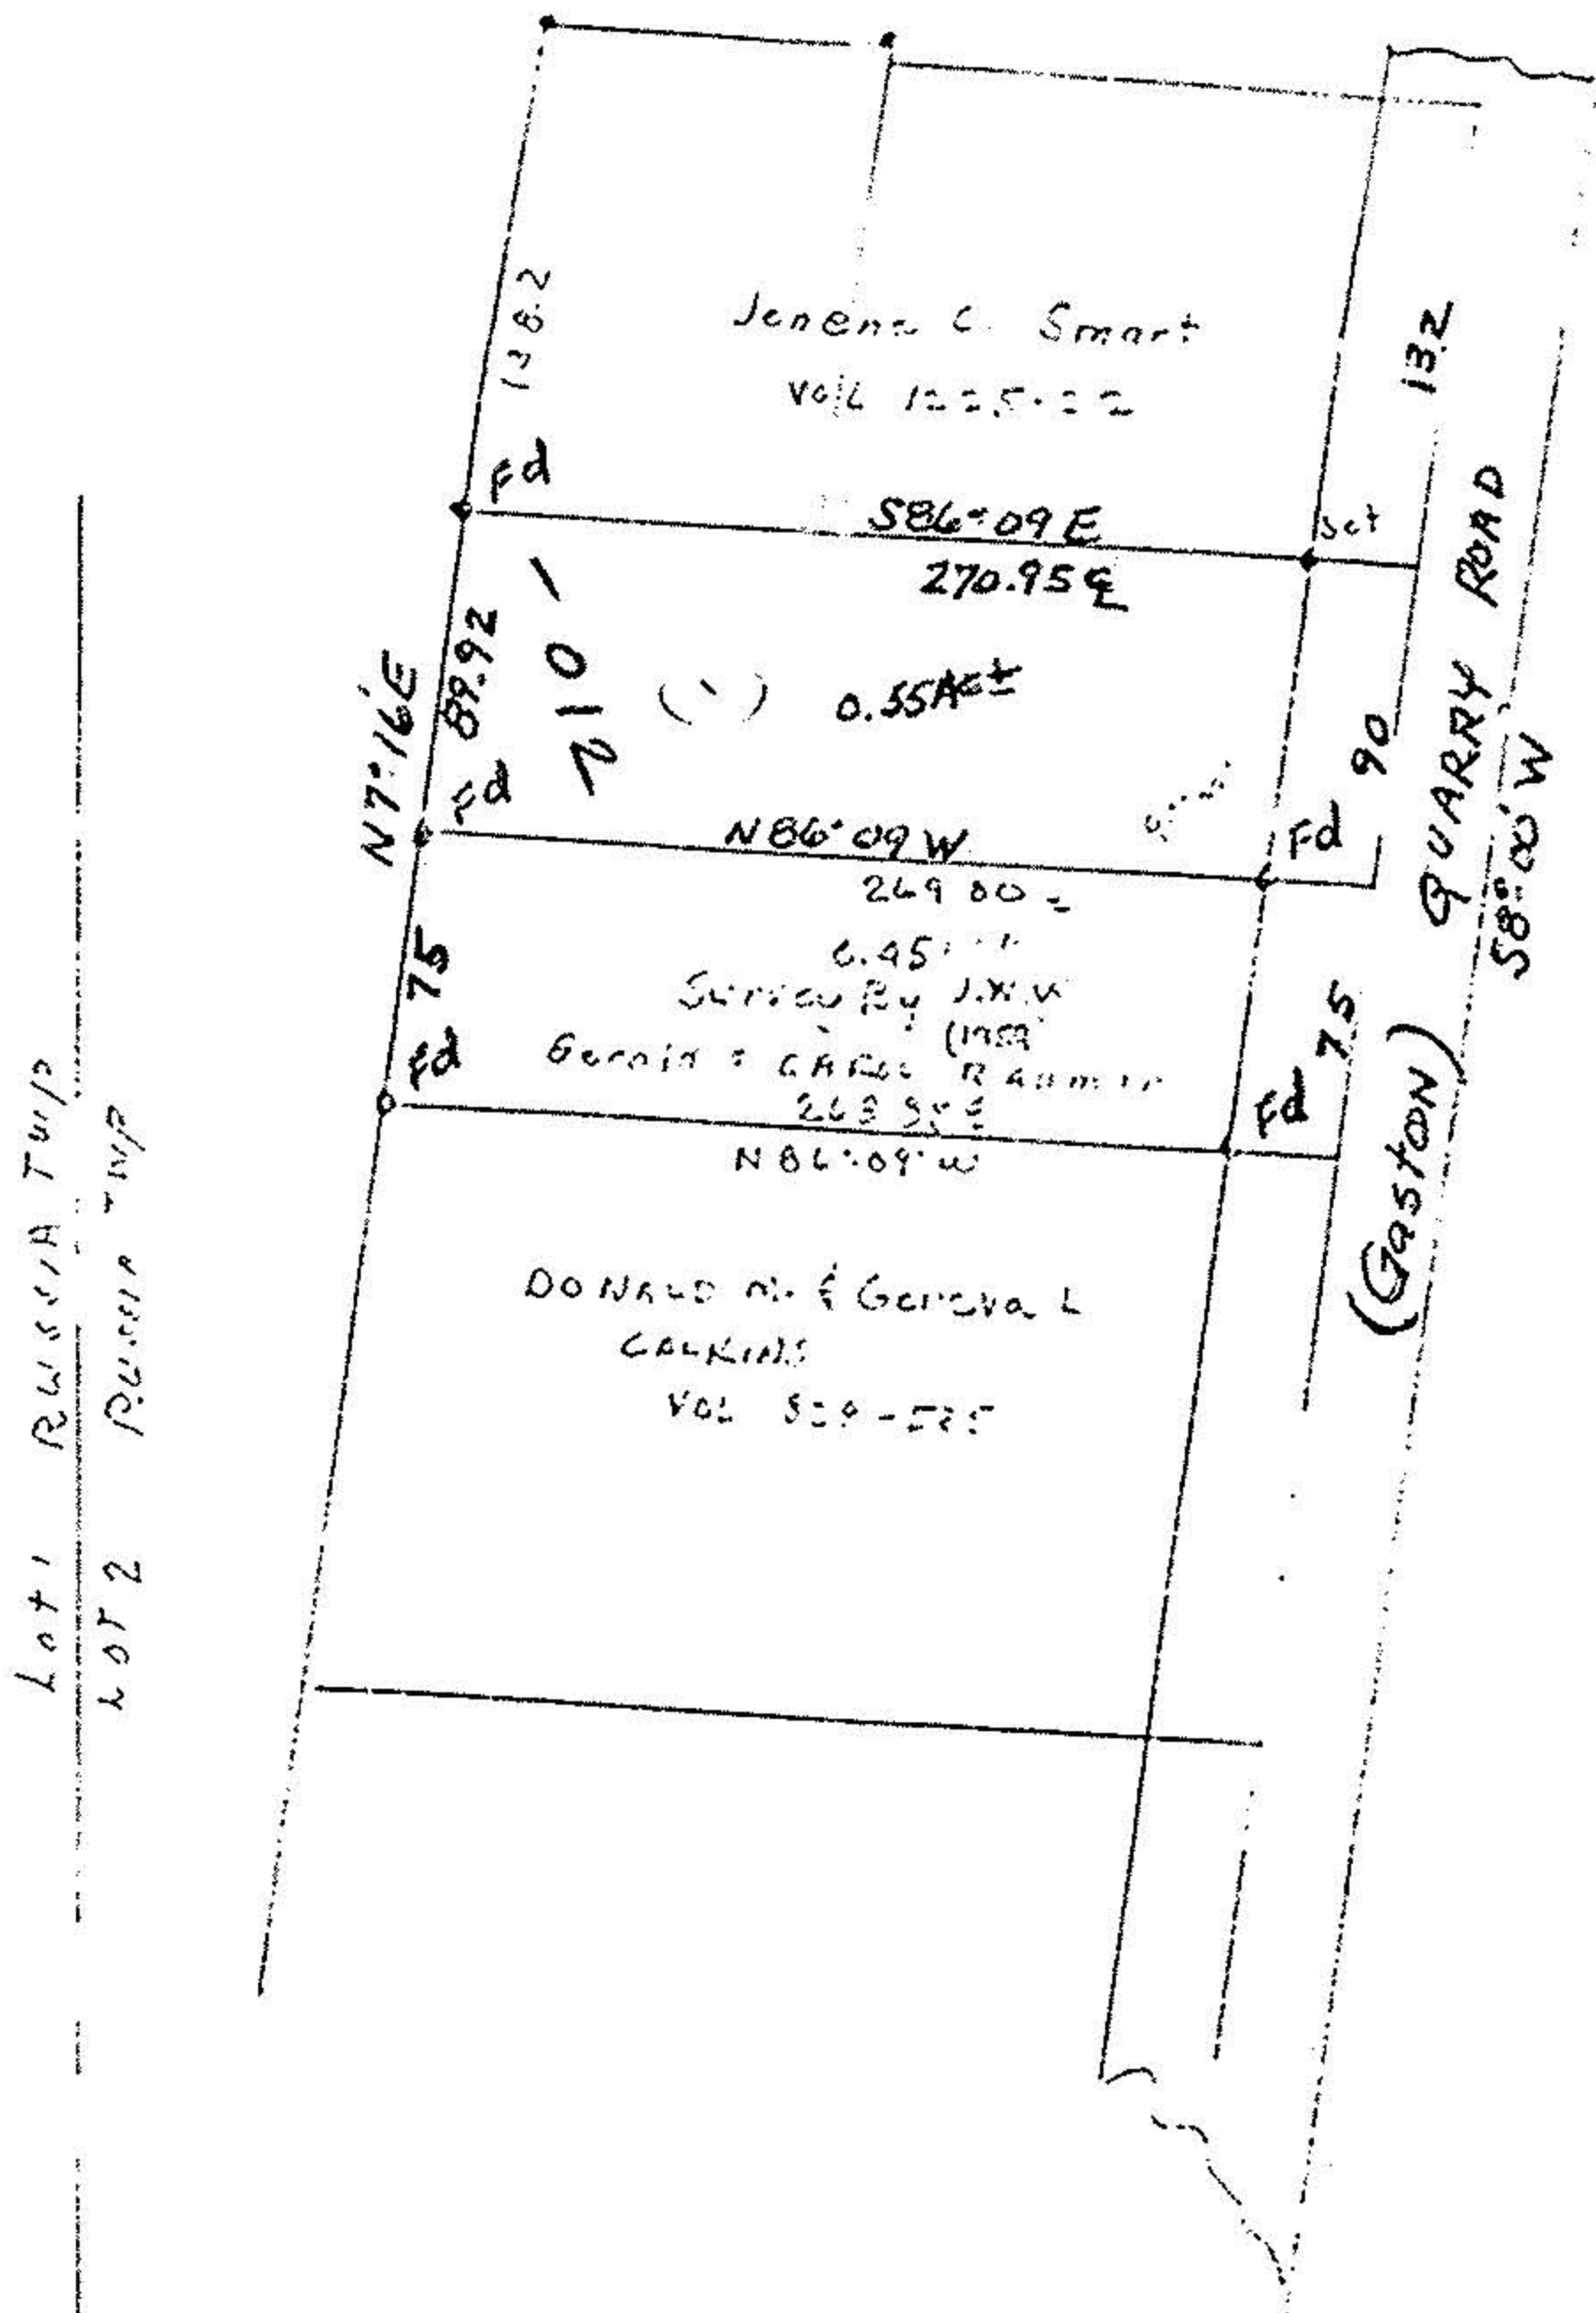

Lot 1 Russia Twp
 Lot 2 Russia Twp

9-00-002-A

09-00-002-000

#16793

APPROVED	
LORAIN CO.	
MAP DEPT.	
DATE	6-17-86
PAGE	9-00-002 A
BY	T. McMain
VOID AFTER	