

KLEINOEDER-SCHMIDT
and ASSOCIATES

ENGINEERS — SURVEYORS — CONSULTANTS IN LAND PLANNING
ELYRIA · NORWALK · MEDINA


OHIO

PLOT PLAN

JOB NO. 76-282

10-013

SUBLOT _____
SUBDIVISION _____
OTHER PART OF RUSSIA TWP. ORIG. LOT NO. 43 - LORAIN COUNTY - OHIO

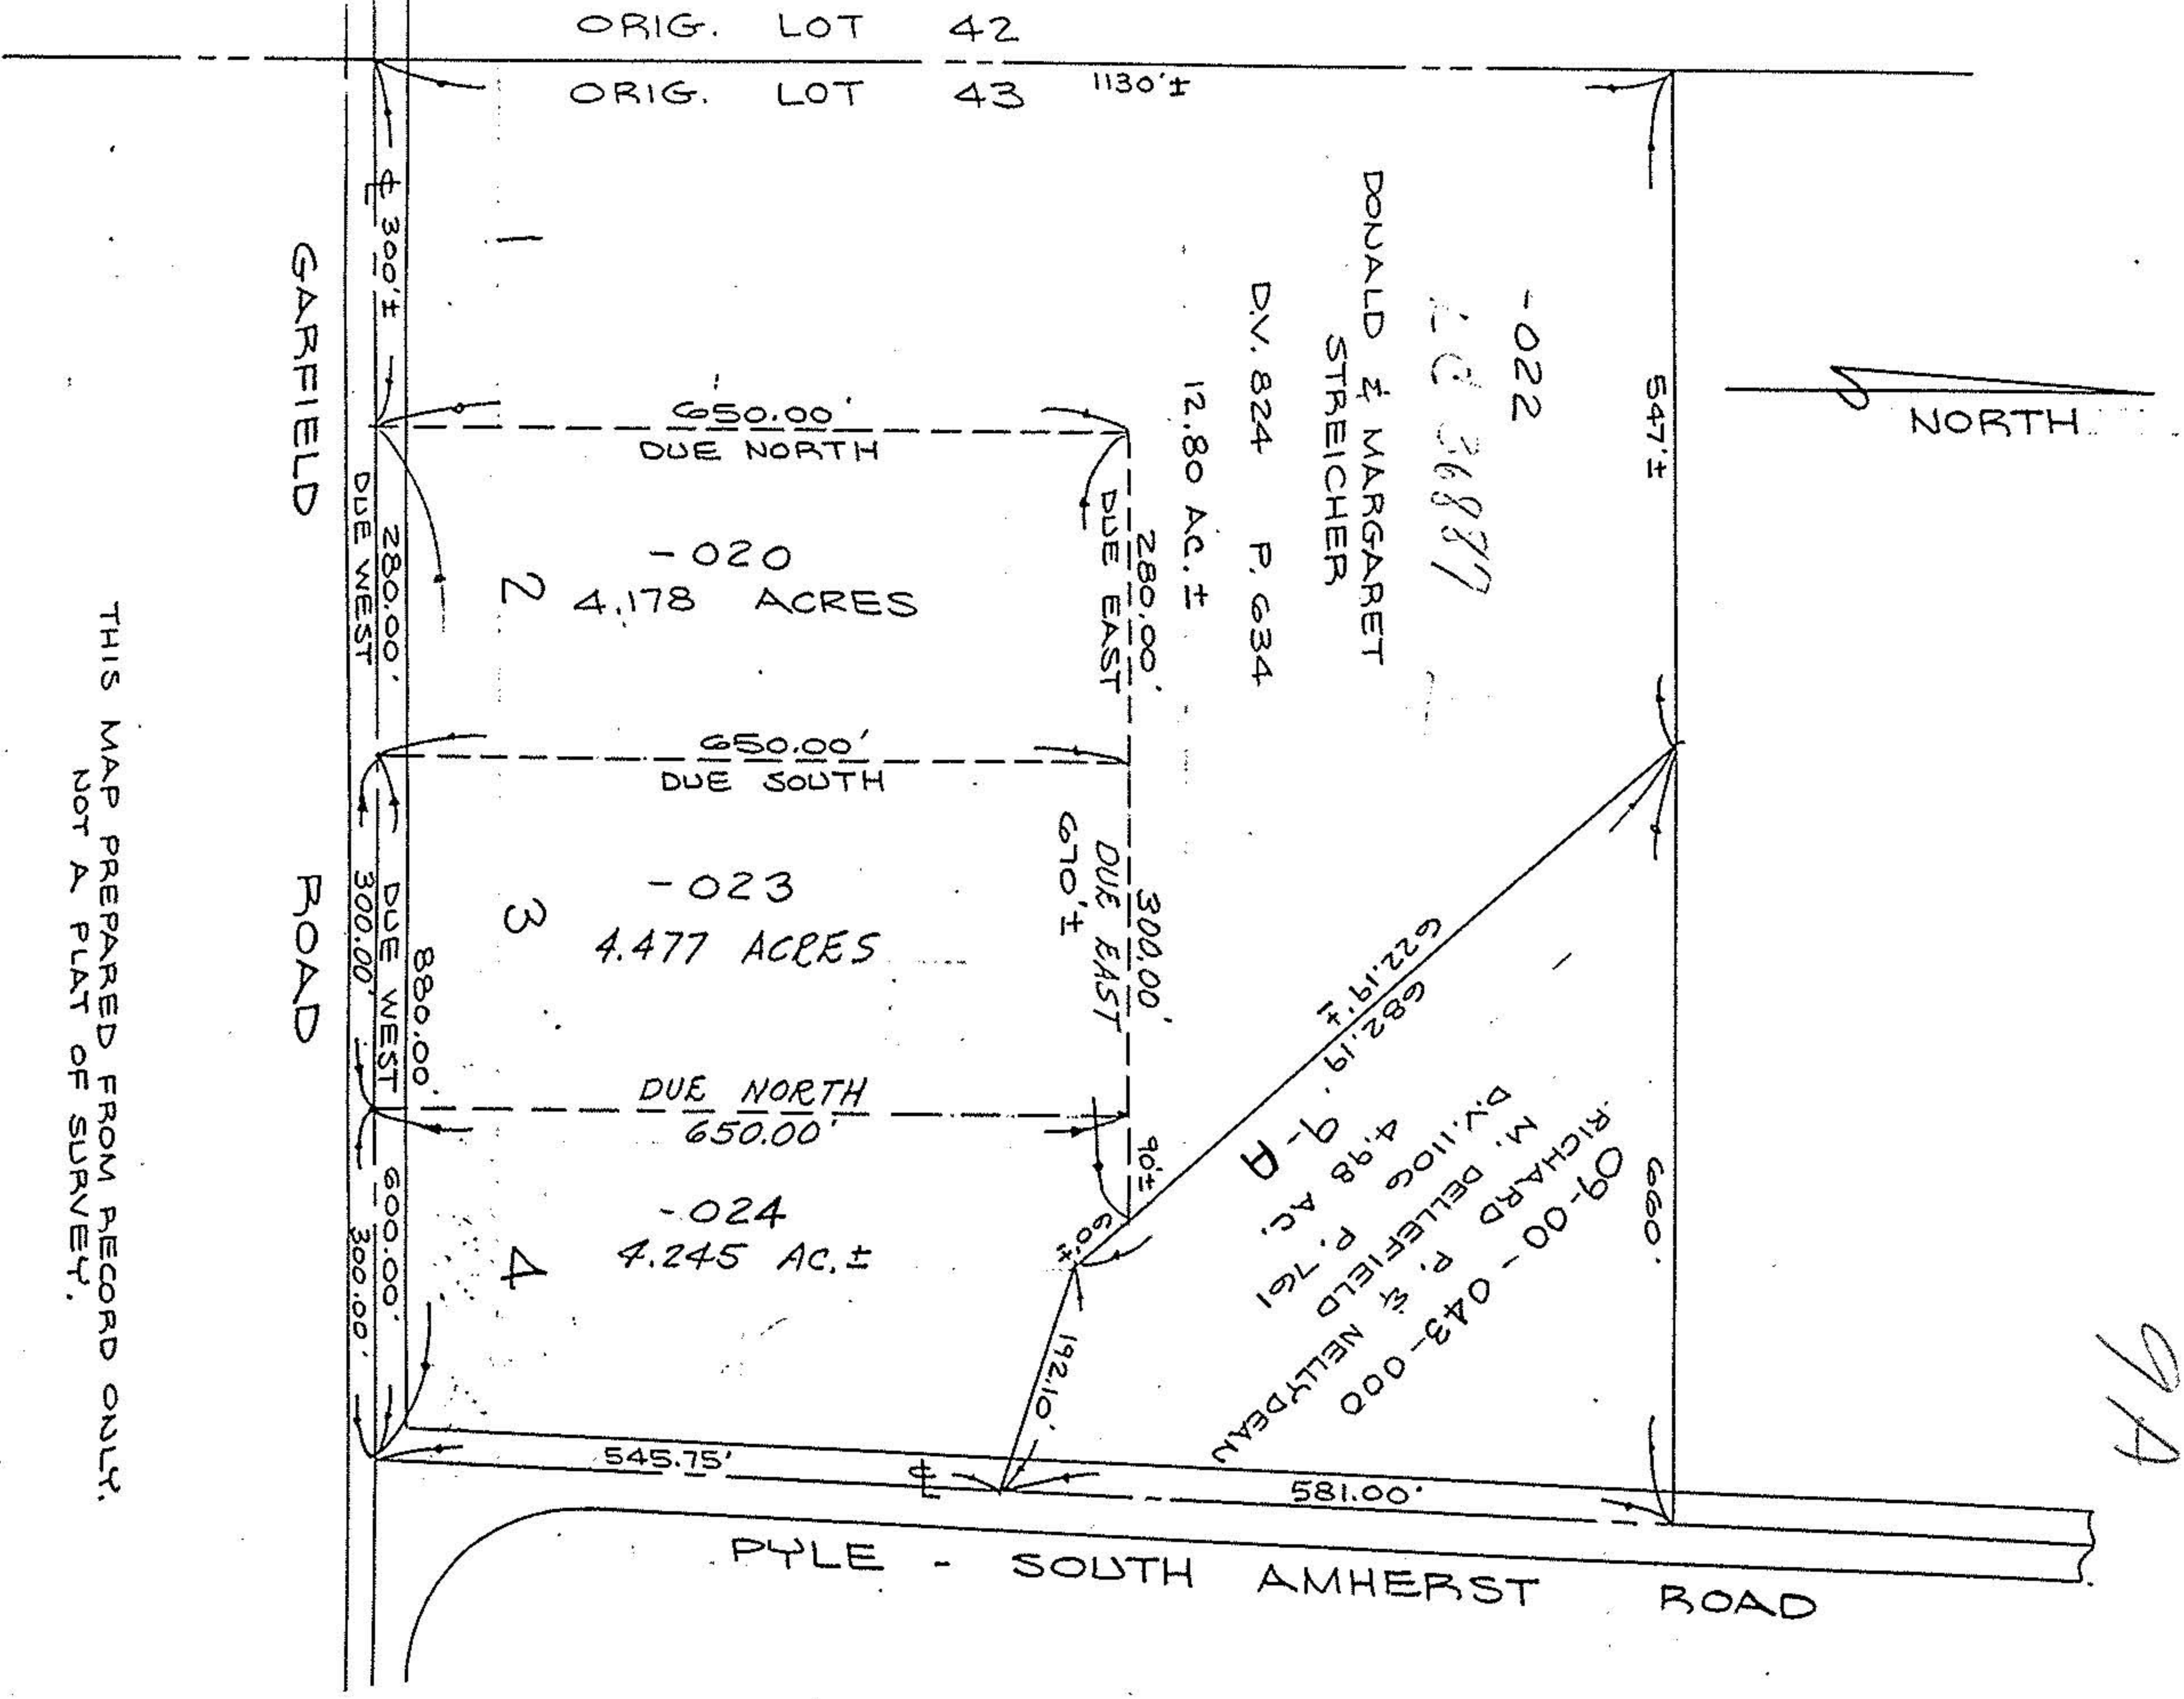

THIS MAP PREPARED FROM RECORD ONLY.
NOT A PLAT OF SURVEY.

ORIG. LOT 42
ORIG. LOT 43

DONALD & MARGARET
STREICHER
D.V. 824 P. 634

99-00-043-000
RICHARD M. BELLEFIELD
D.V. 1106 P. 761
4.98 AC.
9-P
682.19'
622.19'

Prepared for: ELMER COOK,
4630 TELEGRAPH RD.,
AMHERST, OHIO
Date: SEPT. 27, 1976 REV. 9-28-76 REV. 10-5-76