



Survey of a Parcel Split
 for
 Edith Knipper
 Part of Original Lot 58
 Russia Township
 Lorain County OH
 scale 1" = 100' March 1993

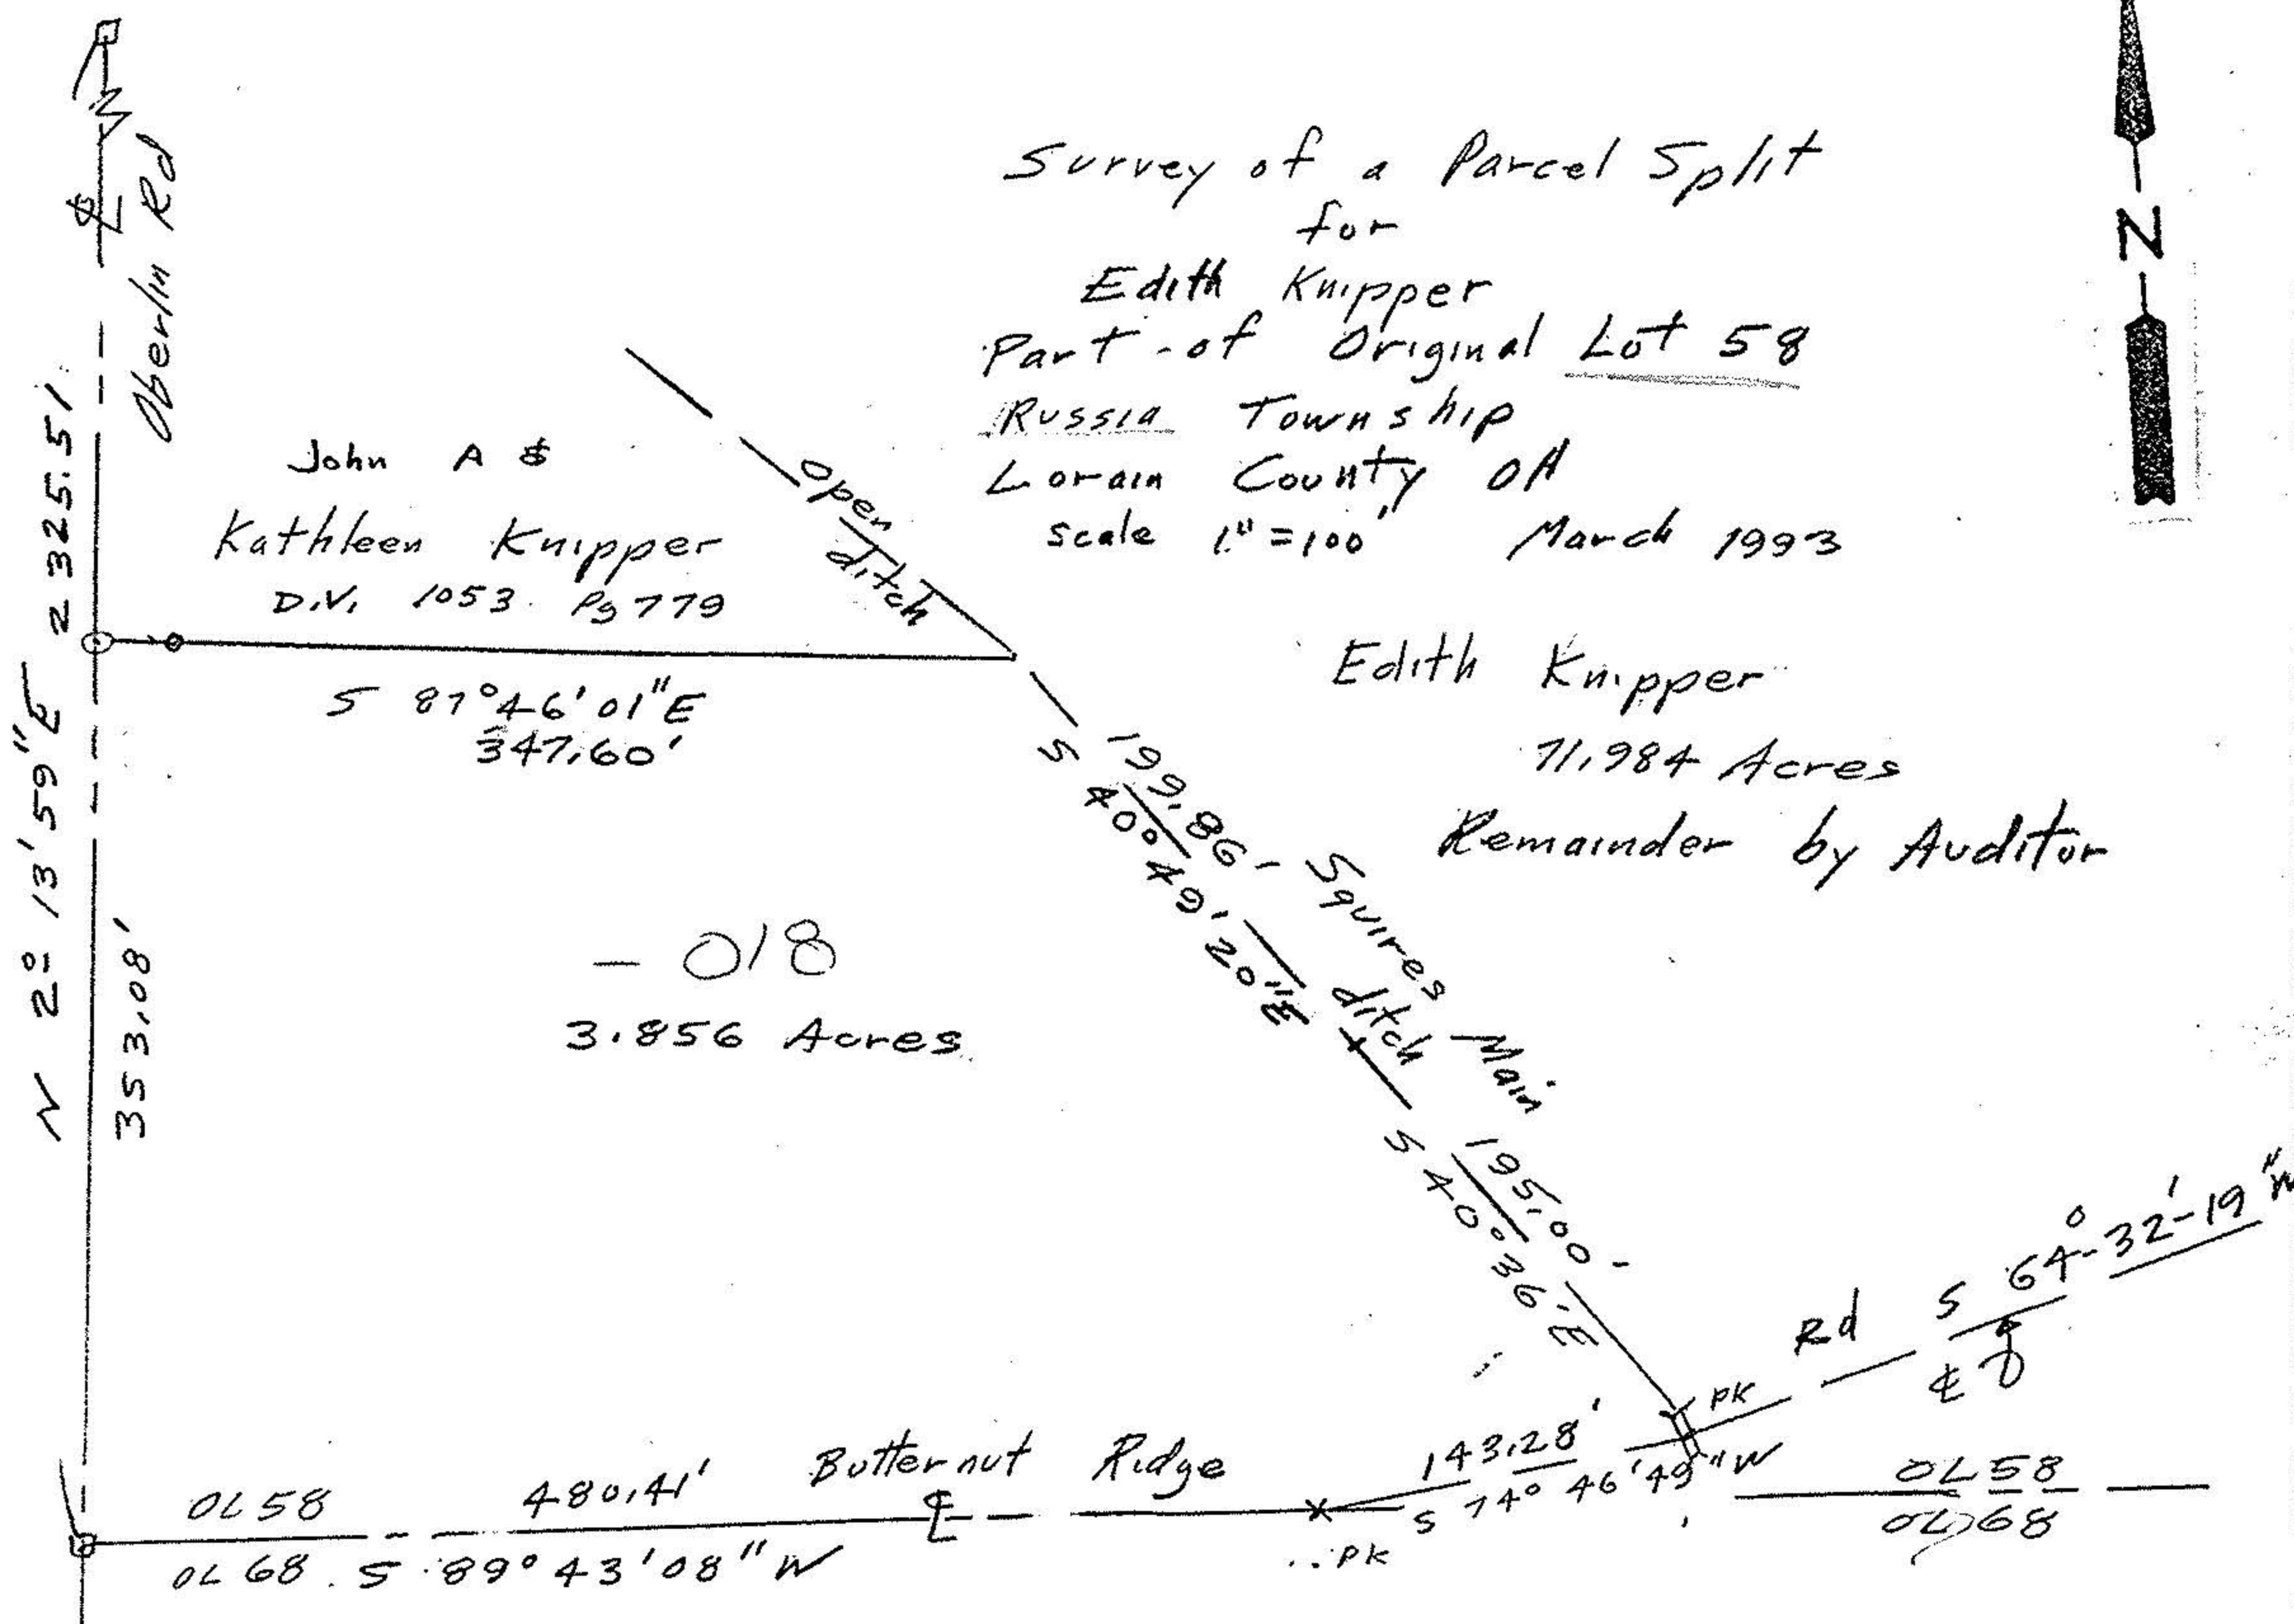

Monument Boxes

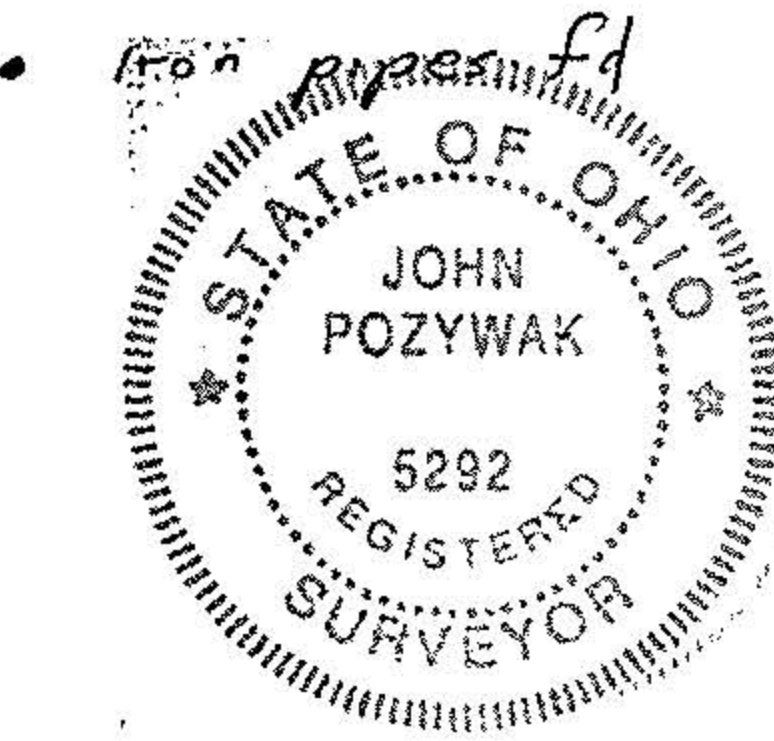

See Rd Record & Dedication Plat
 for & Butternut Ridge Rd
 John Pozywak
 Reg Surveyor
 5292