

19987

APPROVED
LORAIN CO.
MAP DEPT.

DATE 7-6-92

PAGE 9-00-065-B


CAROLYN
BY FRANCIS

VOID
DATE # 19987

NORTH

ASSUMED
MERIDIAN

SCALE
1" = 100'

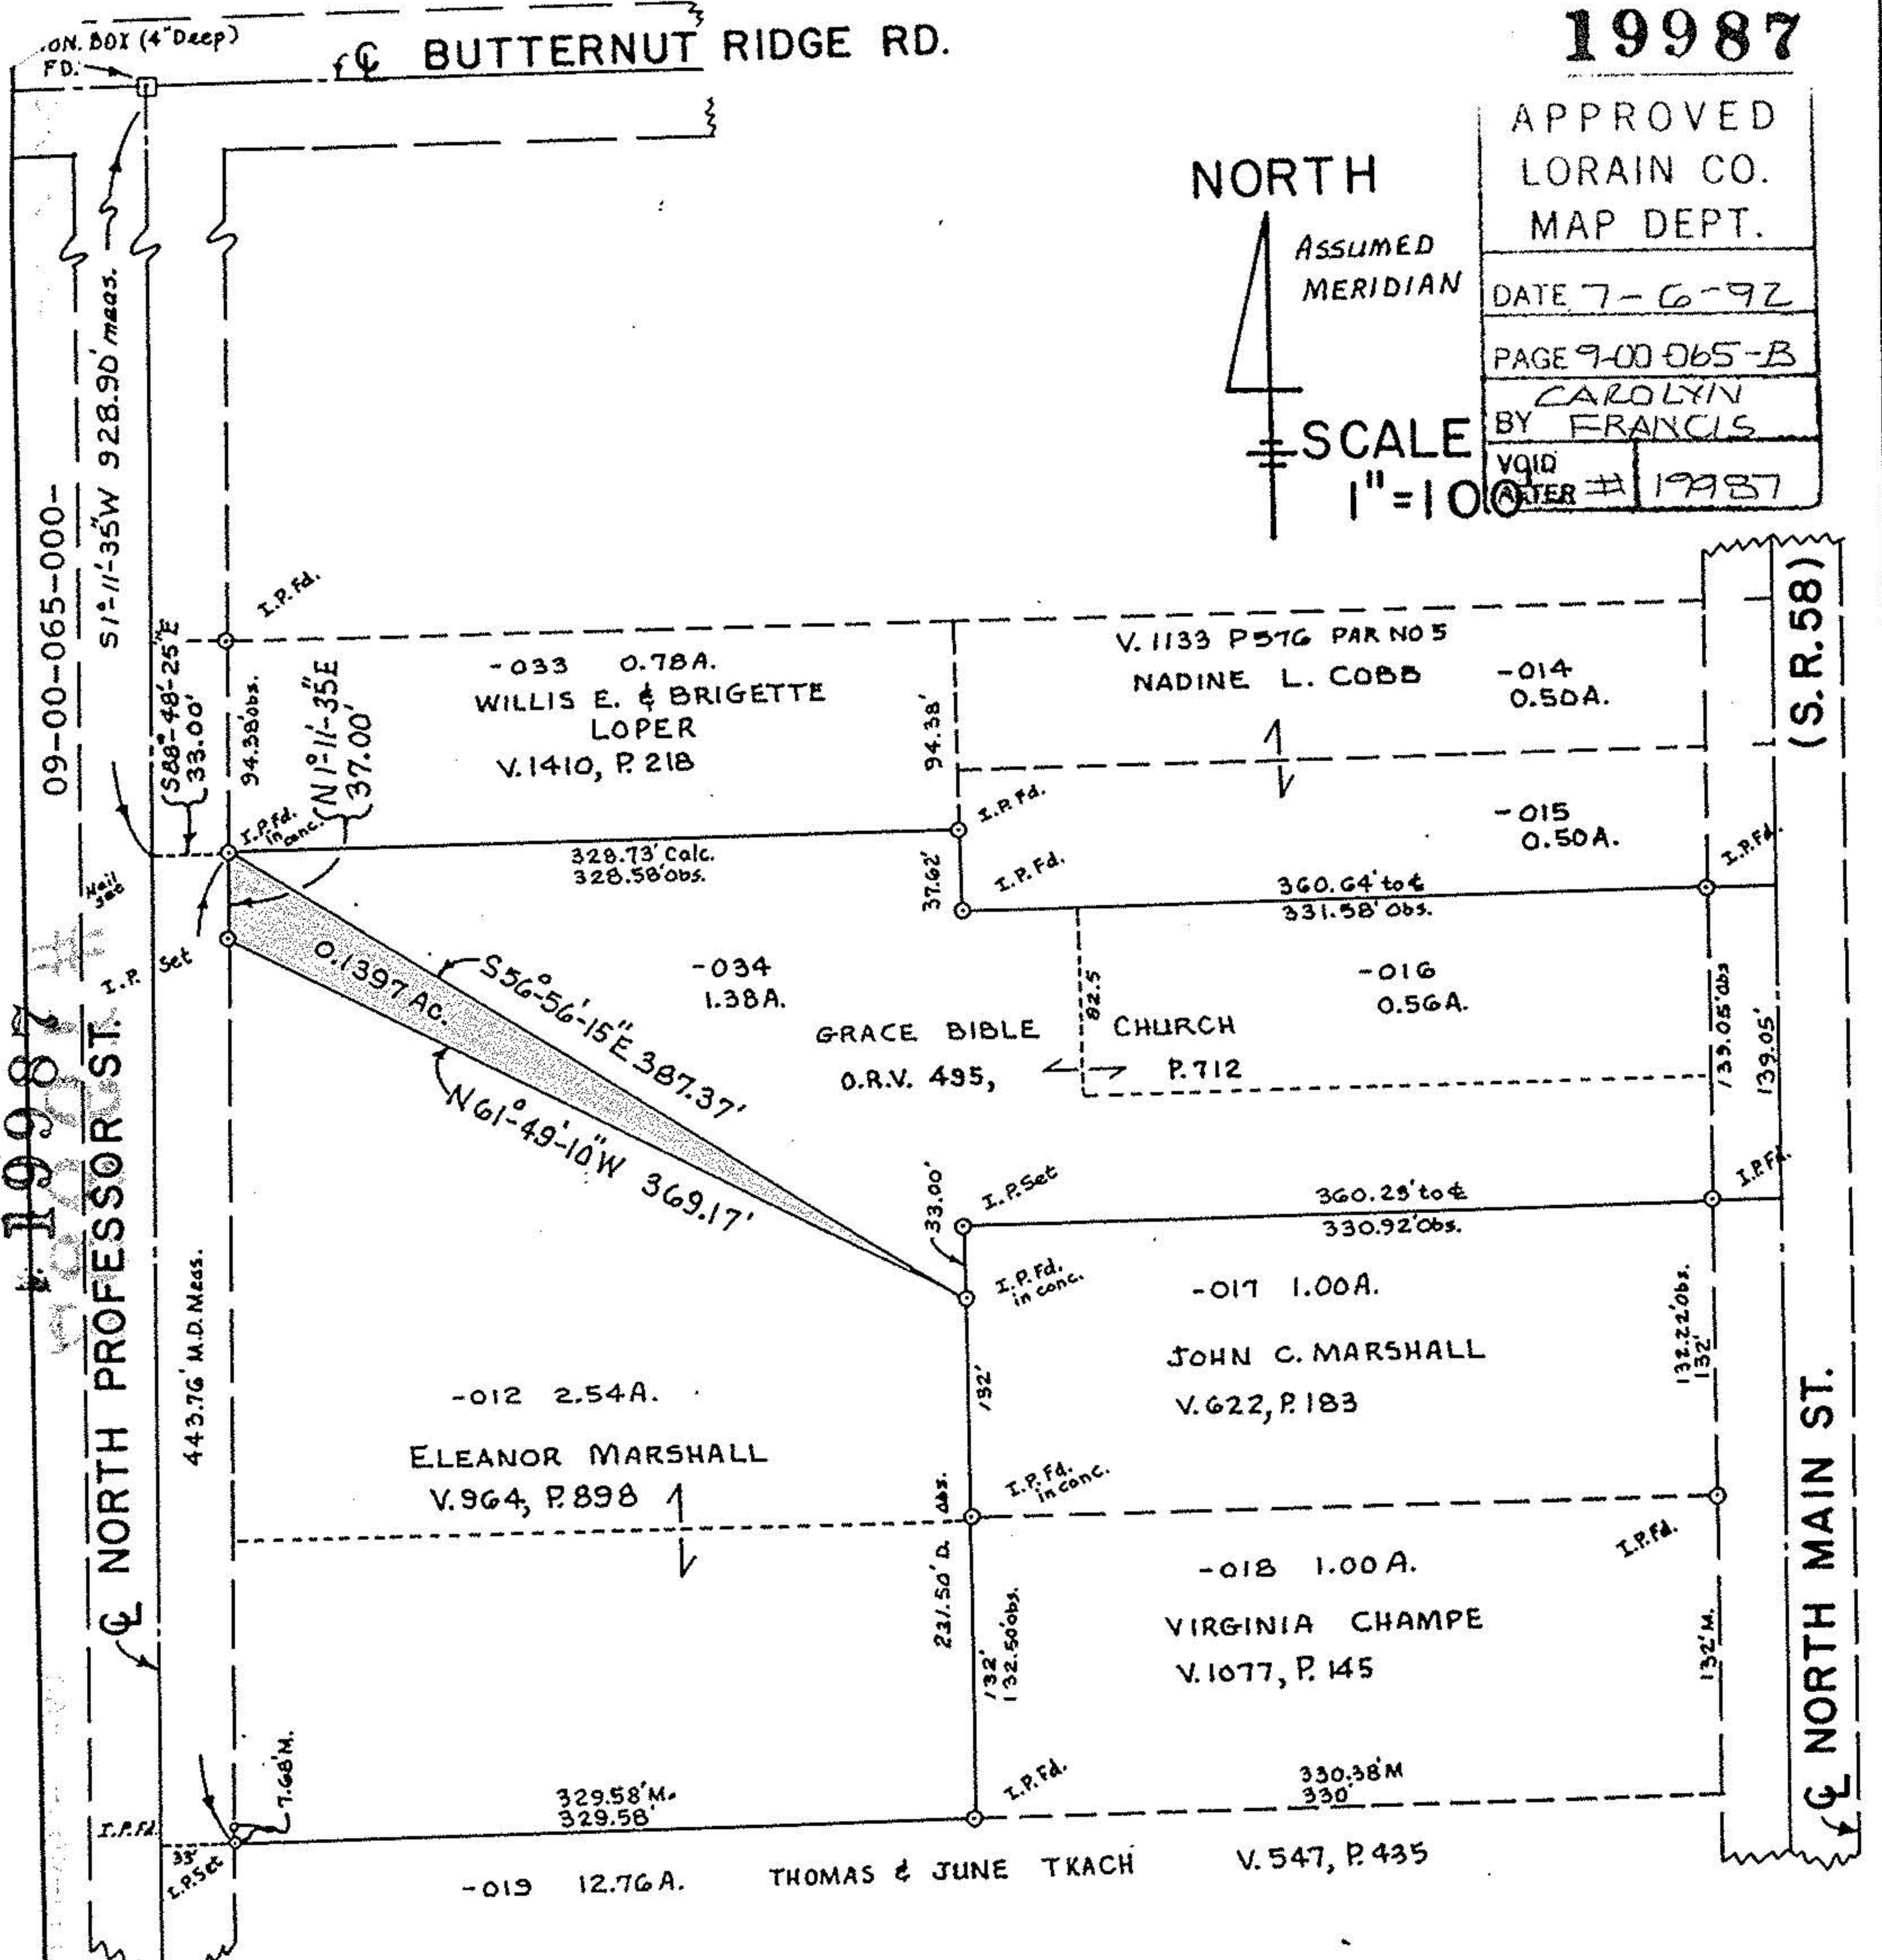

19987

09-00-065-000-

9-00-065-B

(S.R.58)

MAP OF SURVEY MADE OF 0.1397 ACRES
 PART OF ORIG. RUSSIA TWP. LOT NO. 65
 RUSSIA TWP., LORAIN CO., OHIO
 Made at request of GRACE BIBLE CHURCH
 By Charles P. Waryu, Reg. Surveyor No. 5029
 April, 1992

Charles P. Waryu
 CHARLES P. WARYU, REG. SURVEYOR NO. 5029