



LAUNDON . SIMON . CAHL & ASSOC. INC.
CONSULTING ENGINEERS & SURVEYORS
219 COURT ST. ELYRIA, OHIO 44035

SURVEY FOR:

OBERLIN COLLEGE

Orig. Lot 75	City of OBERLIN	Date AUG. '91 Scale 1"=50'
Orig. Sec	Village of	Dwn. by R.G.S Chkd. by R.C.
Tract	County of LORAIN	Job No. 91-2086 F.B. 221/46
Township of RUSSIA	State of OHIO	Printed JAN 23 1992


BEARINGS SHOWN ARE ASSUMED
AND USED TO DESCRIBE ANGLES
ONLY.

19709

APPROVED
LORAIN CO.
MAP DEPT.
DATE 12-16-92
PAGE 9-00-075-B
BY CAROLYN FRANCIS
VOID AFTER # 19709

I.P. Mon. @ Walnut St. Used

OBERLIN COLLEGE

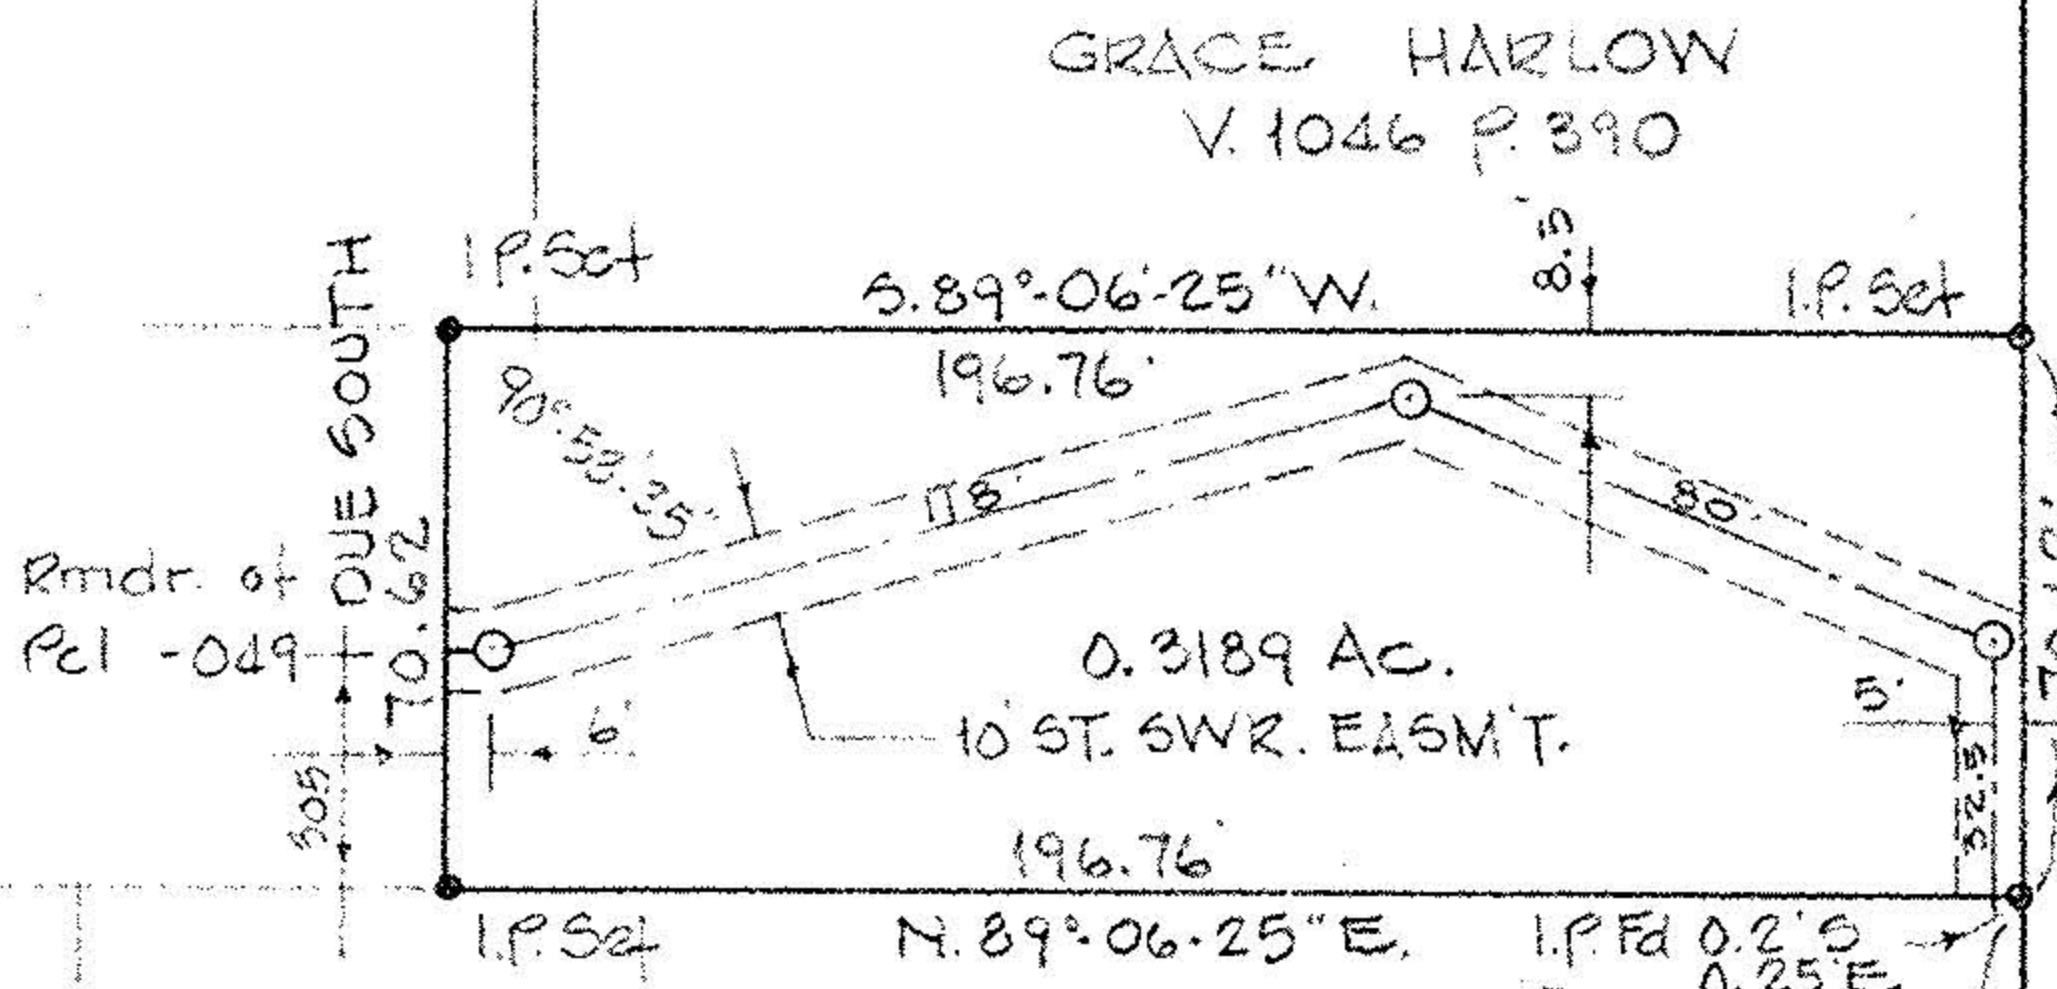


GRACE HARLOW
V. 1046 P. 390

FIRST CHURCH
IN OBERLIN
V. 381 P. 23
V. 890 P. 408

NORTH MAIN ST. 66'

WEST LORAIN ST. 66'

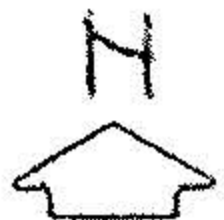

Cross Fd. Used

09-00-075-110

19709

9-00-075-B