

O.L. 62
 1.P. in Mon. Box O.L. 72

NOTE: ● indicates iron pin set on this or previous surveys unless designated railroad spike

SURVEYING FOR THE ESTATE
 OF ROBERT F. SEDELKE
 by PAUL M. SQUIRES, EXECUTOR
 Parts of Parcel No. 2
 Deed Vol. 433 Pg. 493
 ORIG. LOT No. 72 - RUSSIA TWP,
 LORAIN COUNTY - OHIO
 SCALE: 1" = 100'
 Gary E. Penfound
 Reg. Surveyor No. 4457

Robert Sedelke Parcel No. 4 D. Vol. 433 Pg. 493
 Due West 1373.89'
 Due West 933.89'


16.4629 ACRES
 to Robert C. & Mary E. Born

#19406A

APPROVED
LORAIN CO.
MAP DEPT.
DATE 6-21-91
PAGE 9-E
BY CAROLYN FRANCES
VOID AFTER #19406A

30.01' ±
 291' ±
 N. 1° 16' 05" E,
 3.8809 ACRES Surveyed March - 1991
 3.8809 ACRES Surveyed October - 1989
 N. 1° 16' 05" E,
 190.28' ±
 30.01' ±
 296.6' ±
 768.60'
 768.60'
 293.31'
 Line about 6' East of Existing Fence
 7.2417 ACRES Surveyed June & July - 1989

Bernard Glime, III
 O.R. Vol. 203 Pg. 789 & O.R. Vol. 212, Pg. 191
 N. 1° 02' 50" E,
 300.01'
 Richard S. & Martha C. Augustin
 D. Vol. 1927 Pg. 716 60 Acres

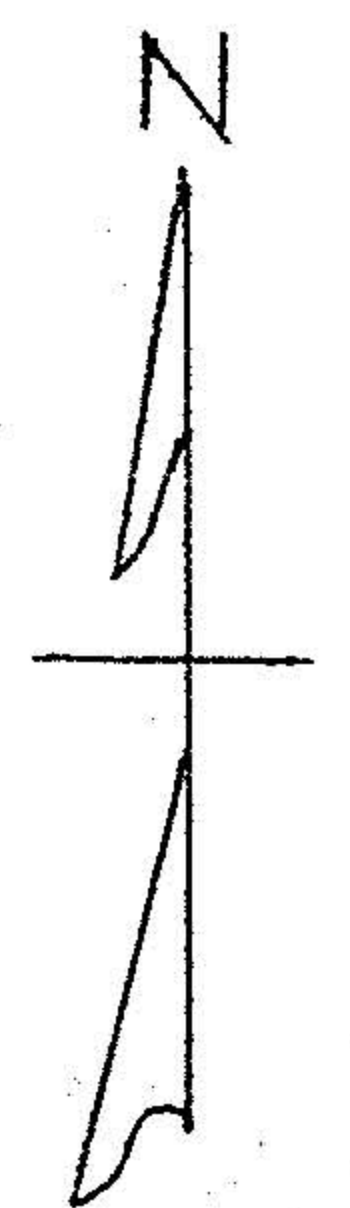

O.L. 72 N. 0° 55' 50" E,
 O.L. 73 L Fence Line

O.L. 72 Due East 932.62'
 O.L. 82 Due East 490.00'
 PK SET
 412.00'
 RRS 2790.16'
 RRS
 1005.89'
 RRS

OBERLIN-NORWALK ROAD 60' R/W Originally STATE RTE. 10

QUARRY ROAD 60' R/W
 N. 1° 10' 25" E. O.L. 71
 2679.35'
 S. 1° 10' 25" W. O.L. 72
 768.57'

1.P. in Mon. Box