

09-00-090-000-

#19106

9-00-090-B


Ronald & Sharon
Bailey
D. Vol 1185 Pg 116

Thomas Paul Scott
D. Vol 1338 Pg 728

Russia Twp
Carlisle Twp



PK spc

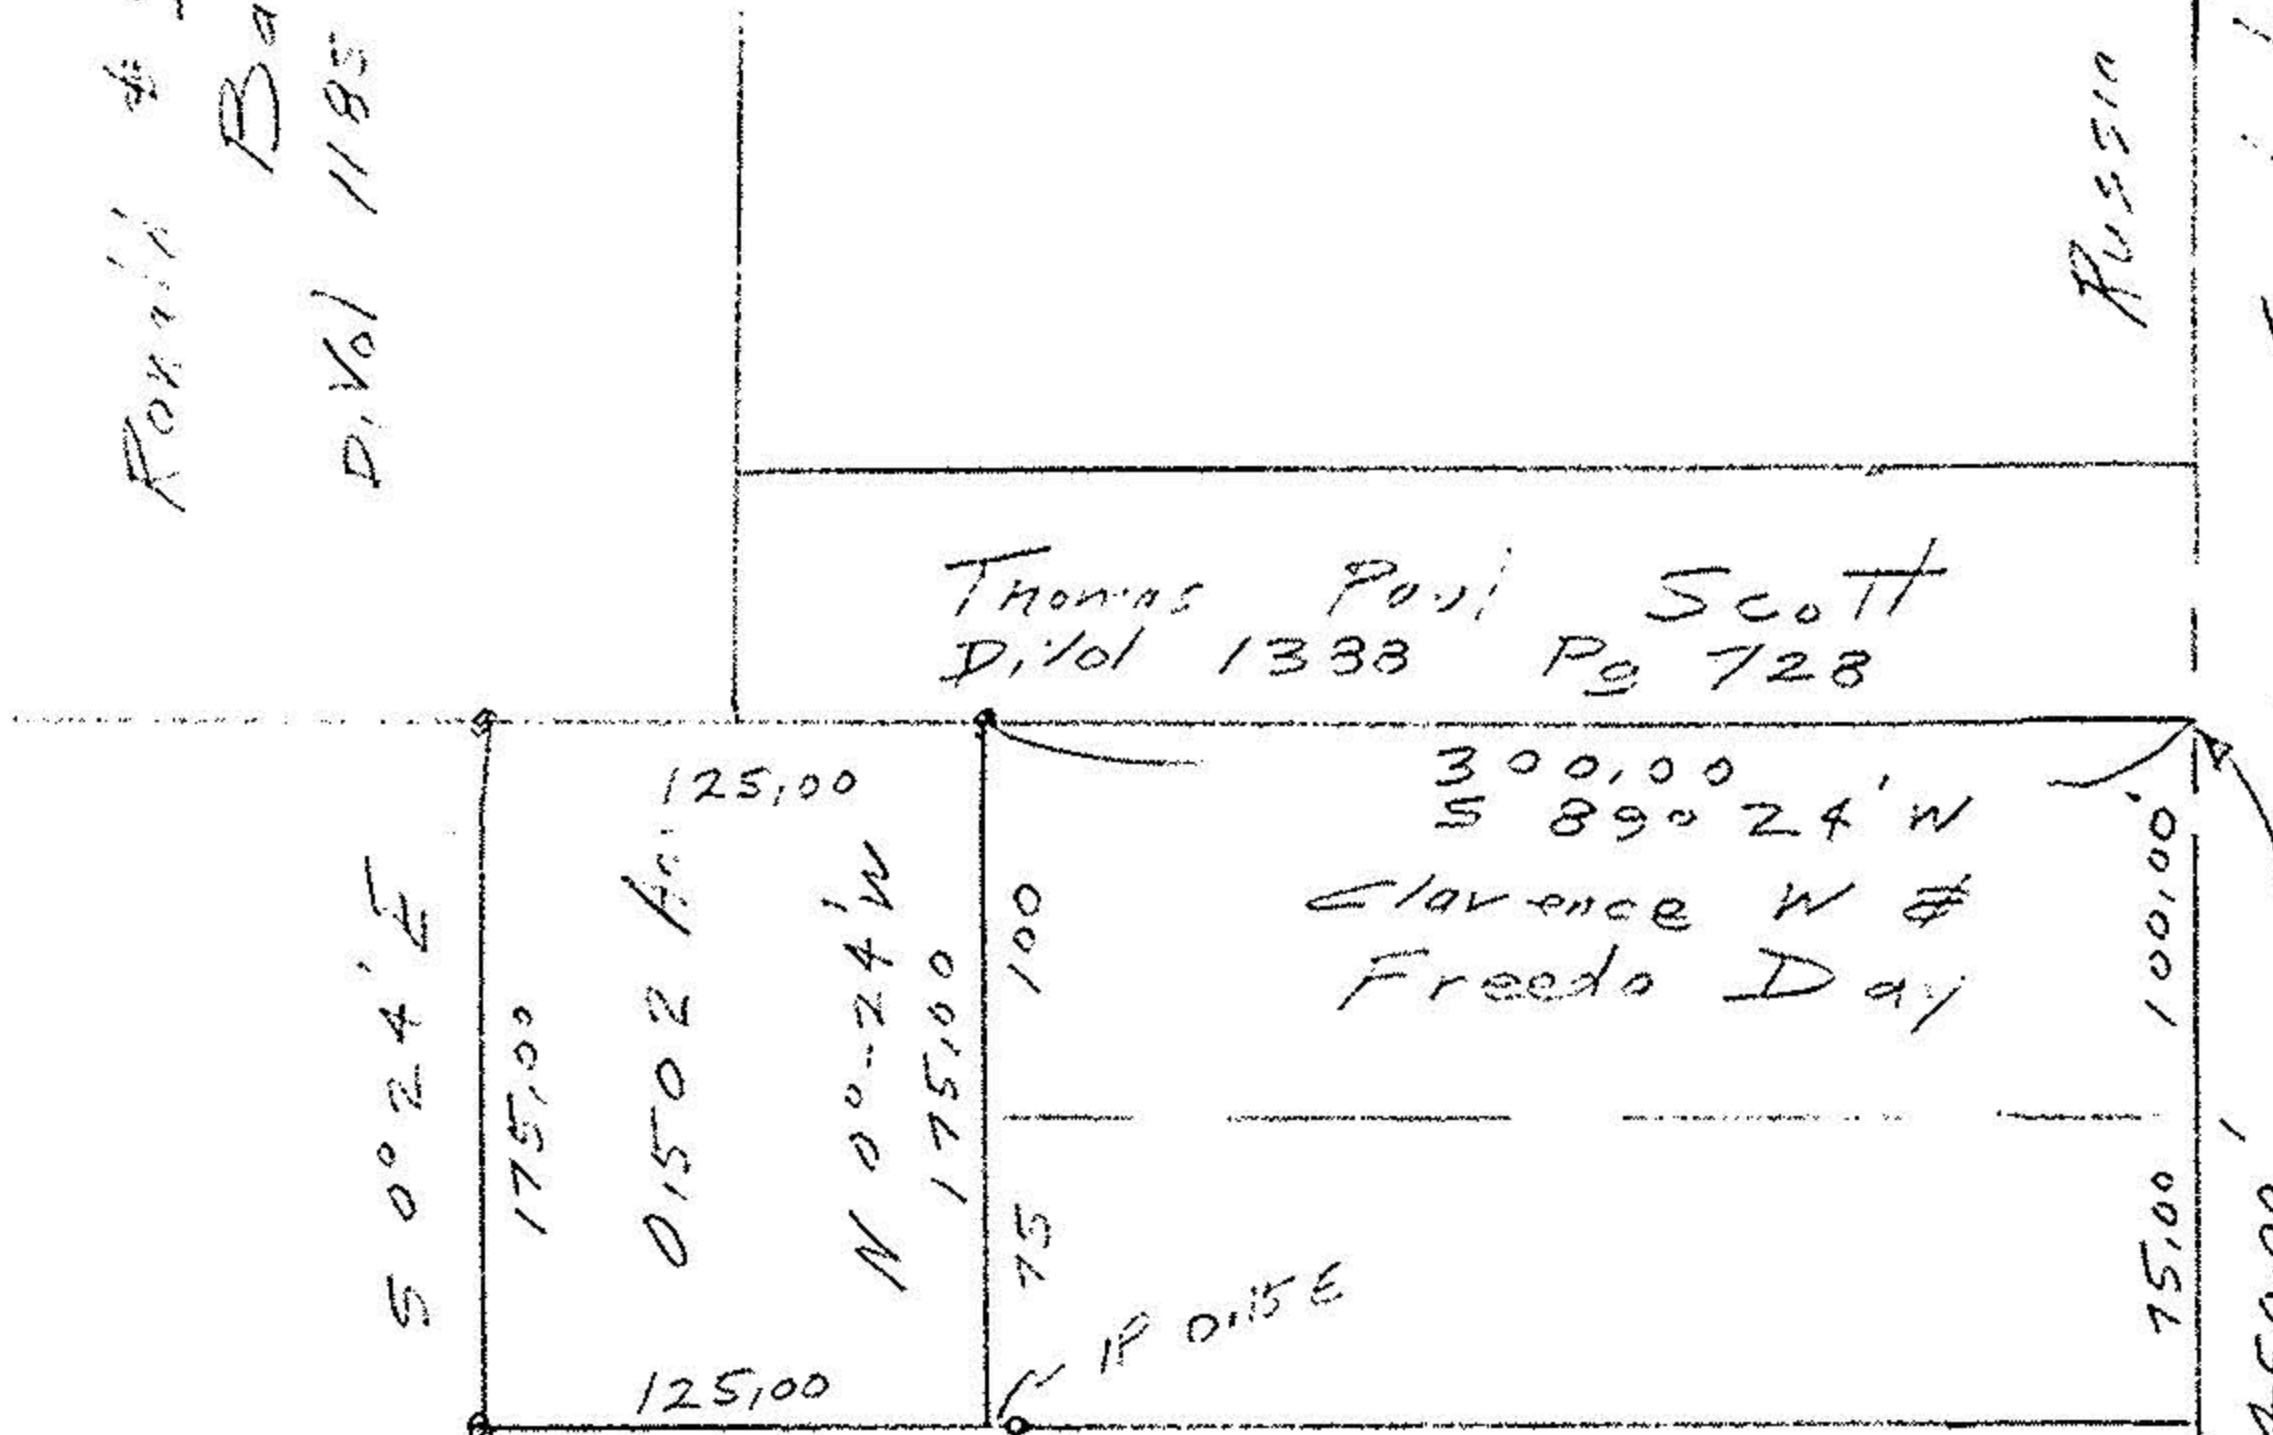

Treva R Bailey
D. Vol 930 Pg 600

29.518 Acres
Remainder by
Auditor

John Pajzysak
Reg. Surveyor
5292

50.00 5/4 1
East, Akerle All't
P. Vol 19 Pg 30

Survey for Clarence Day
Part of Original Lot 90
Russia Township
Lorain County Ohio
Scale 1" = 100' July 30, 1990

#19106

APPROVED LORAIN CO. MAP DEPT.
DATE 8-29-90
PAGE 9-00-090-B
BY CAROLYN FRANCIS
VOID AFTER # 19106