
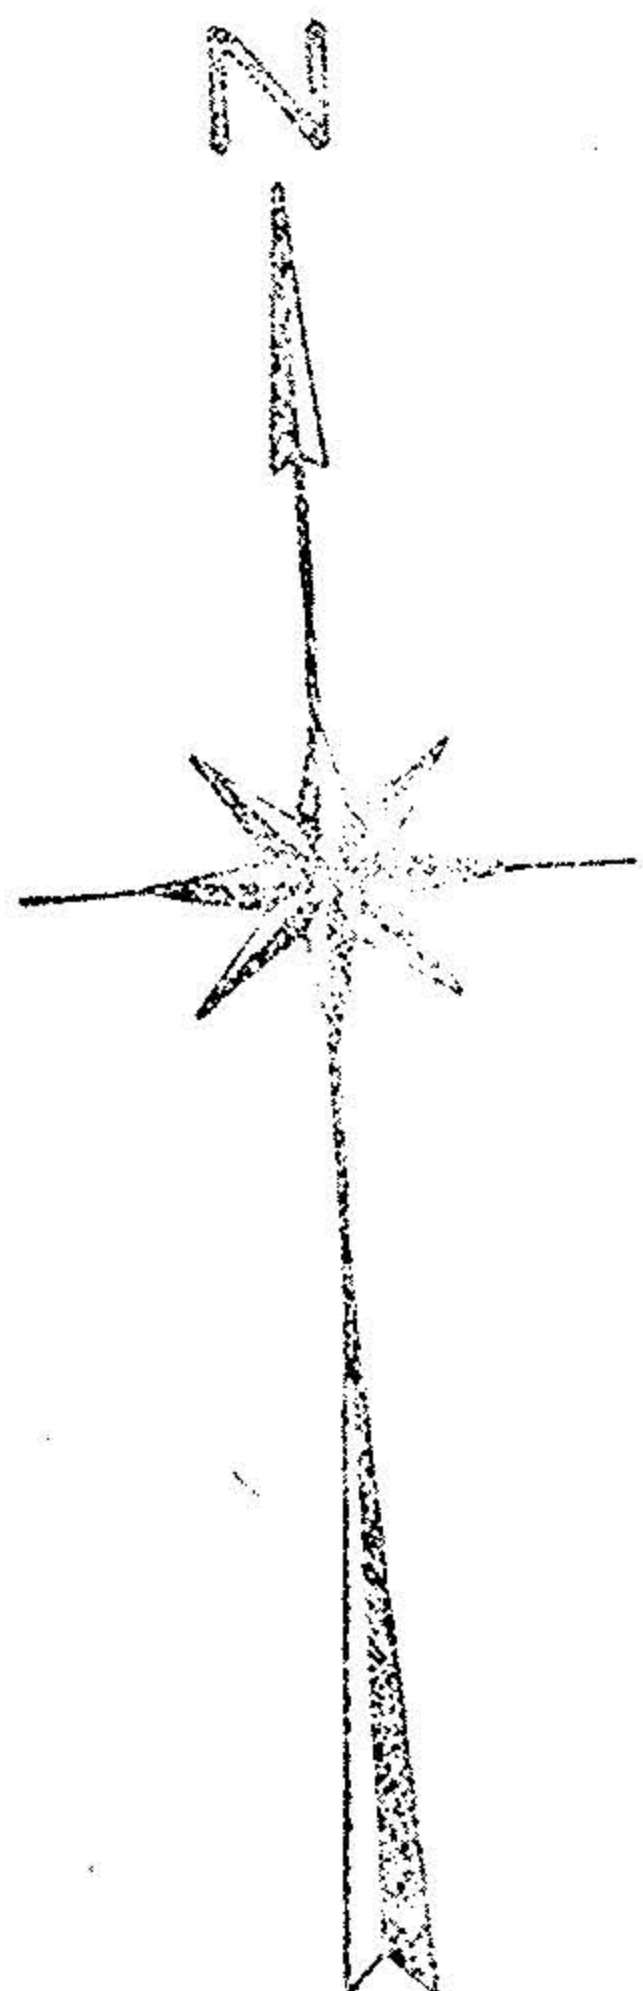


7-00-104

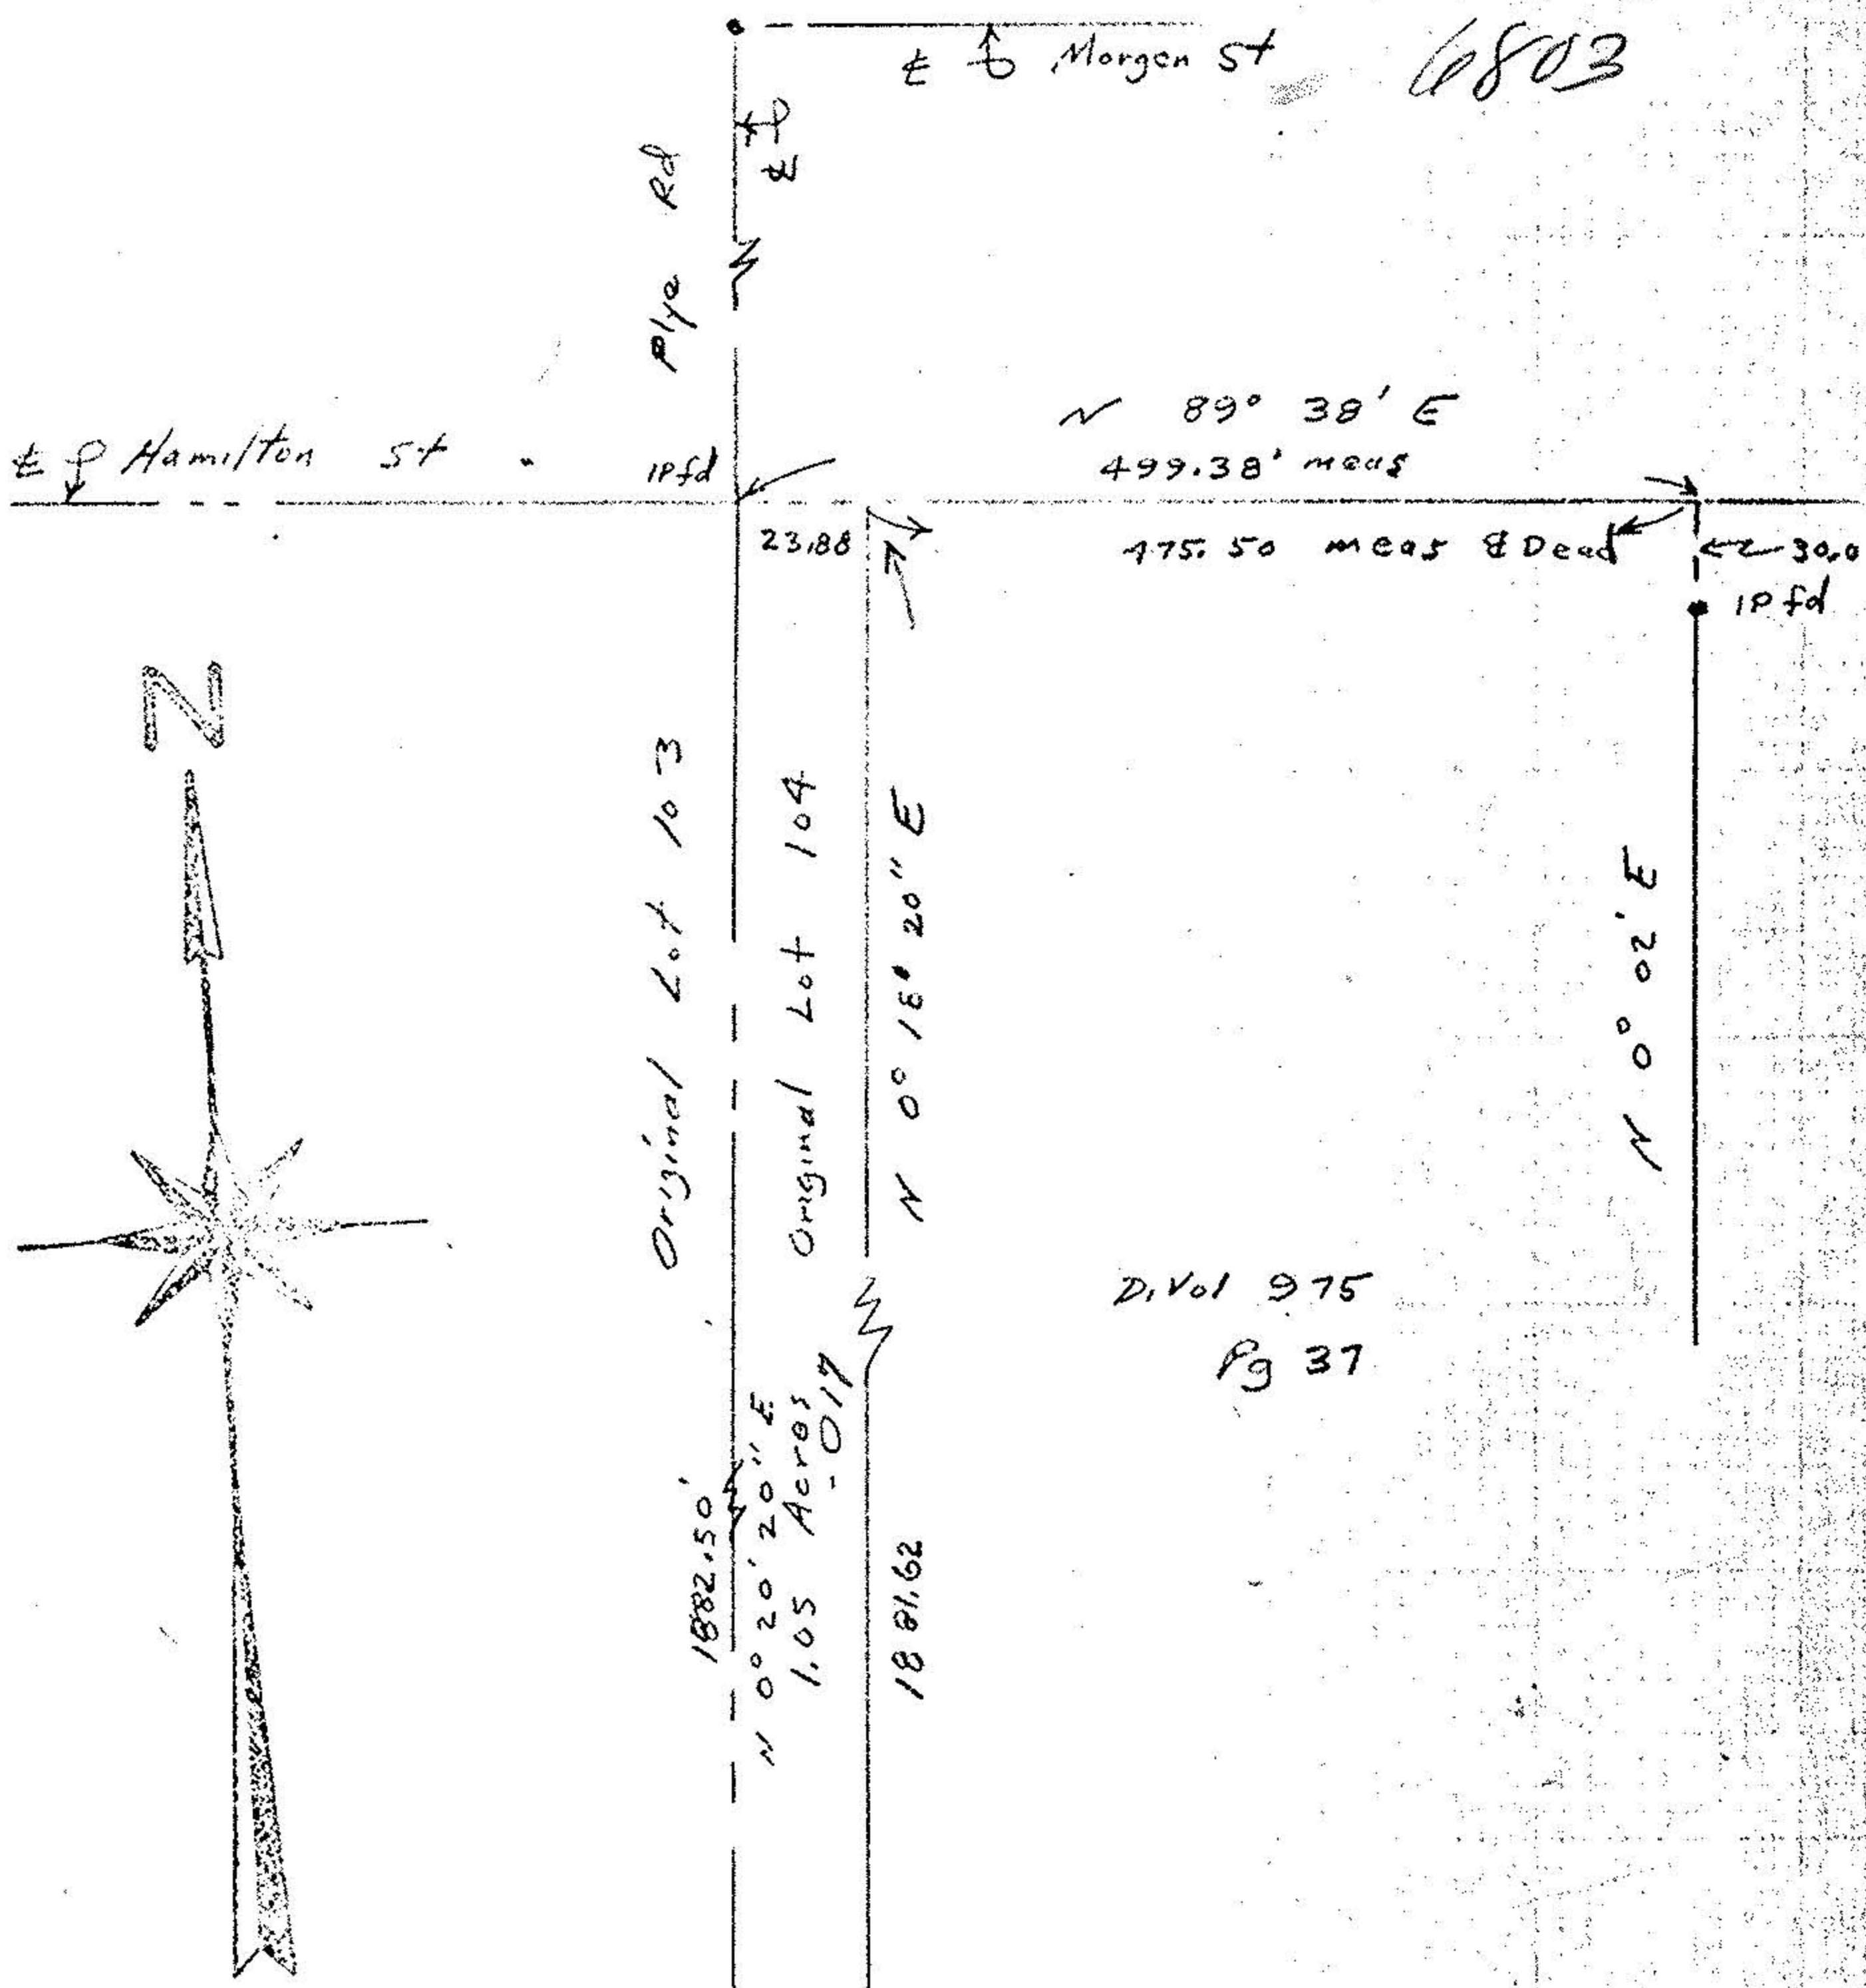

Russia Township

Pittsfield Township

John Poyjwal

John Poyjwal
Reg. Surveyor
#5292

Survey for
Leroy A. Fridenstine
Part of Original Lot 104
Russia Township
Loram County, Ohio
Not to scale
March 10, 1973