


9-00-096-A

20363 - 09-00-096-110-

MAP OF SURVEY FOR AMBILT CORP.
CITY OF OBERLIN - RUSSIA TWP. - O.L. #96
APRIL 1993 SCALE 1"=50'
JOHN R. HAMILTON - REG. SURVEYOR #6861

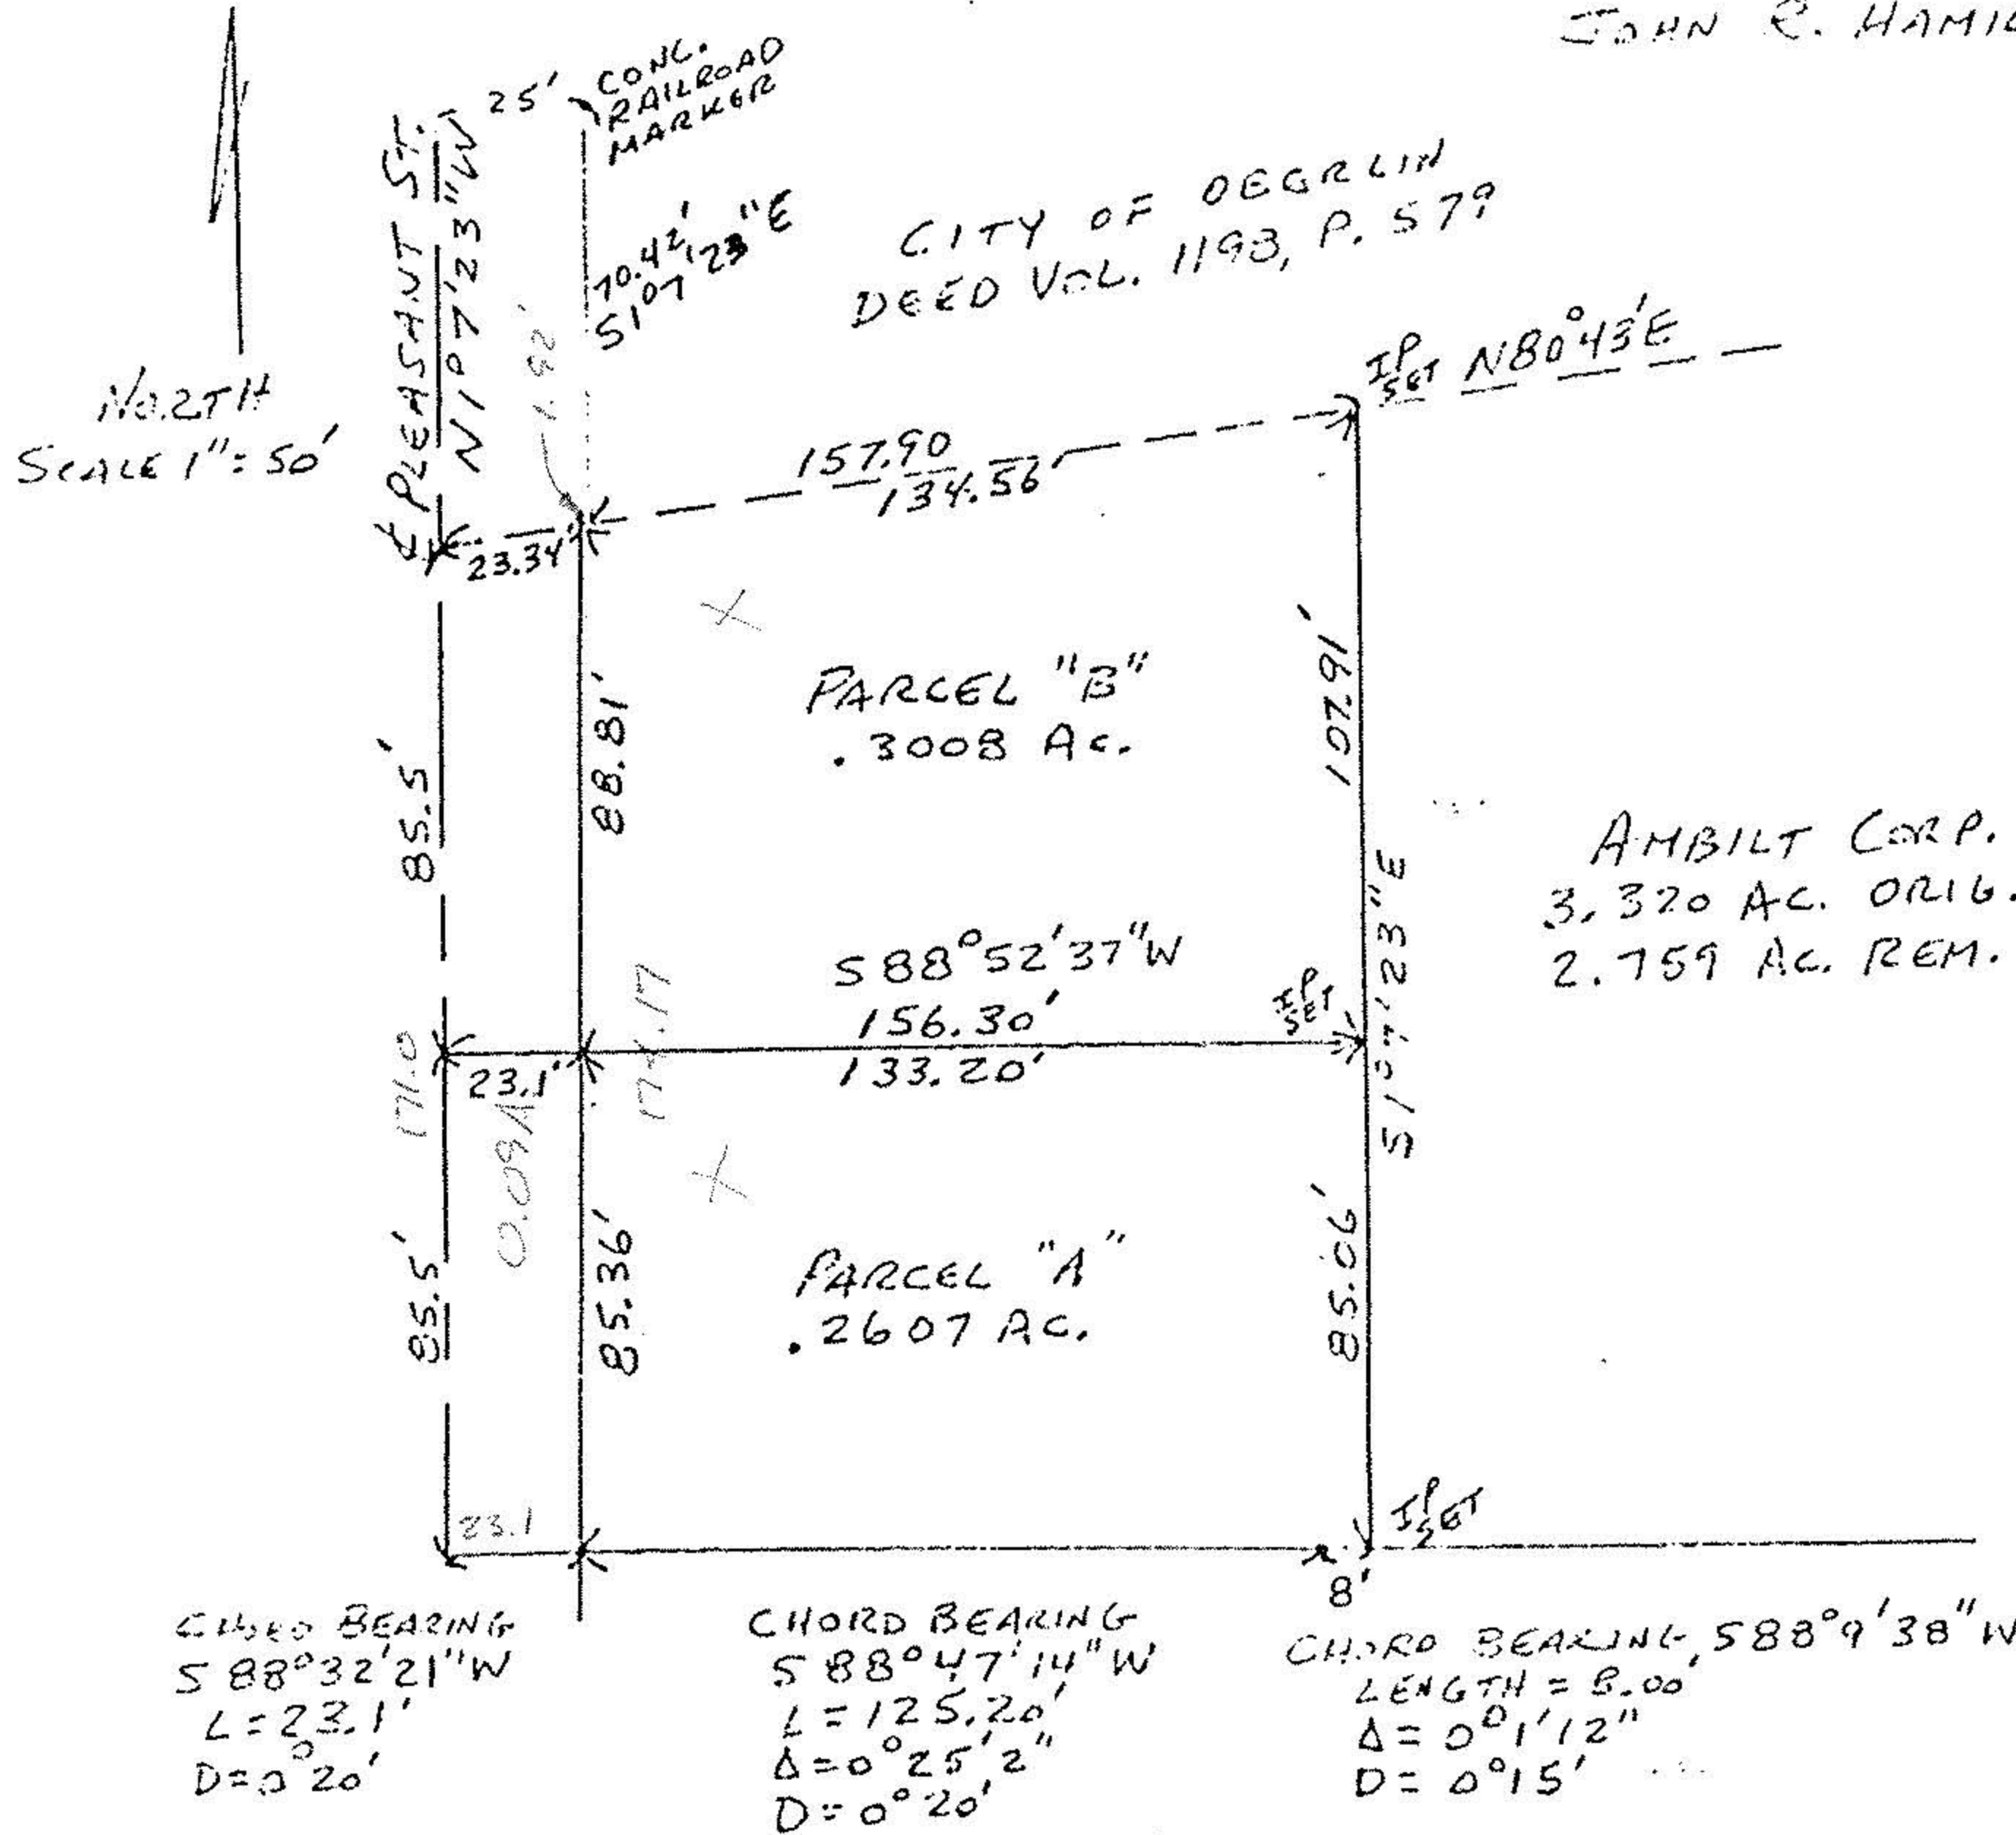

20363

APPROVED
LORAIN CO.
MAP DEPT.
DATE 6-30-93
PAGE 9-00-096-A
BY CAROLYN FRANCIS
VOID NUMBER 20363



A.H. CLARK
DEED VOL. 1160, P. 945