


9-00-100-B

9642

09-00-100-000

9642
9-00-100-B

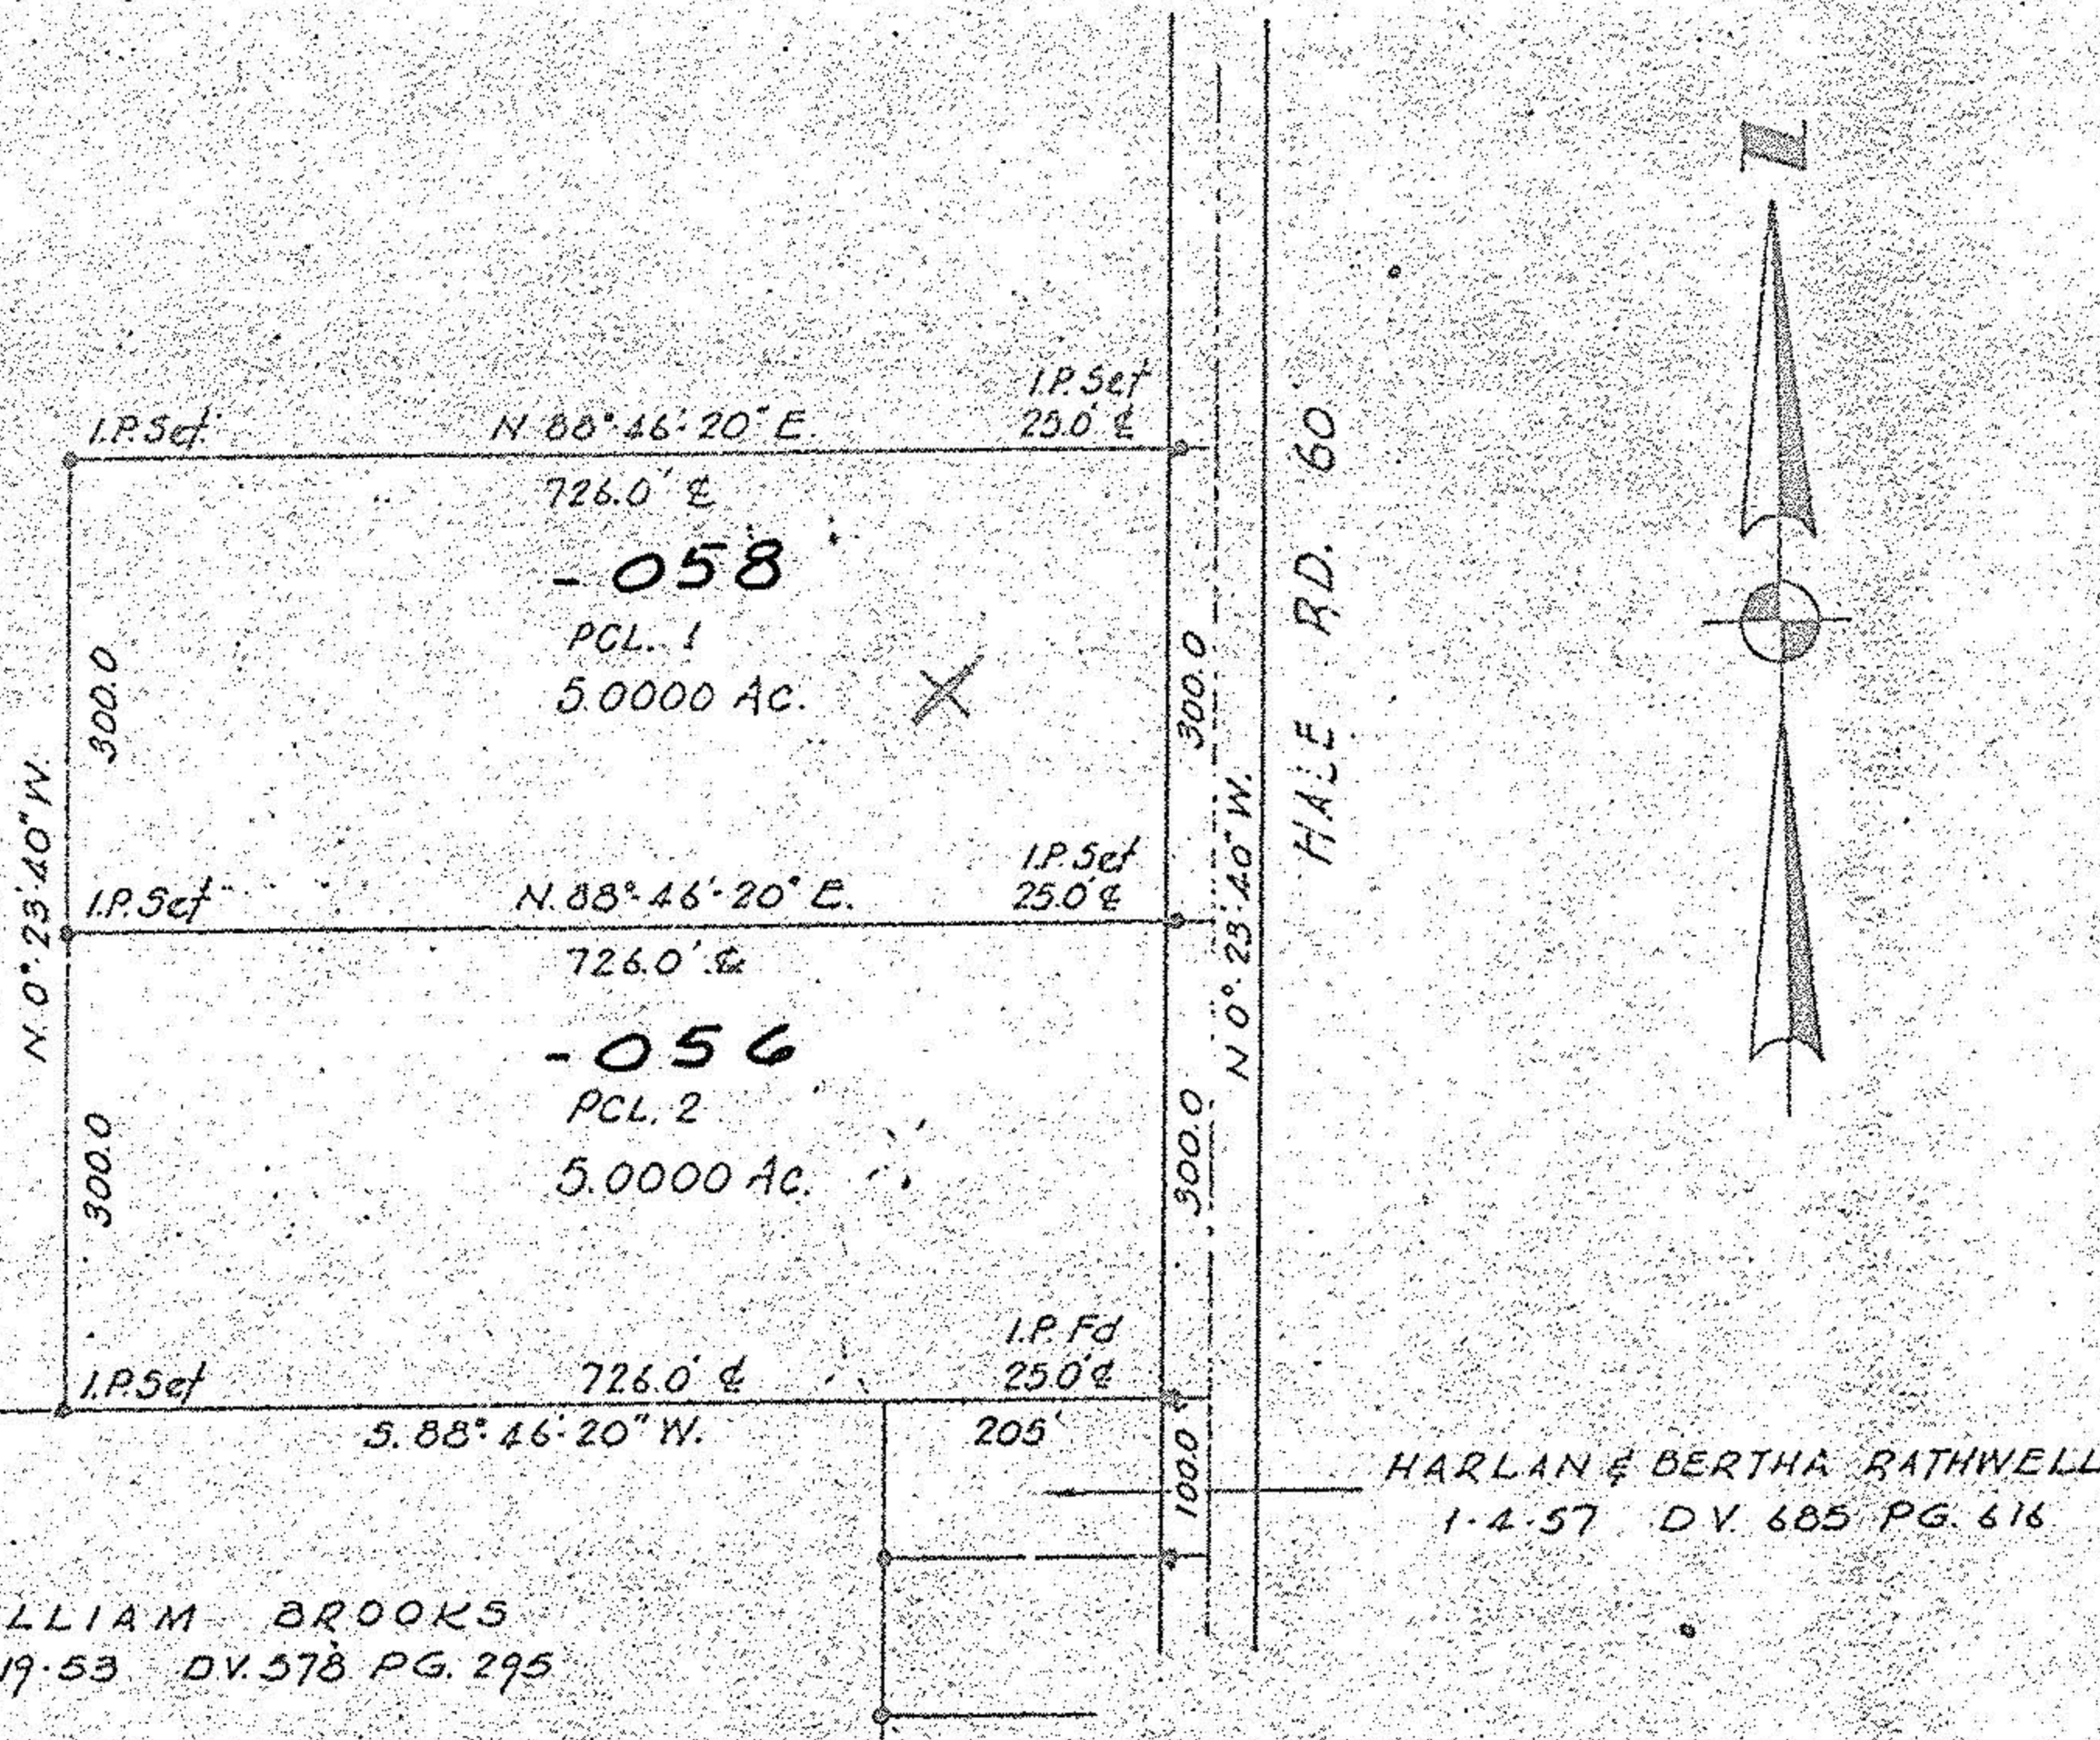

WILLIAM BROOKS
8-19-53 DV. 578 PG. 295

HARLAN & BERTHA RATHWELL
1-4-57 DV. 685 PG. 616

SURVEY FOR
ROBERT BROOKS

O.L. 100 RUSSIA TWP. LORAIN CO. OHIO

SCALE 1"=200' MAY 10, 1976

LAUNDON-SIMON-CAHL & ASSOC.

ENGINEERS SURVEYORS

FB. 195/19 JOB No 76-492

OCT 28 1976




9-00-100-B

9627

09-00-100-000

9627
9-00-100-B

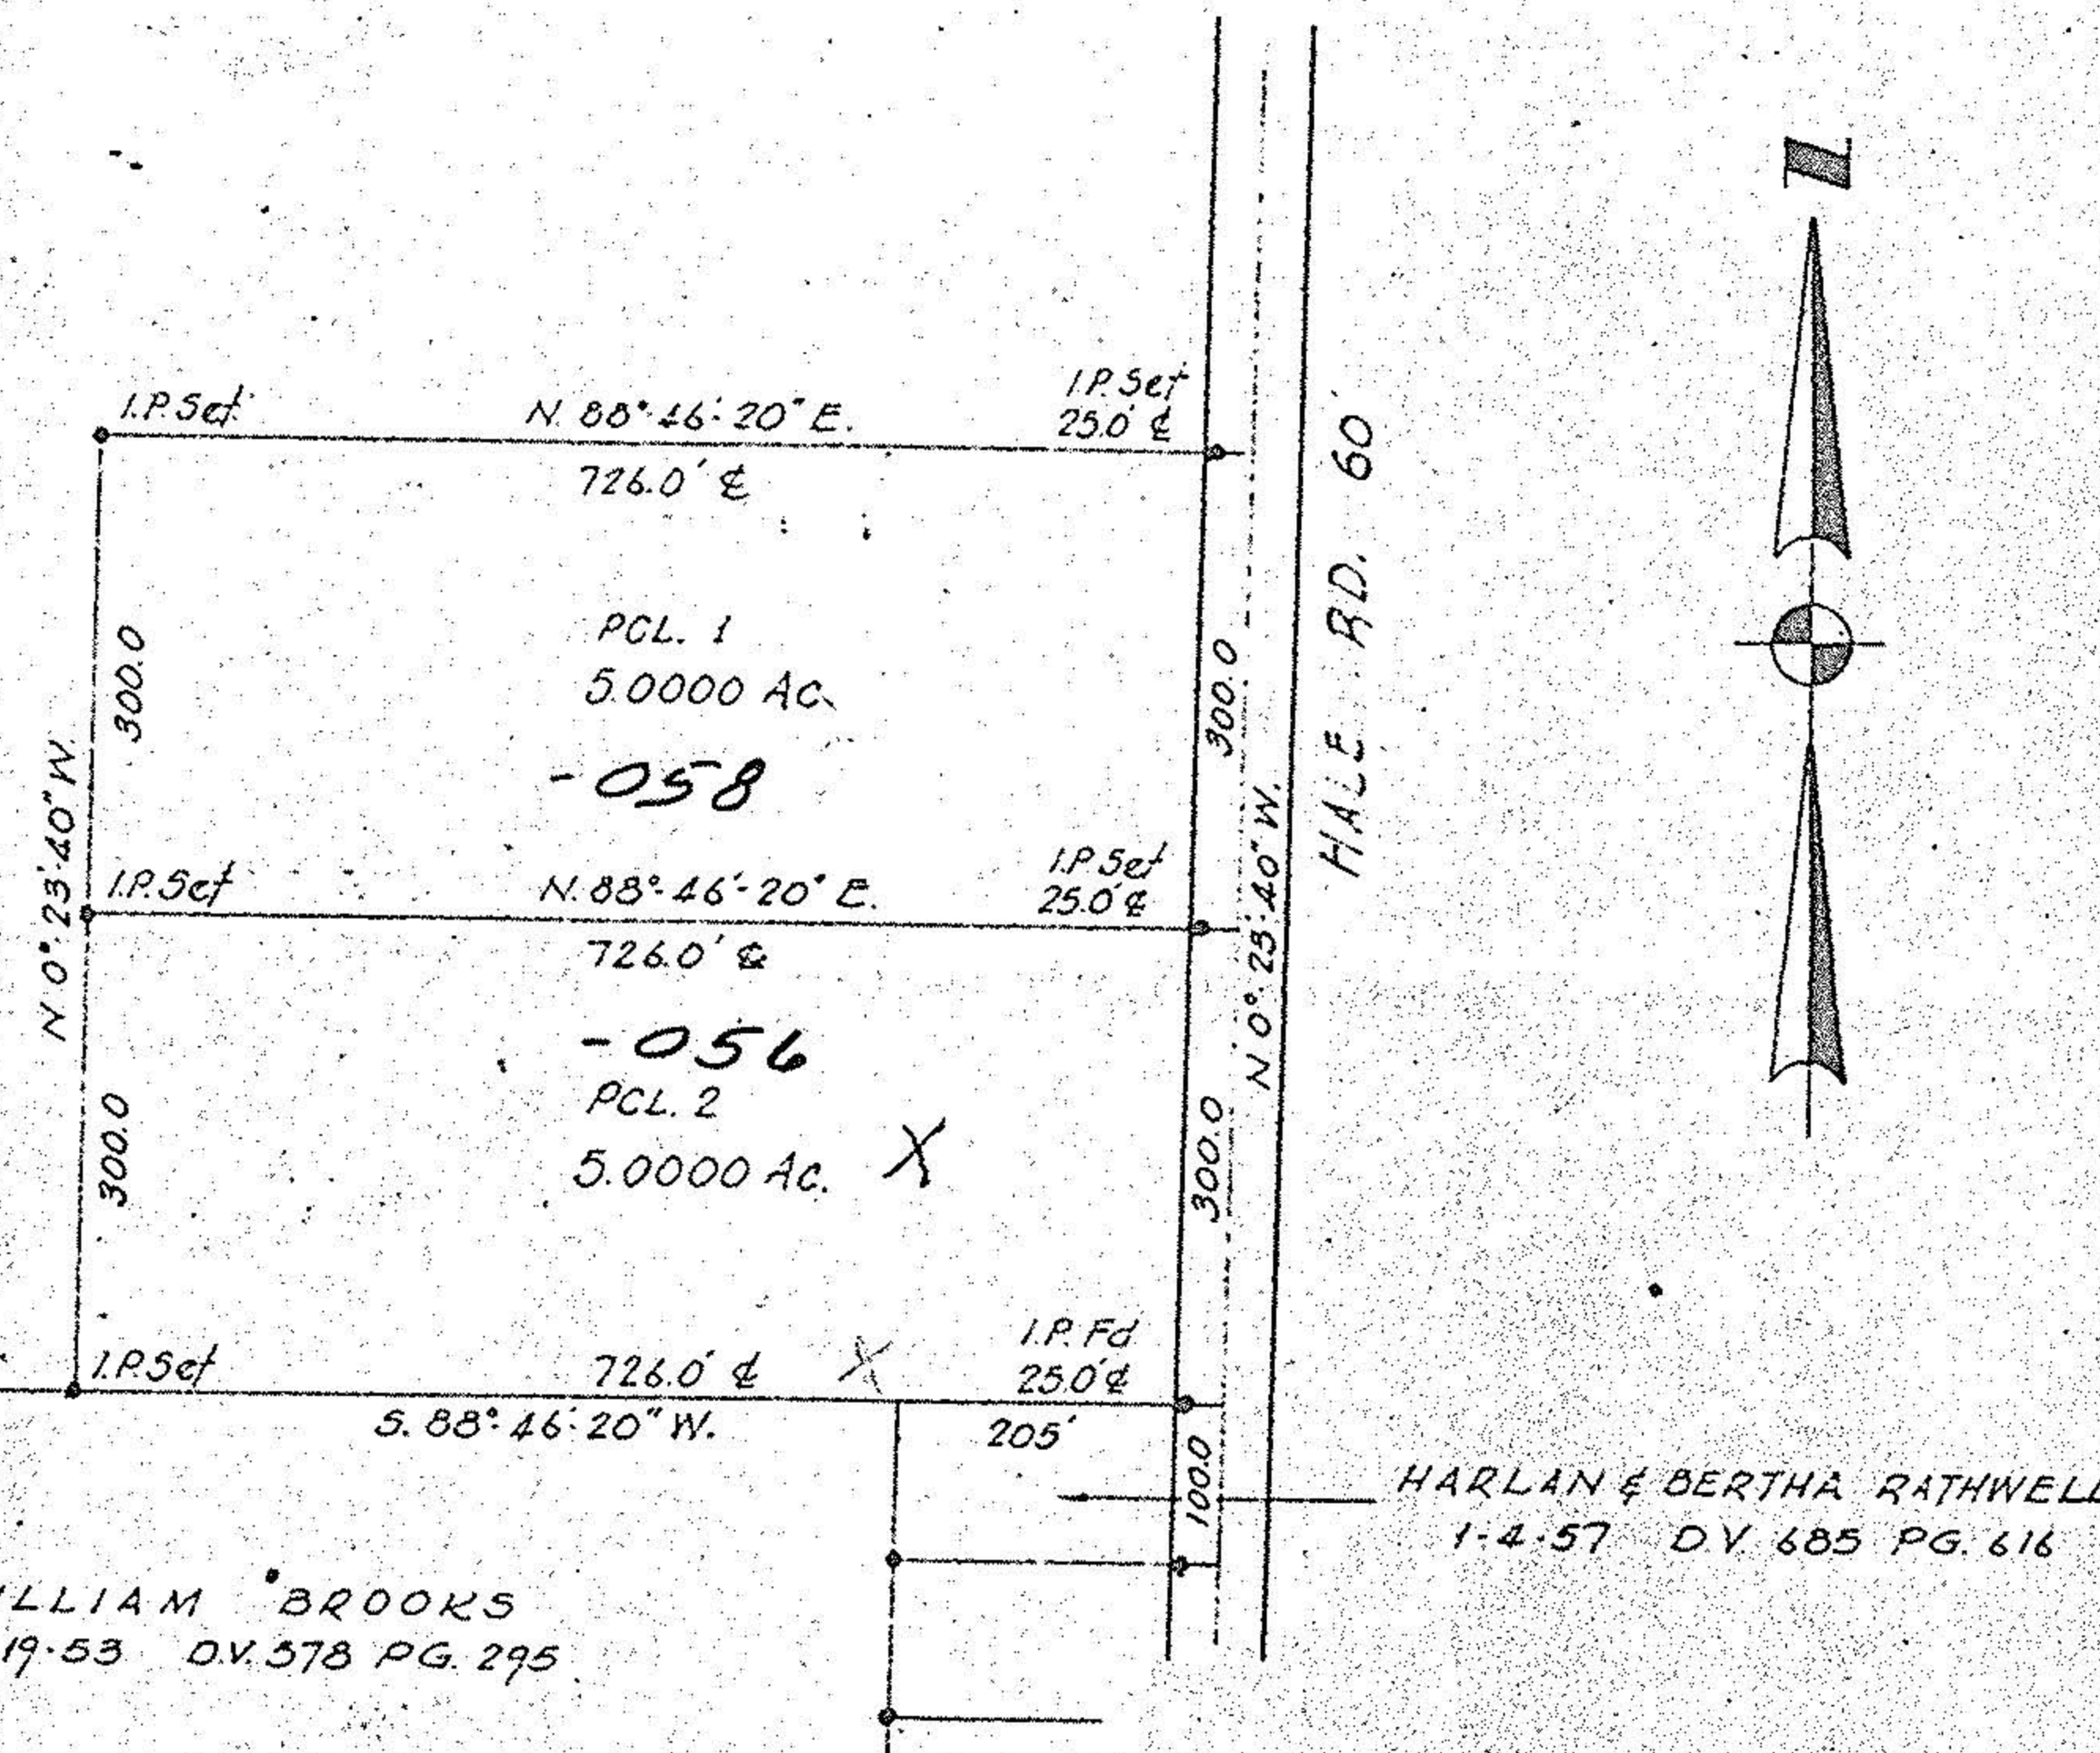

WILLIAM BROOKS
8-19-53 DV. 578 PG. 295

HARLAN & BERTHA RATHWELL
1-4-57 DV. 685 PG. 616

SURVEY FOR
ROBERT BROOKS

O.L. 100 RUSSIA TWP. LORAIN CO. OHIO

SCALE 1"=200' MAY 10, 1976

LAUNDON-SIMON-CAHL & ASSOC.

ENGINEERS SURVEYORS

FB. 195/19 JOB No 76-492

OCT 28 1976

