




LAUNDON . SIMON . CAHL & ASSOC. INC.
CONSULTING ENGINEERS & SURVEYORS
219 COURT ST. ELYRIA, OHIO 44035

SURVEY FOR:

JAMES C. & RUTH G. BROOKS

Orig. Lot 100	City of	Date JULY 1987 Scale 1"=100'
Orig. Sec	Village of	Dwn. by R.G.S. Chkd. by C.J.
Tract	County of LORAIN	Job No. Rev. of 87-1615 F.B.
Township of RUSSIA	State of OHIO	Printed JUL 8 1987

09-00-100-000
17552
9-00-100-13

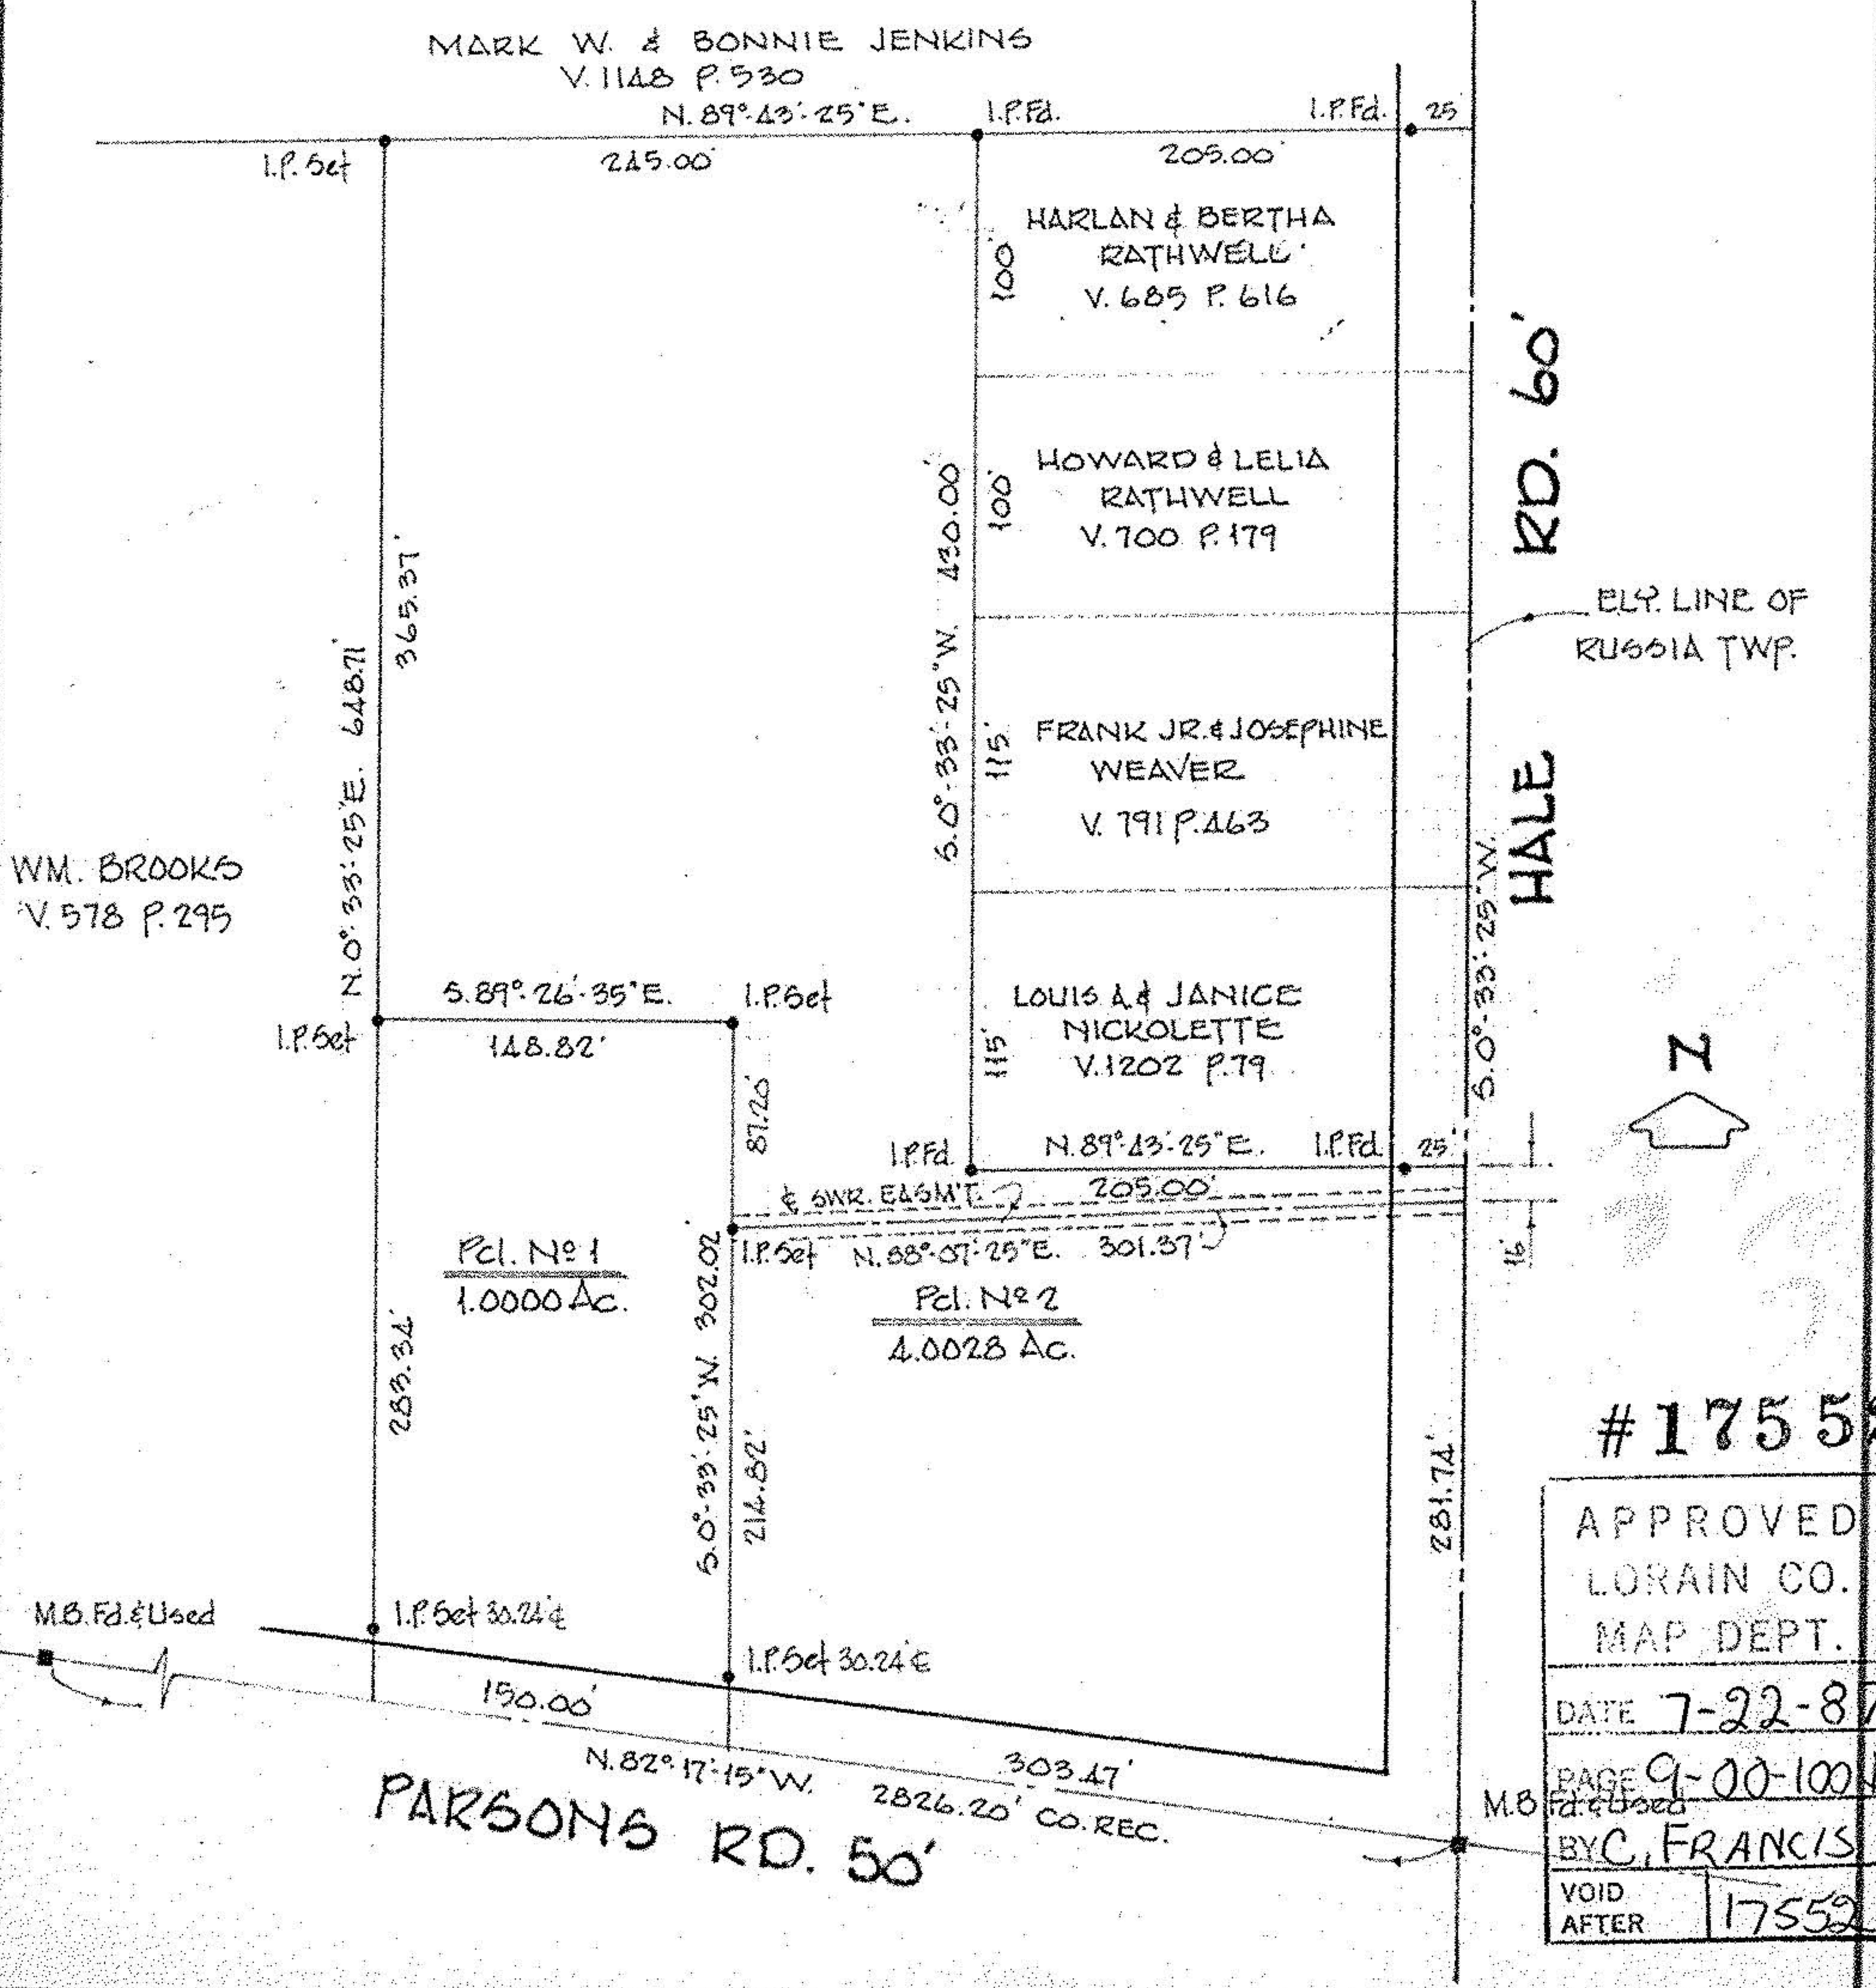

#17552

APPROVED	LORAIN CO.
MAP DEPT.	
DATE	7-22-87
PAGE	9-00-100-13
BY	FRANCIS
VOID AFTER	17552