
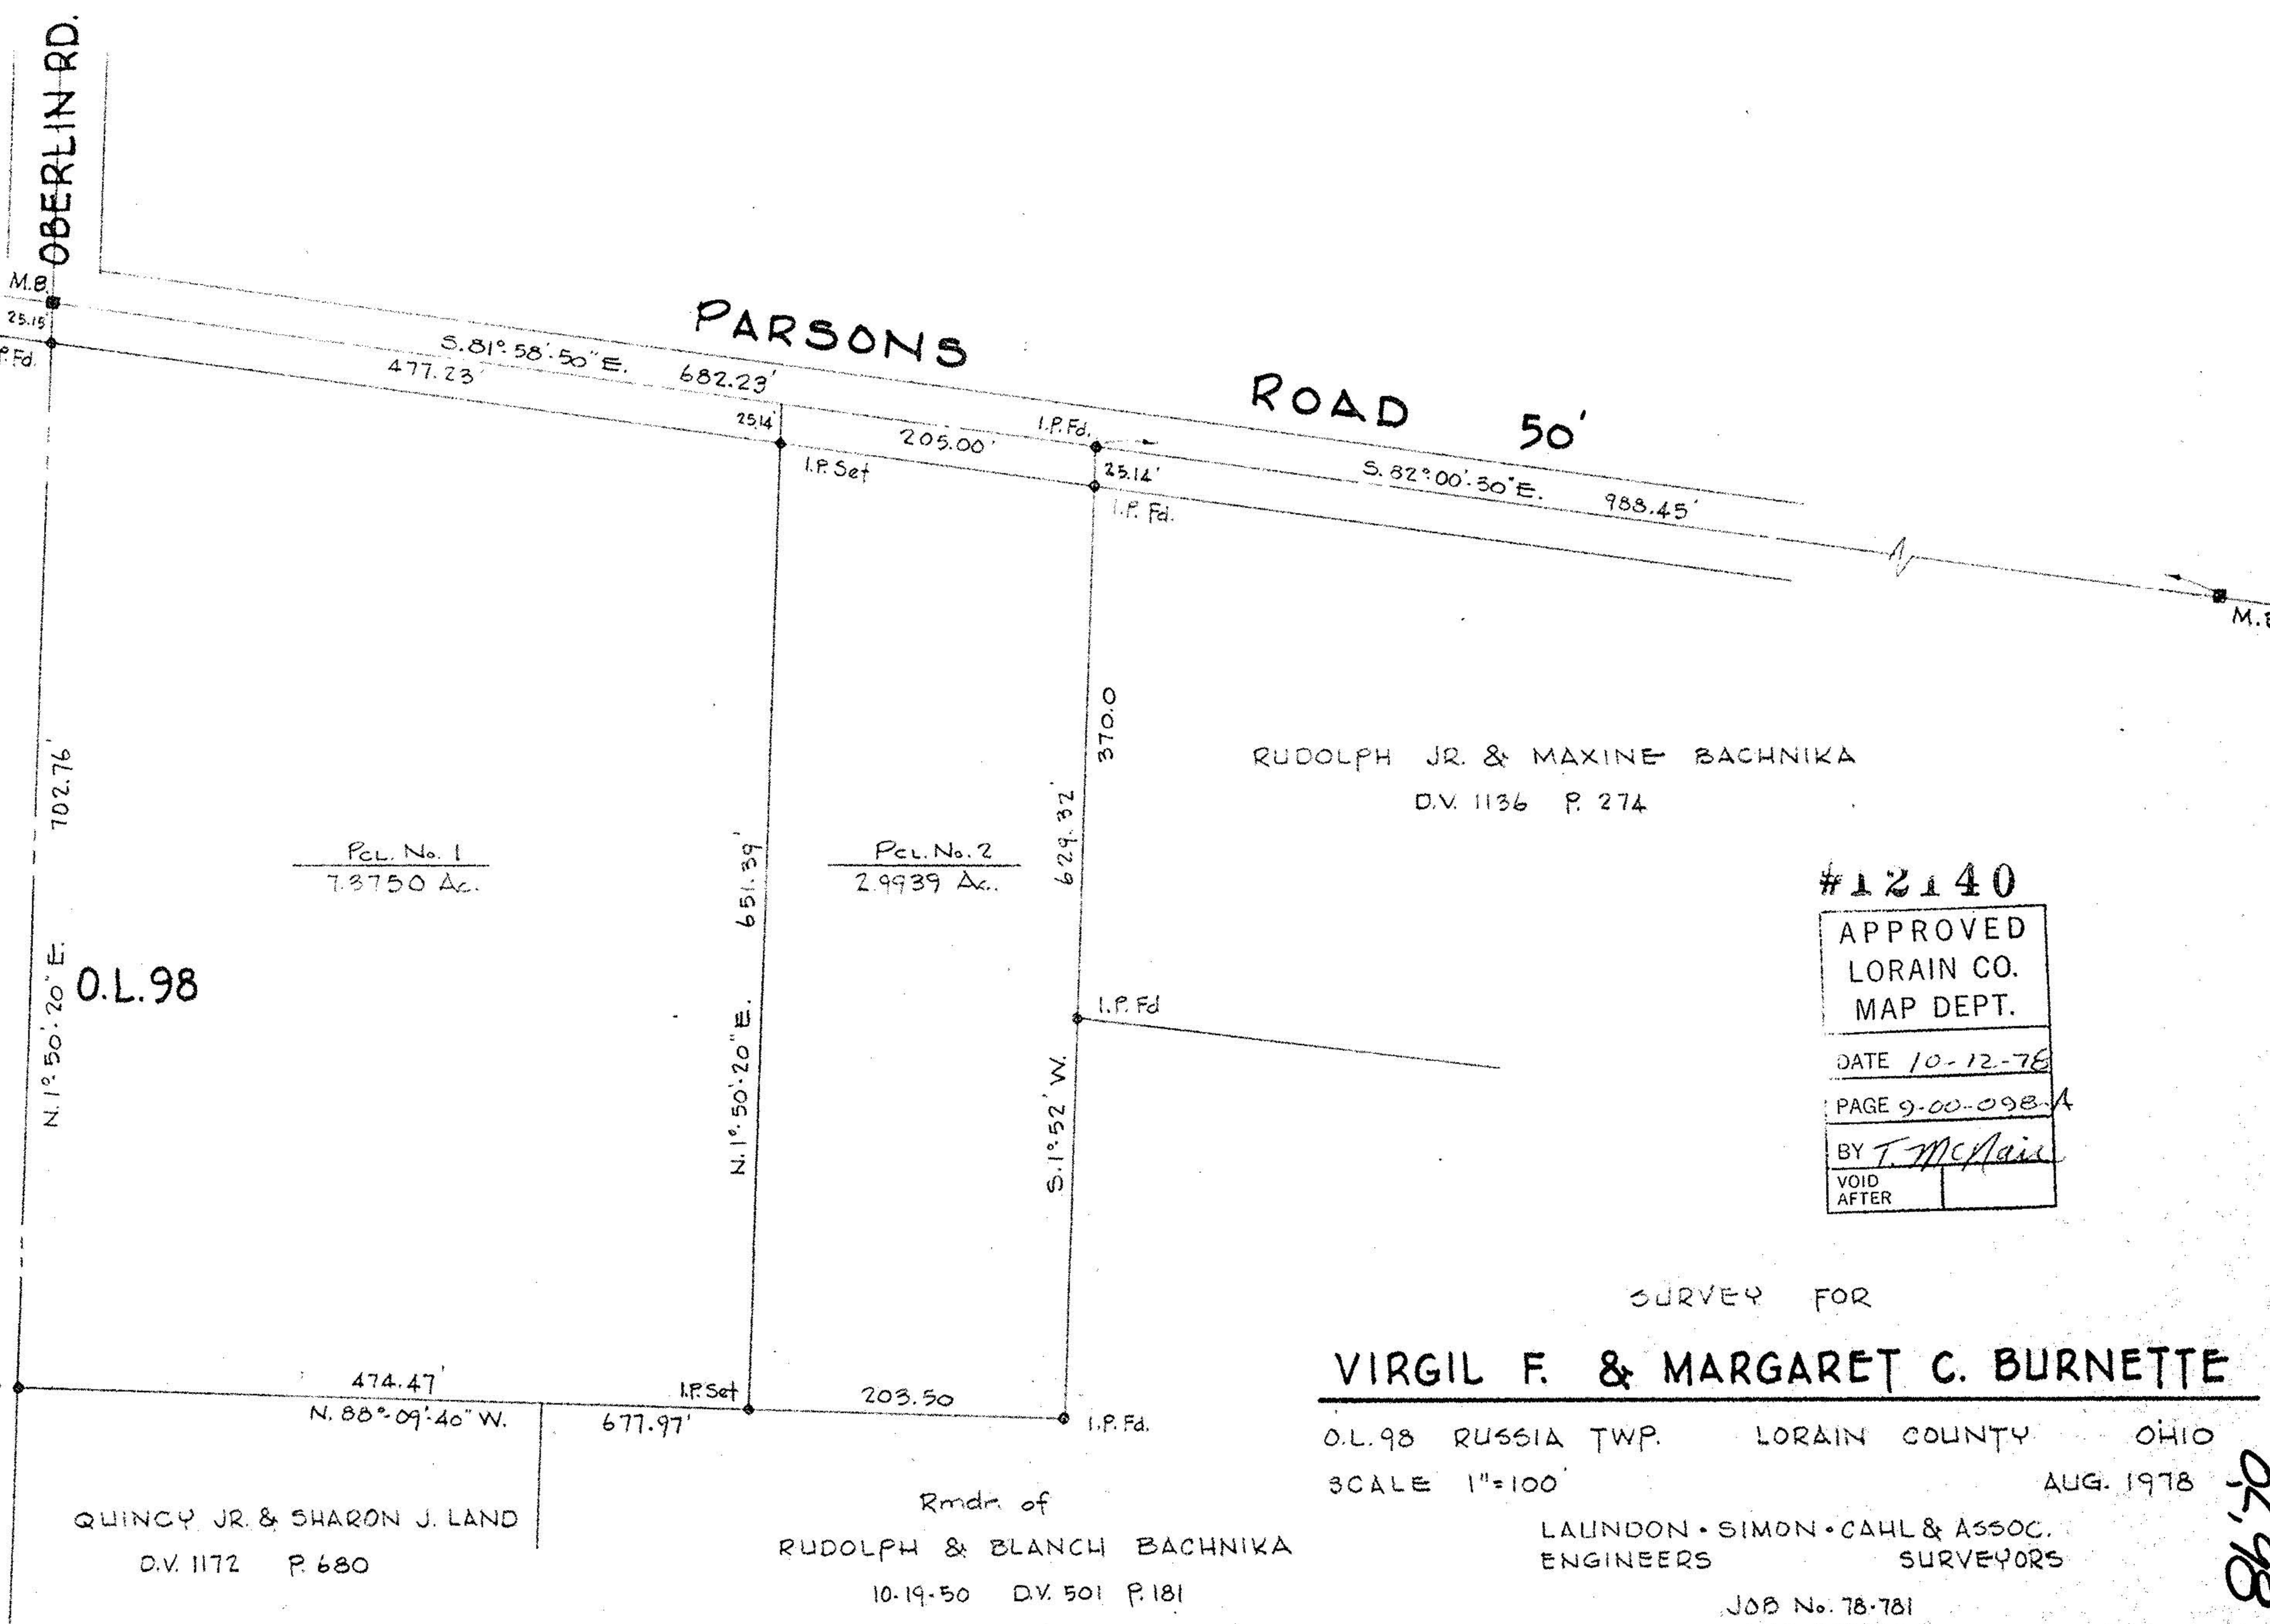


09-00-098-000

12140

9-00-098-A

OK, 98

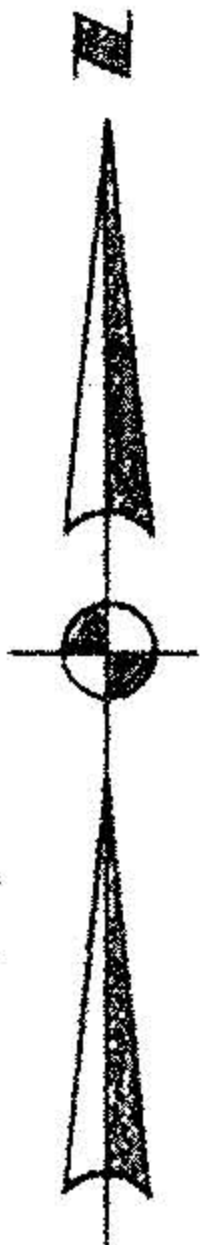

RUDOLPH JR. & MAXINE BACHNIKA
D.V. 1136 P. 274

#12140
APPROVED
LORAIN CO.
MAP DEPT.
DATE 10-12-78
PAGE 9-00-098-A
BY T. McAlain
VOID
AFTER

SURVEY FOR
VIRGIL F. & MARGARET C. BURNETTE

O.L. 98 RUSSIA TWP. LORAIN COUNTY OHIO
SCALE 1"=100' AUG. 1978

LAUNDON • SIMON • CAHL & ASSOC.
ENGINEERS SURVEYORS

JOB No. 78-781
F.B. 195 P. 8

QUINCY JR. & SHARON J. LAND
D.V. 1172 P. 680

Rmdn of
RUDOLPH & BLANCH BACHNIKA
10-19-50 D.V. 501 P. 181

AUG 25 1978

OK, 98

108

9-00-098-A #12140 09-00-098-000