


SURVEY

Sublot(s) _____
 Subd'n _____

Township RUSSIA Tract _____
 Orig. Lot(s) 106 Sec. _____
 County of LORAIN State of Ohio
 Corporation _____

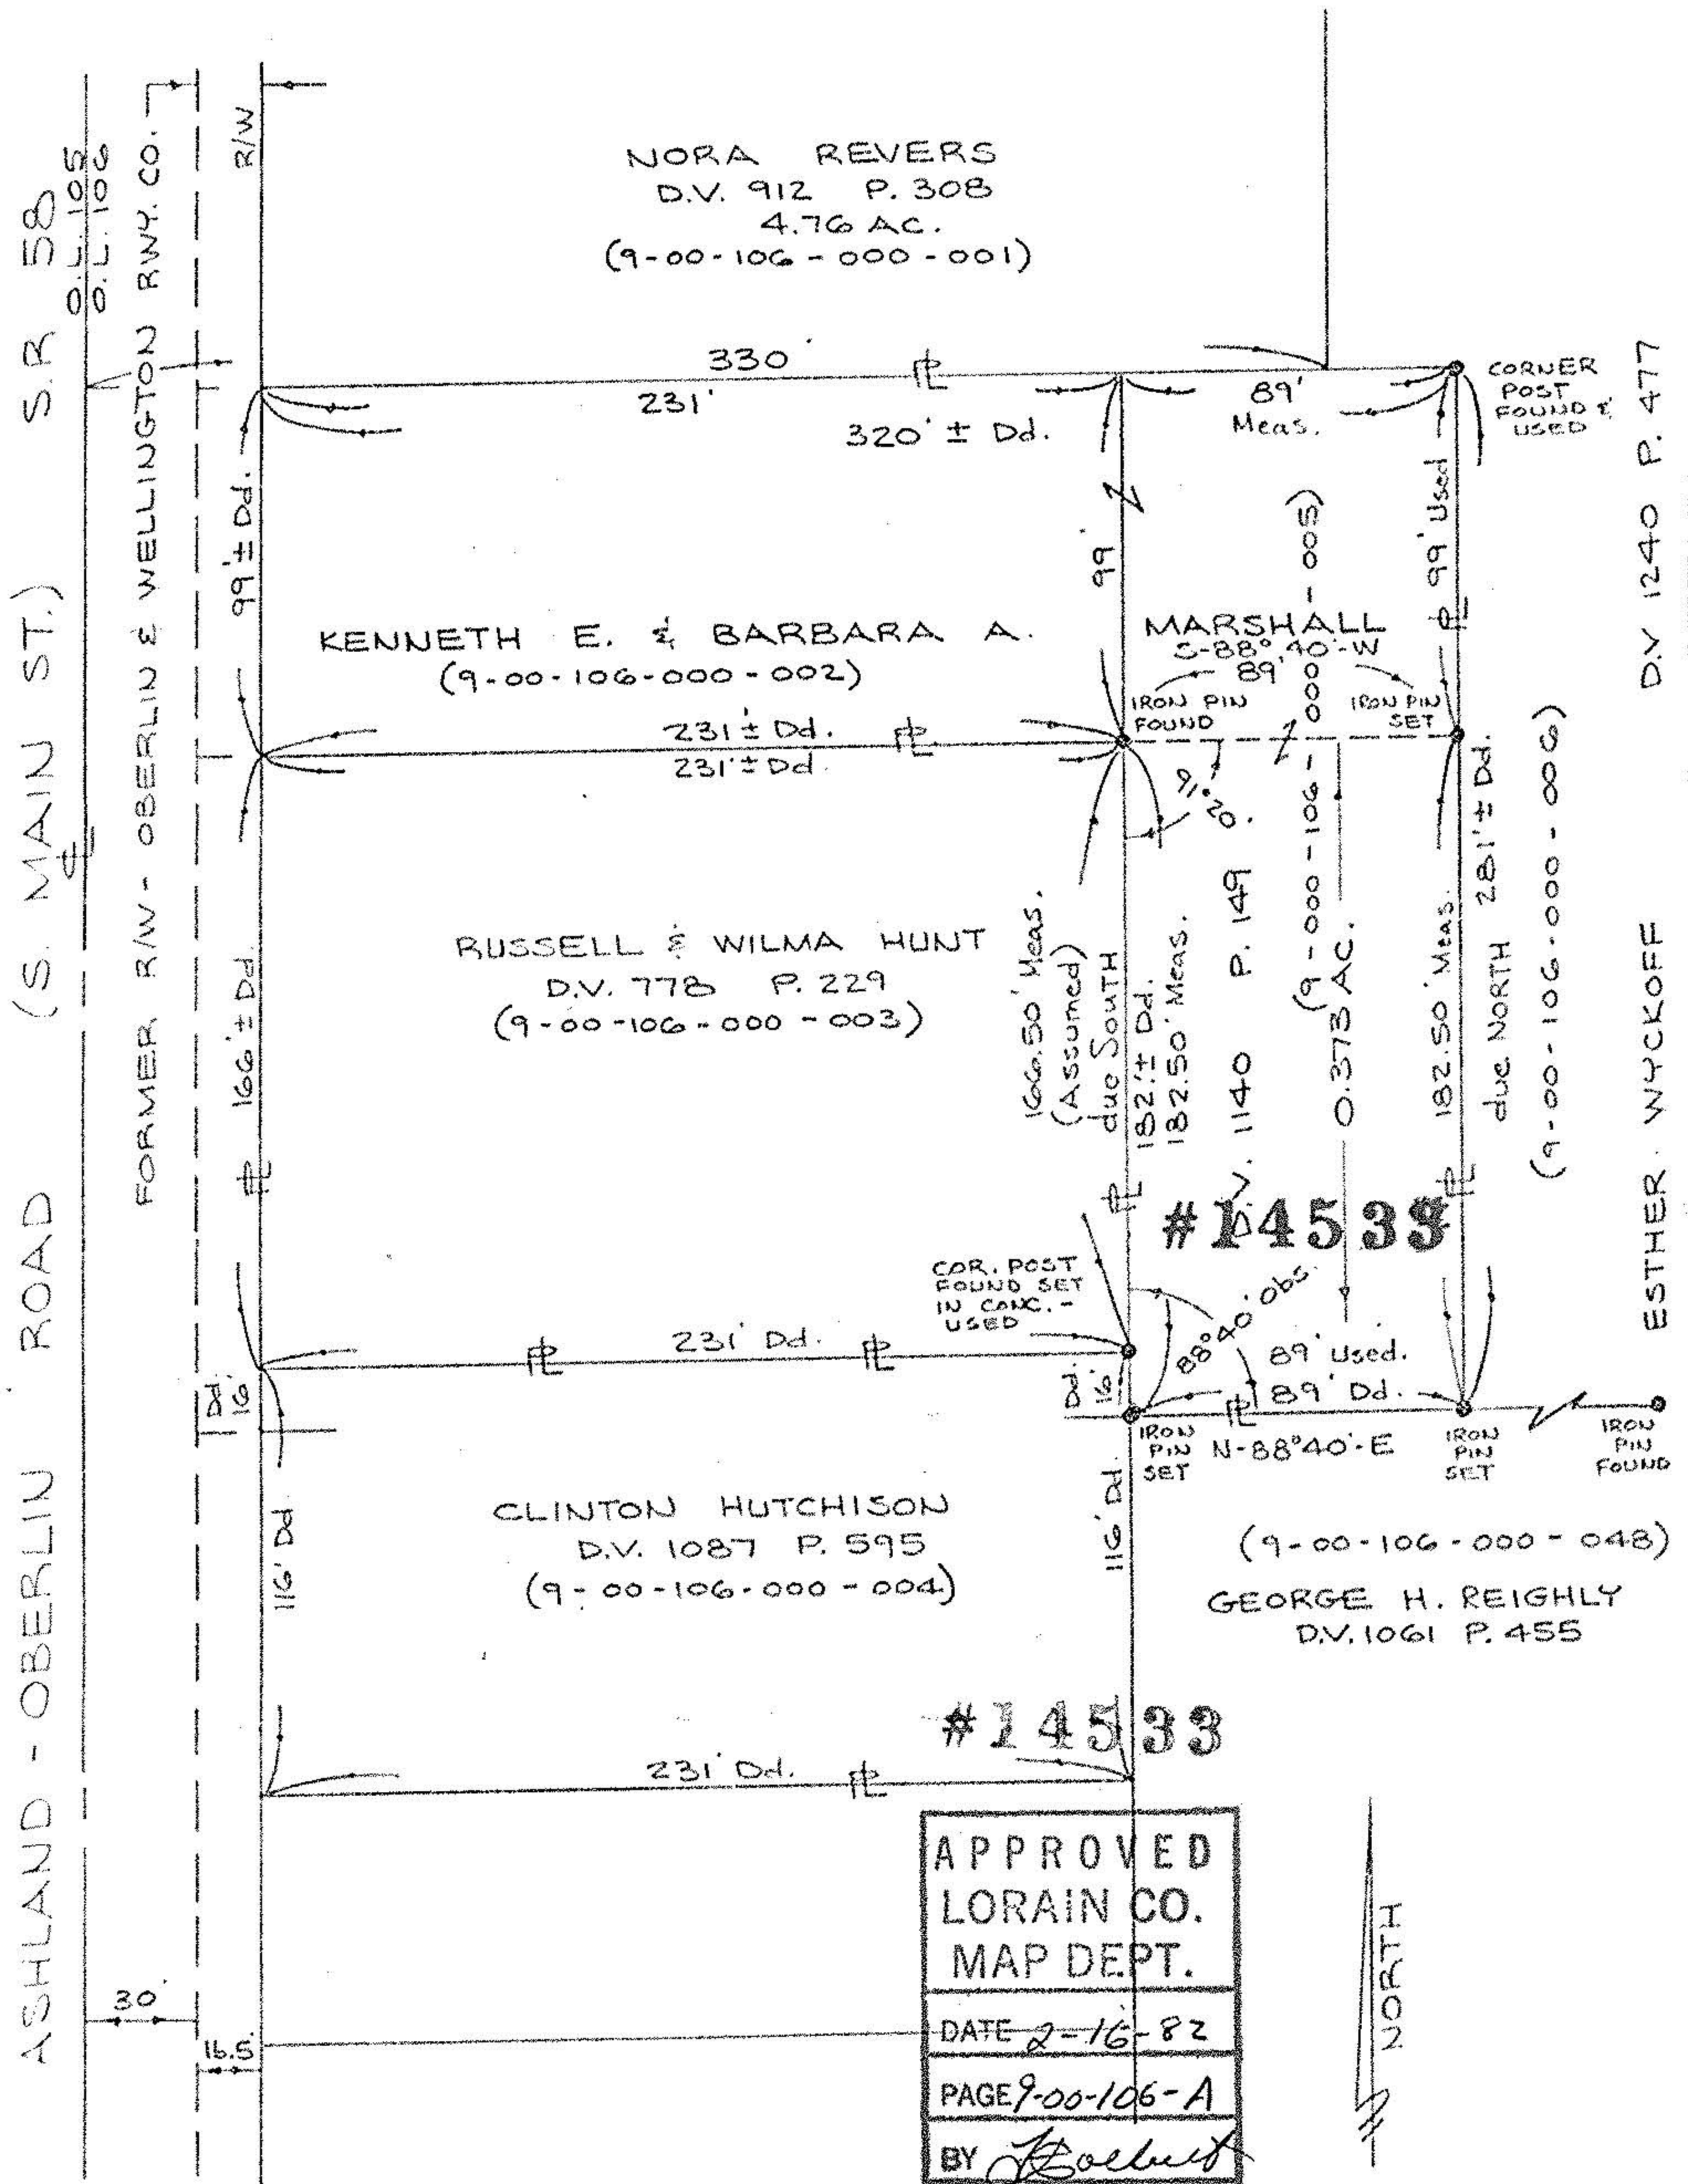

Prepared for: **RUSSELL HUNT**
 RTE. 58 S. OBERLIN, OHIO