


KLEINOEDER-SCHMIDT
and ASSOCIATES
ENGINEERS — SURVEYORS — CONSULTANTS in LAND PLANNING
OHIO
ELYRIA · NORWALK · MEDINA

SURVEY

Sublot(s) 984.3
Subd'n _____

Township CARLISLE Tract _____
Orig. Lots _____ Sec. 2
County of LORAIN State of Ohio
Corporation _____

10 B

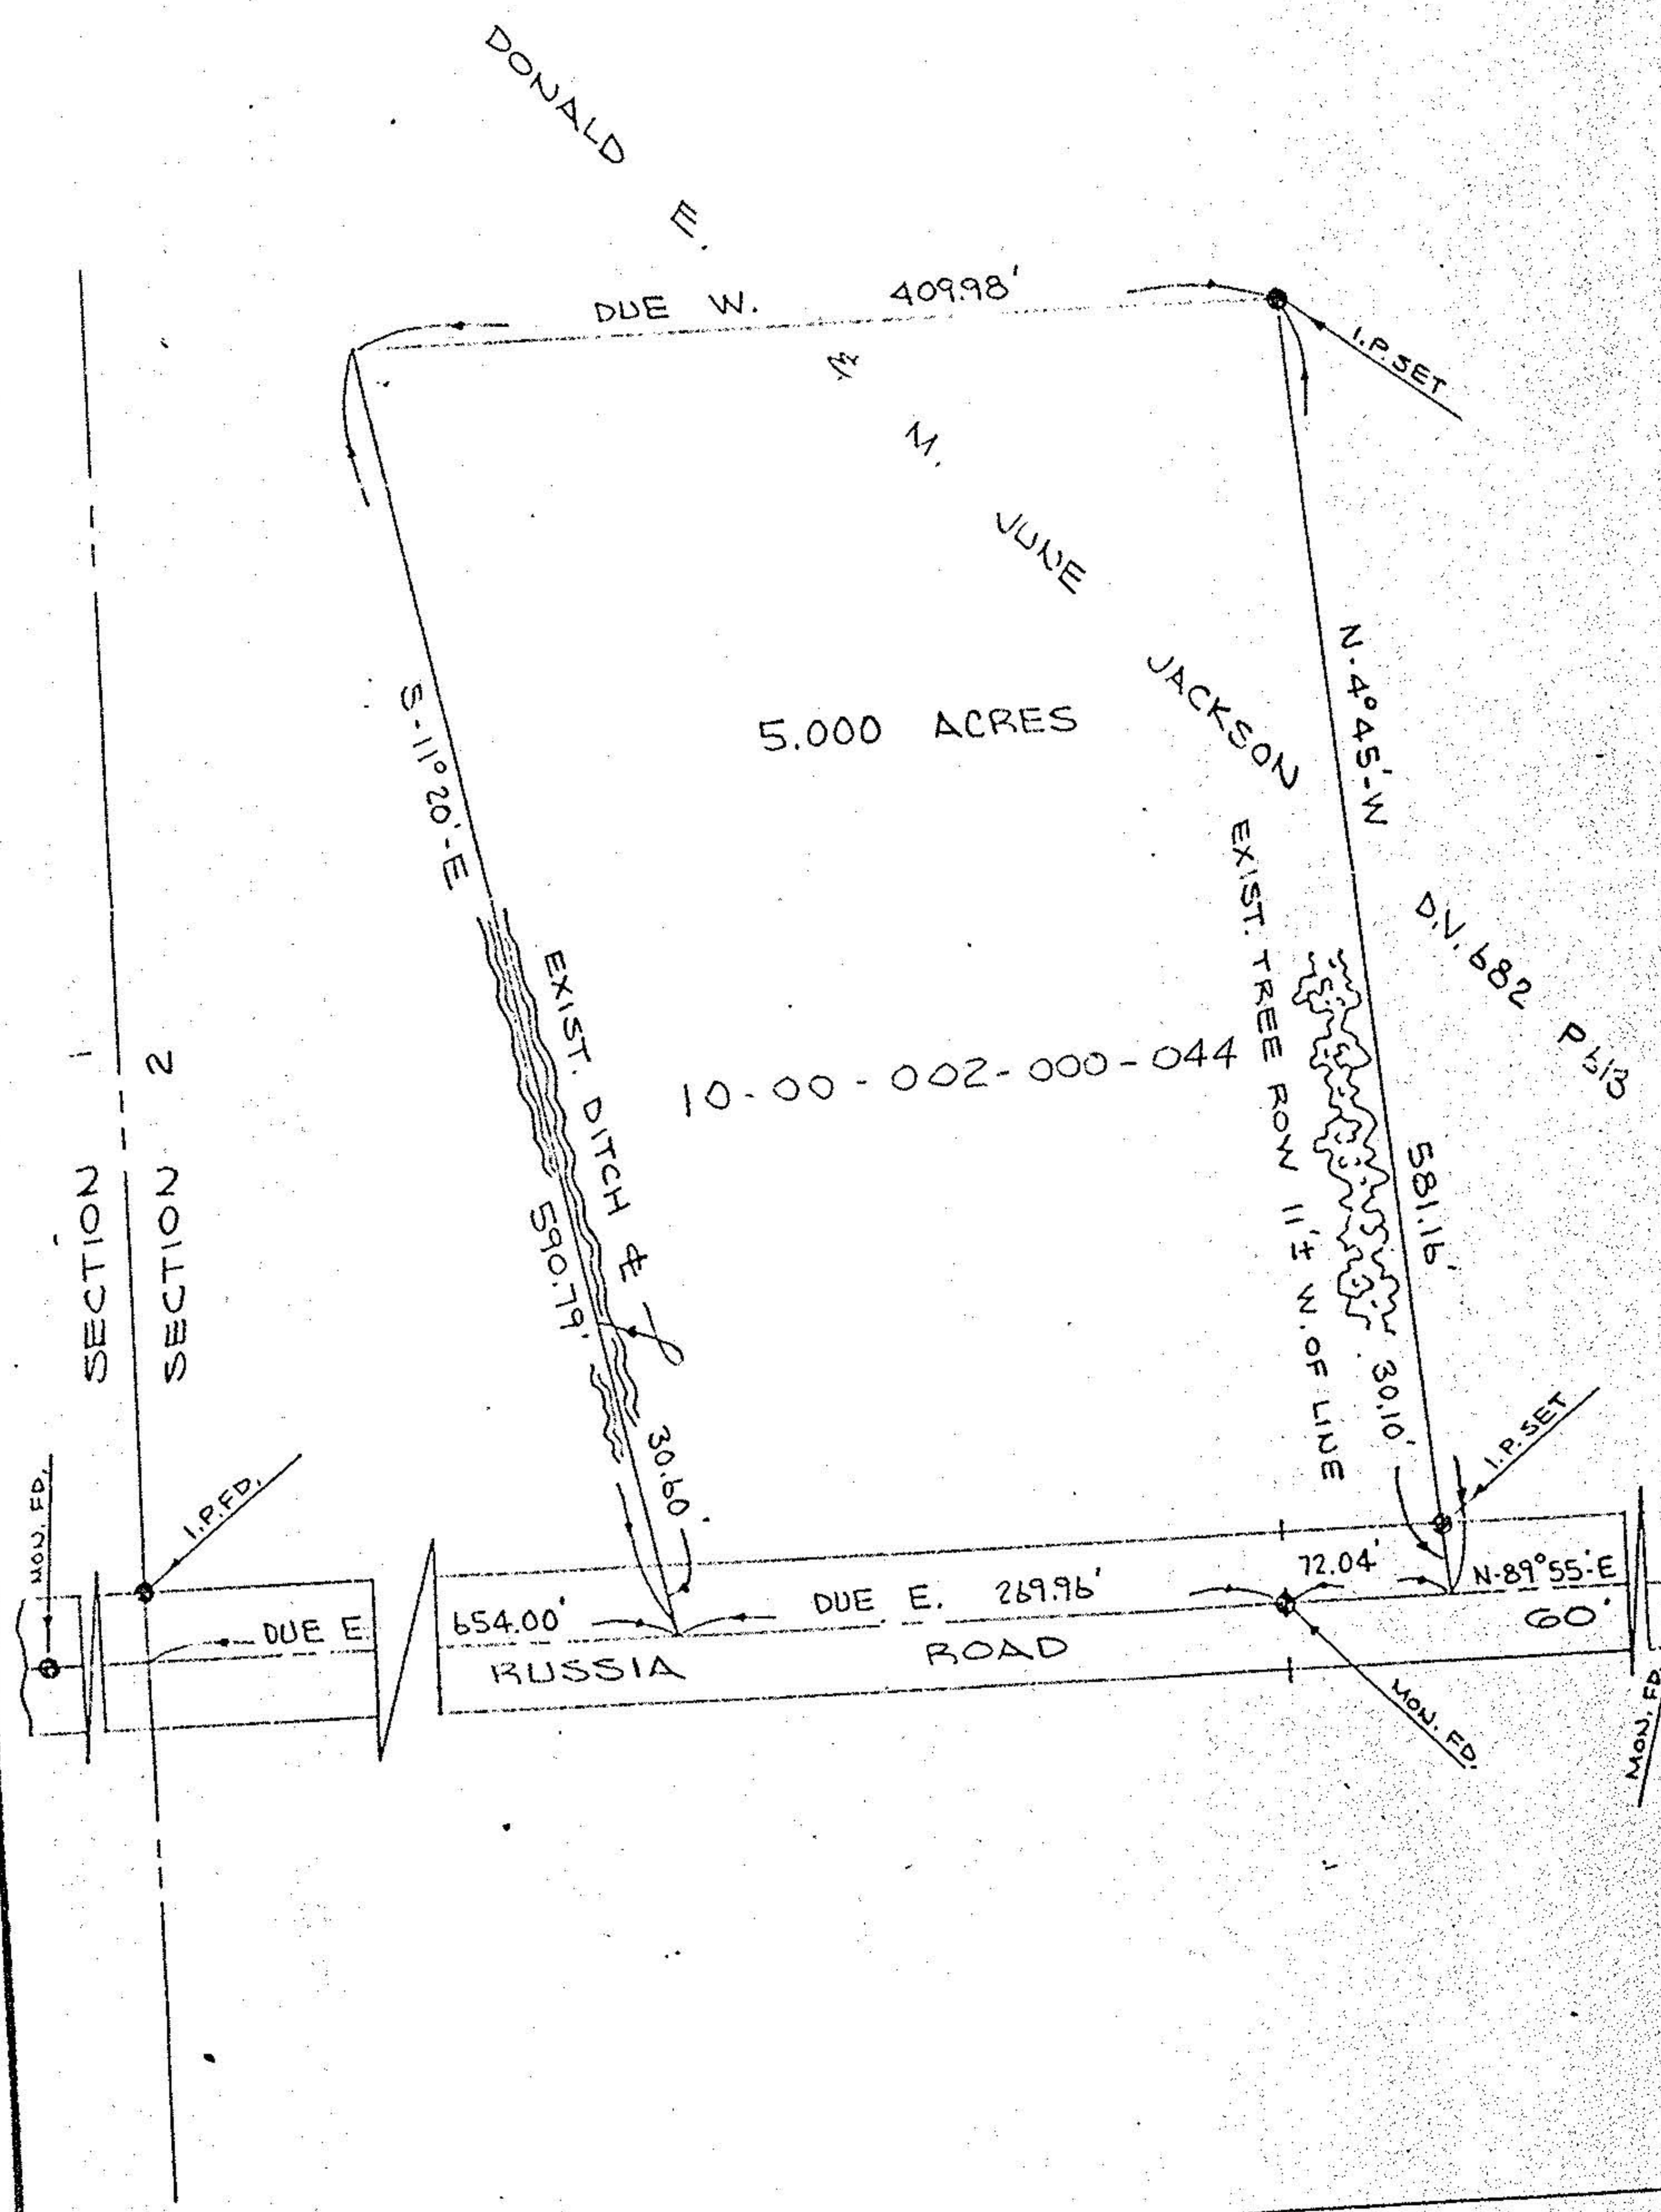

Prepared for: DONALD JACKSON