

LAUNDON • SIMON • CAHL and ASSOC.
ENGINEERS
504 MIDDLE AVE


SURVEYORS
ELYRIA, OHIO 4035

FOR: BARBARA BACSI ET AL

TOWNSHIP CARLISLE
ORIG. LOT or SEC. 5
CITY ELYRIA

VILLAGE
COUNTY LORAIN
STATE OHIO

DATE JULY 14, 1983
SCALE 1"=100'
JOB NO. 83-1206 F.B.

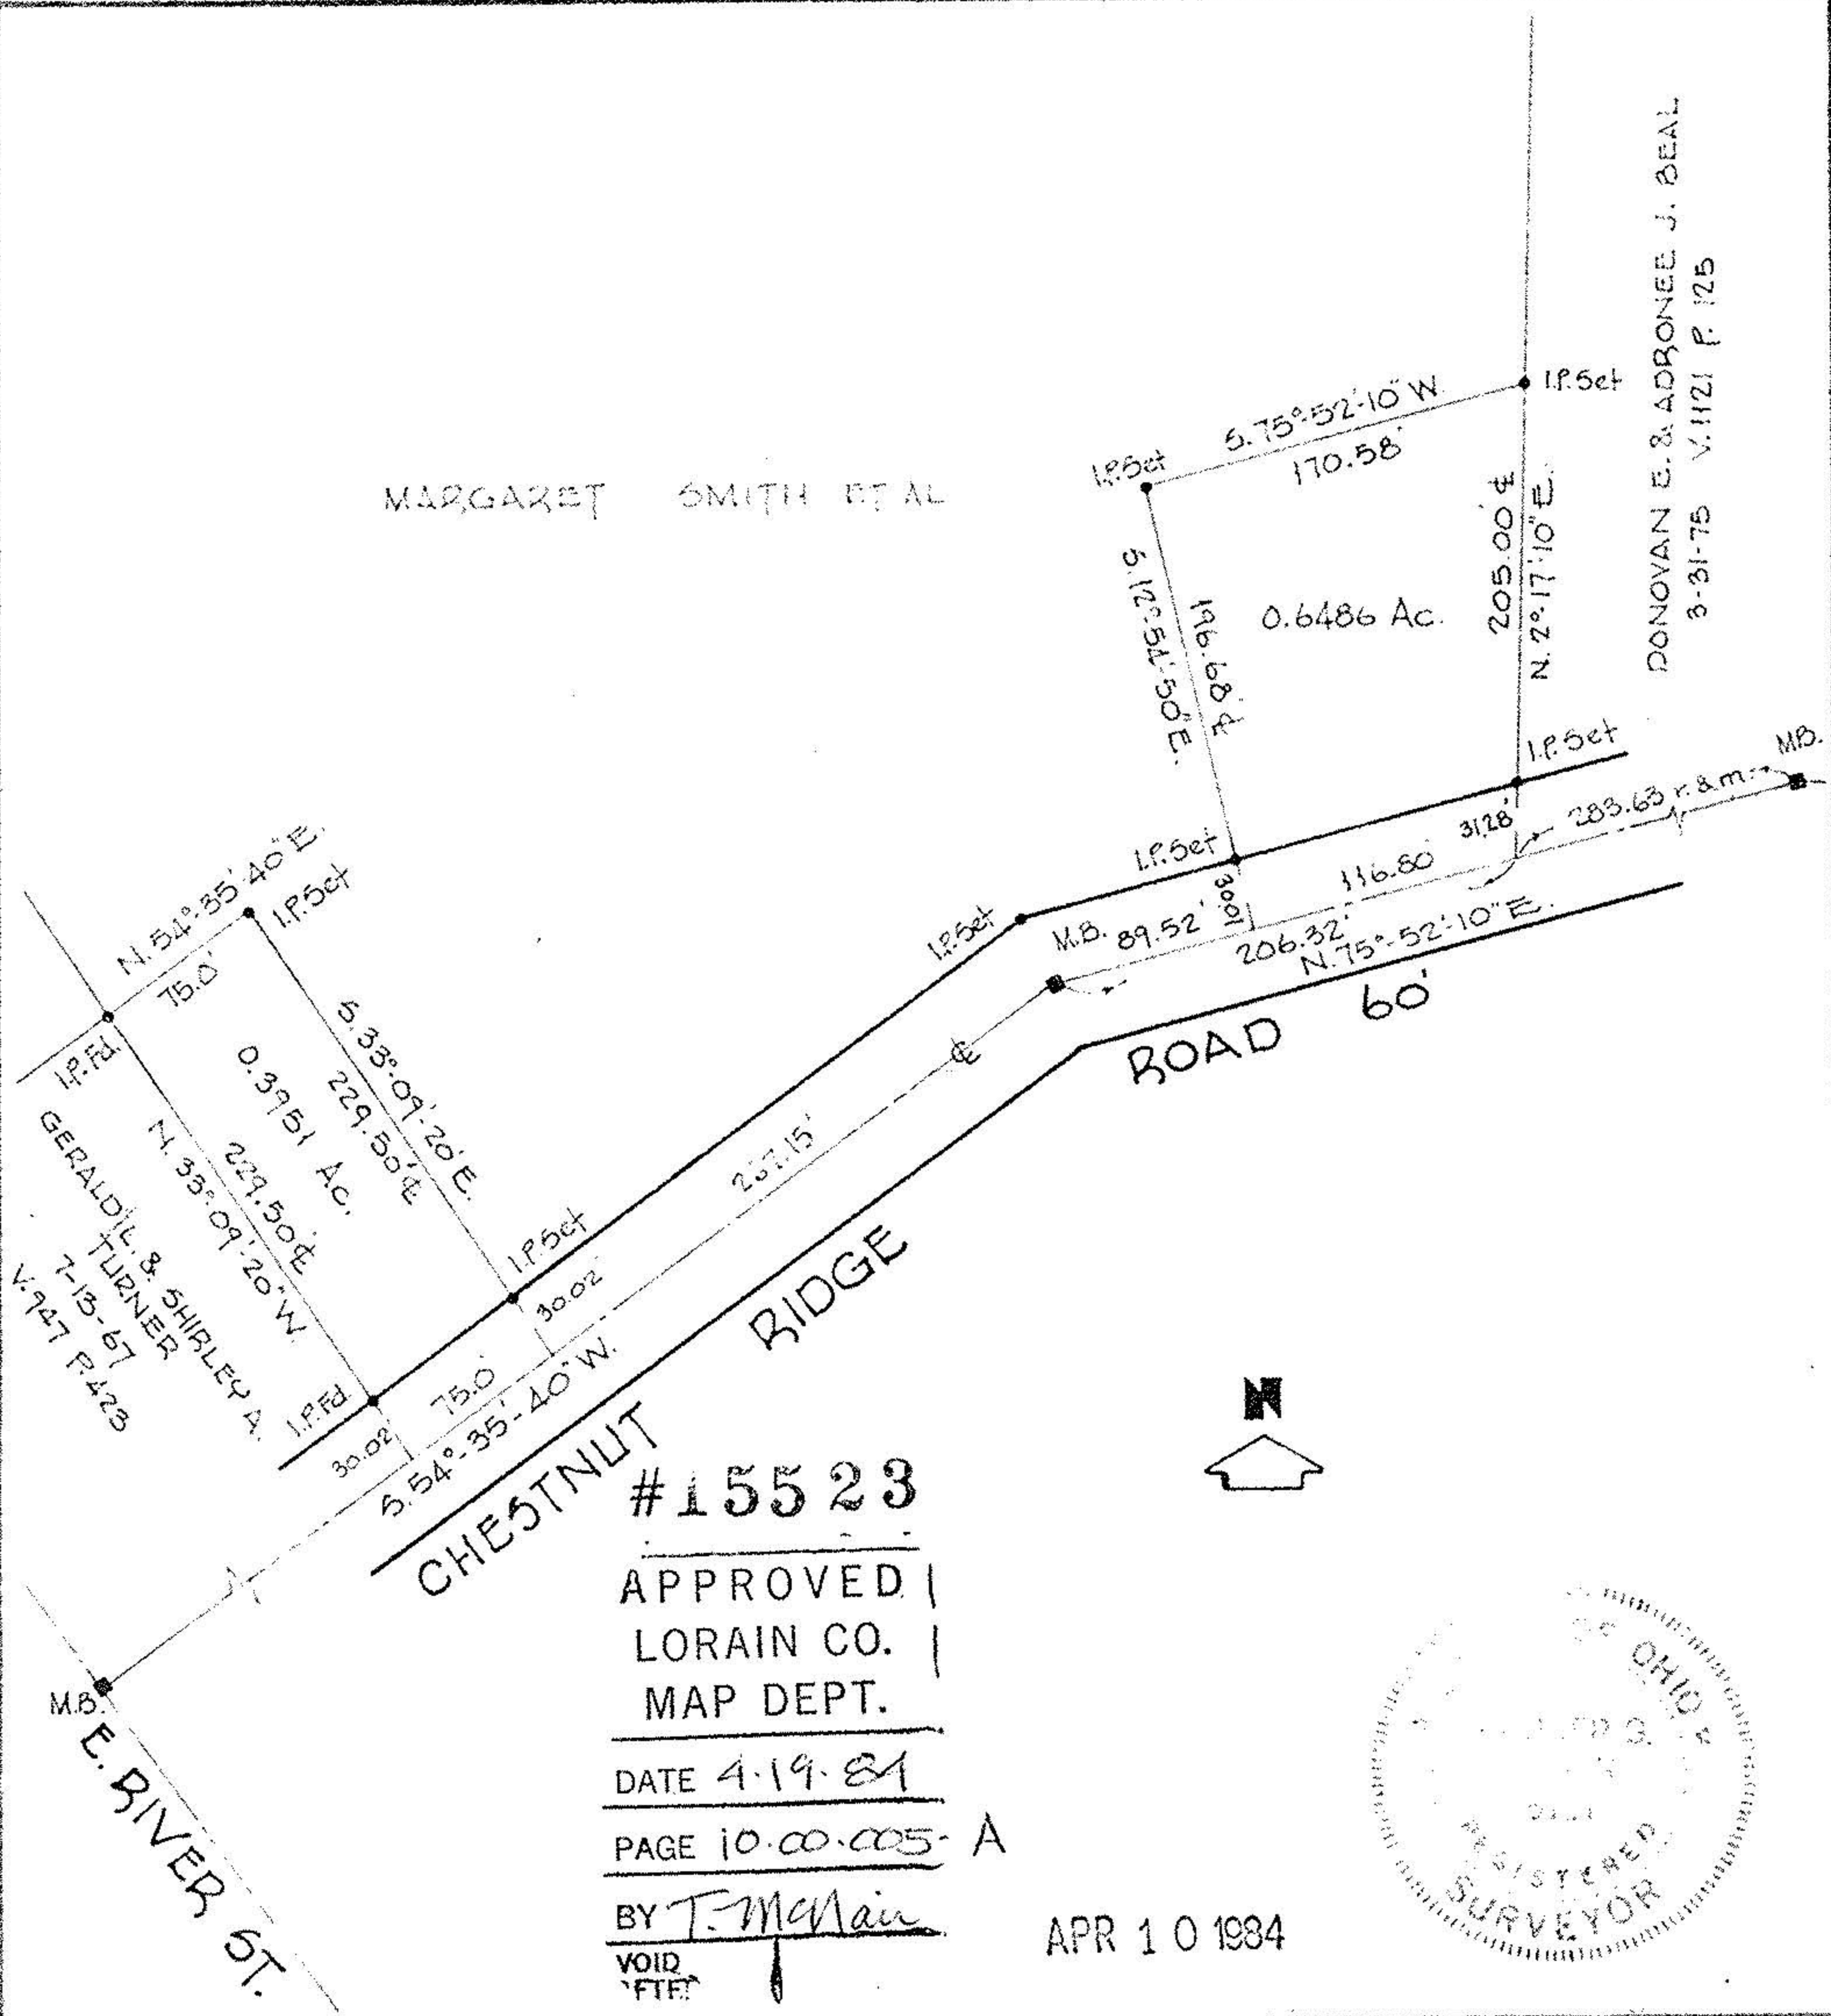

10-00-005-A
#15523
10-00-005-A