


#22662


APPROVED	
LORAIN CO.	
MAP DEPT.	
DATE 10-20-98	
PAGE 11 - F South	
BY TJS	
VOID AFTER	22662

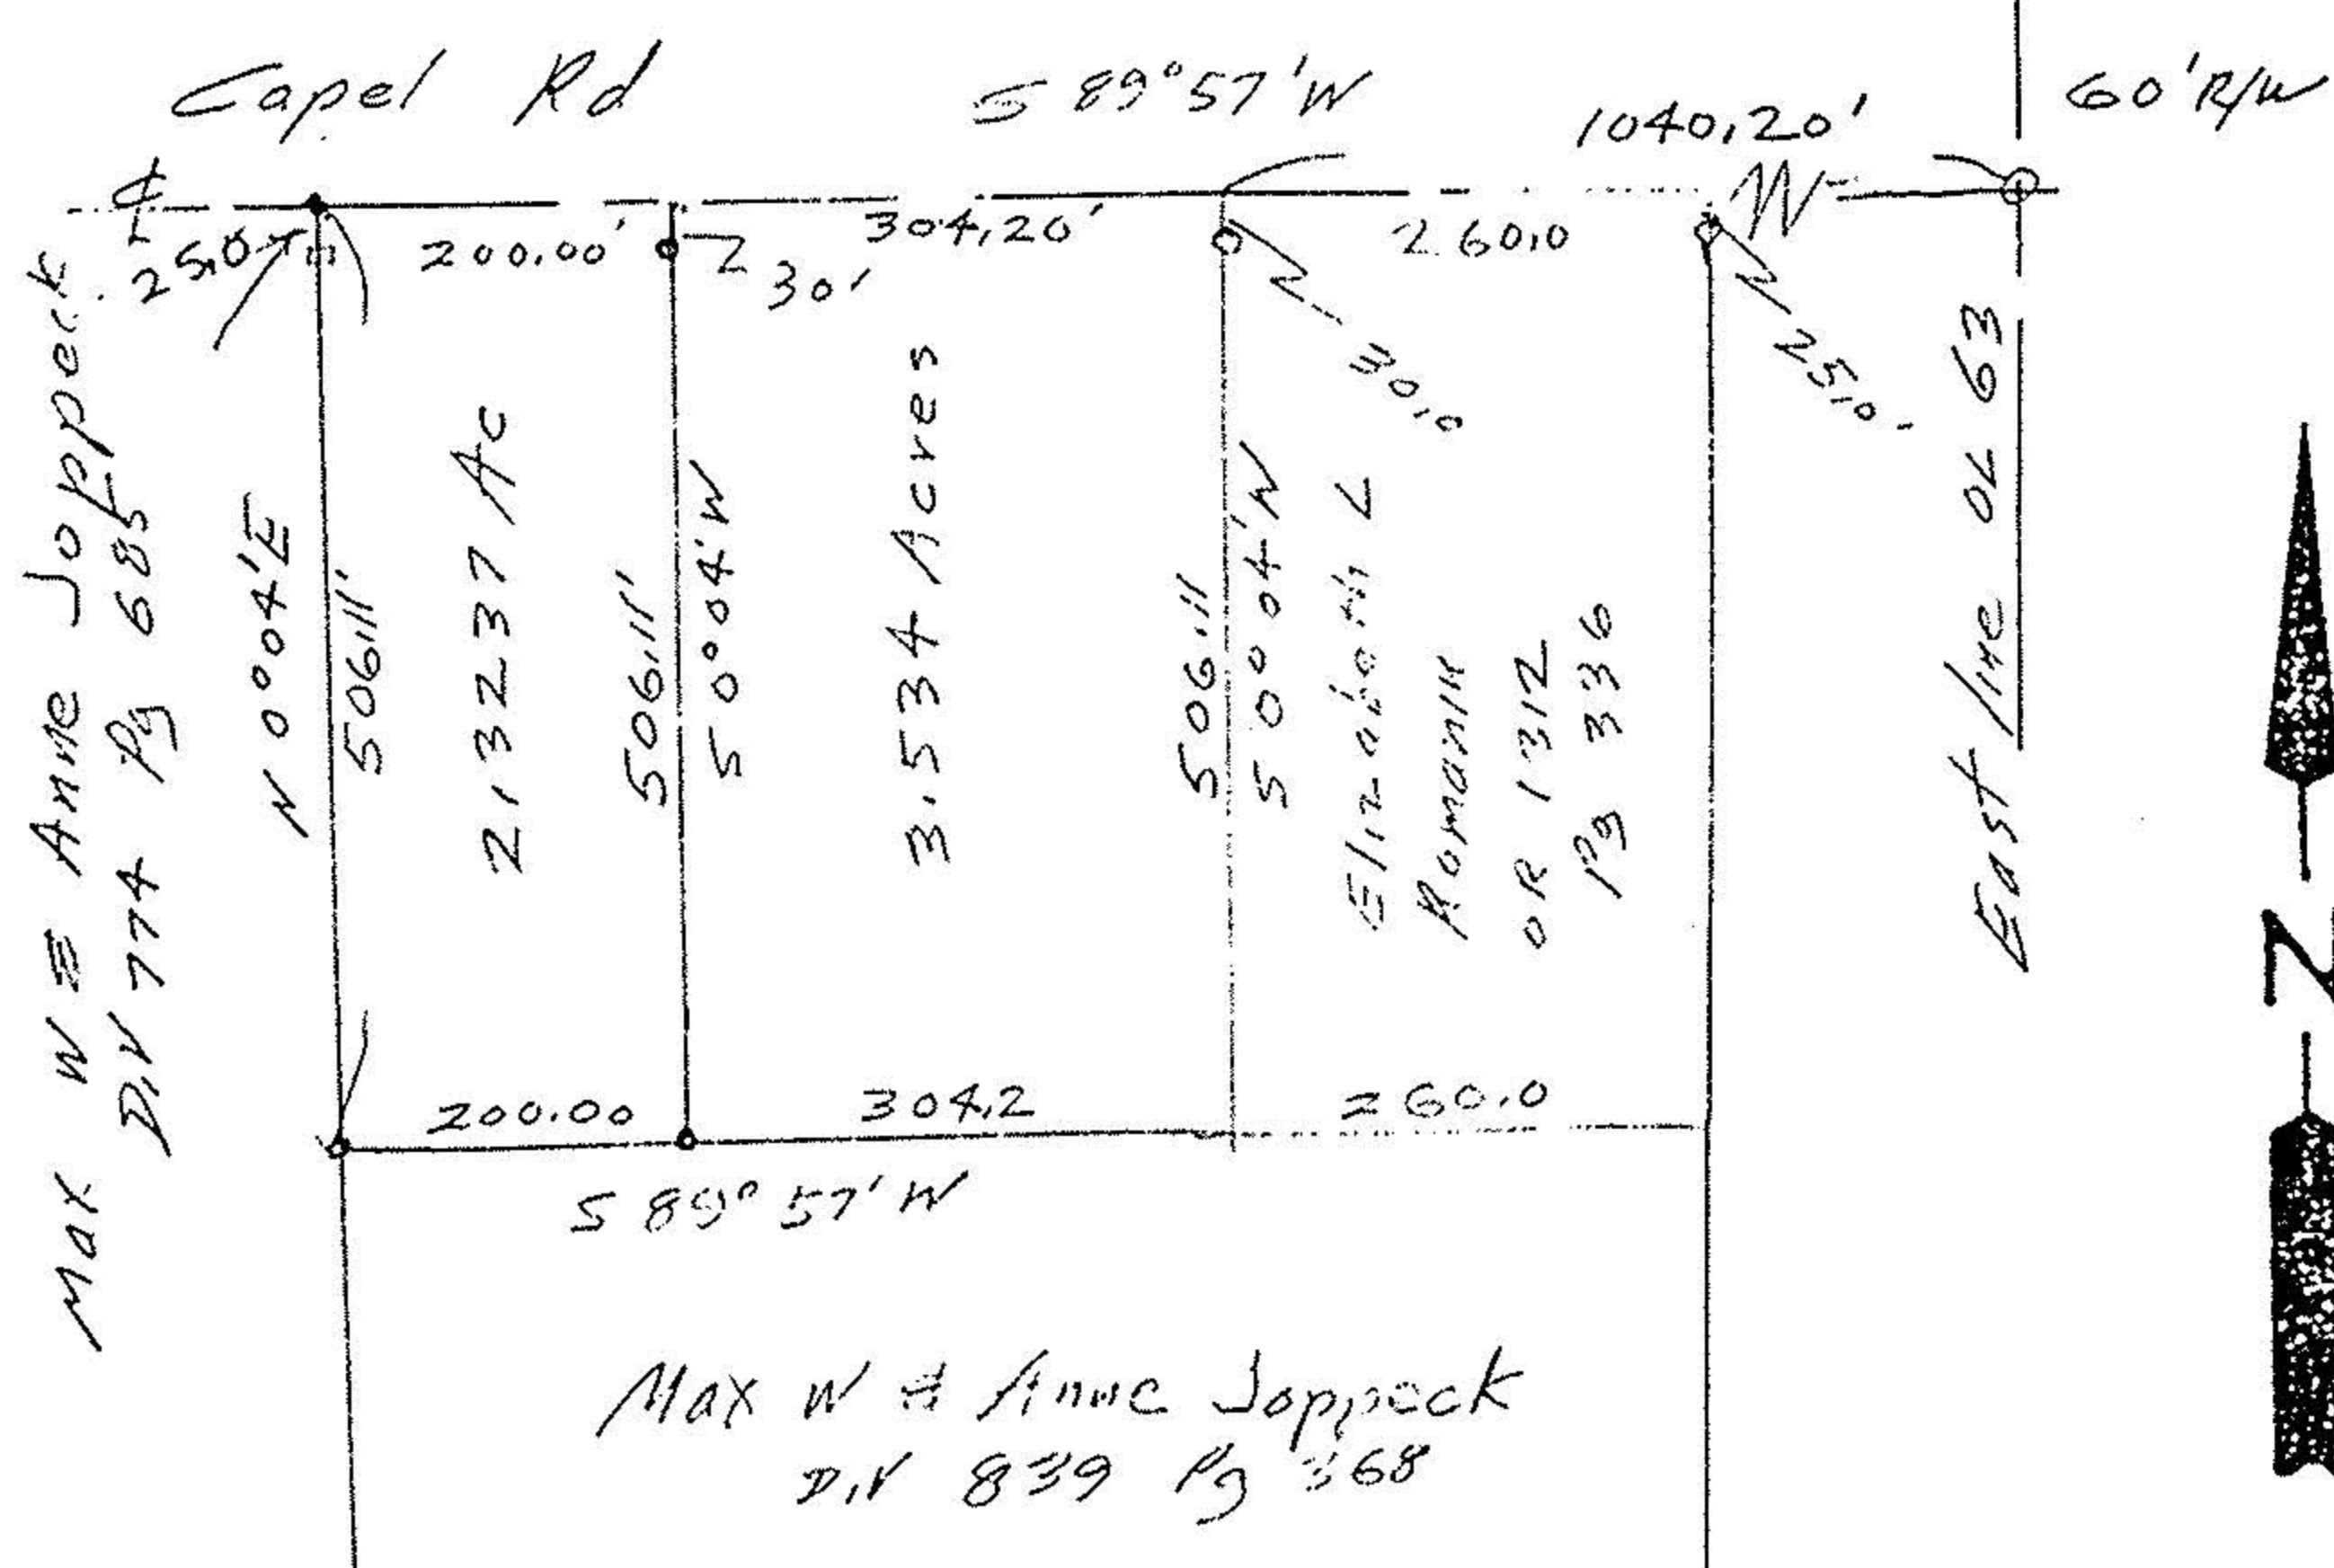

- Railroad tie
- iron pins fd
- iron pins set

owner
John J & Barbara A Knittel
Div 880 Pg 72

John Pozywak
Reg Surveyor 529

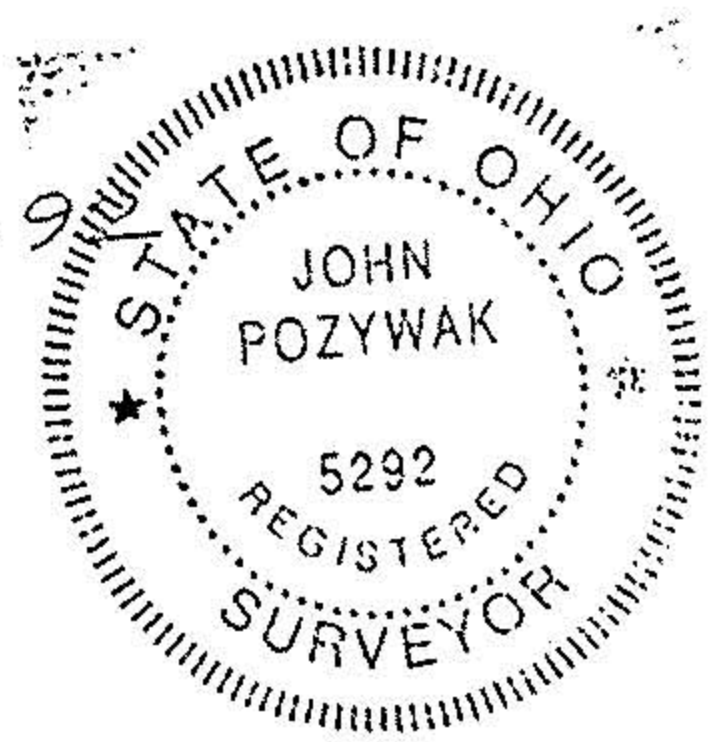

Survey of Parcel split
original Lot 63
Eaton Township

Lorain County Ohio
Scale 1" = 200 June 1998