




DATE MAY 1990
SCALE: 1"=100'

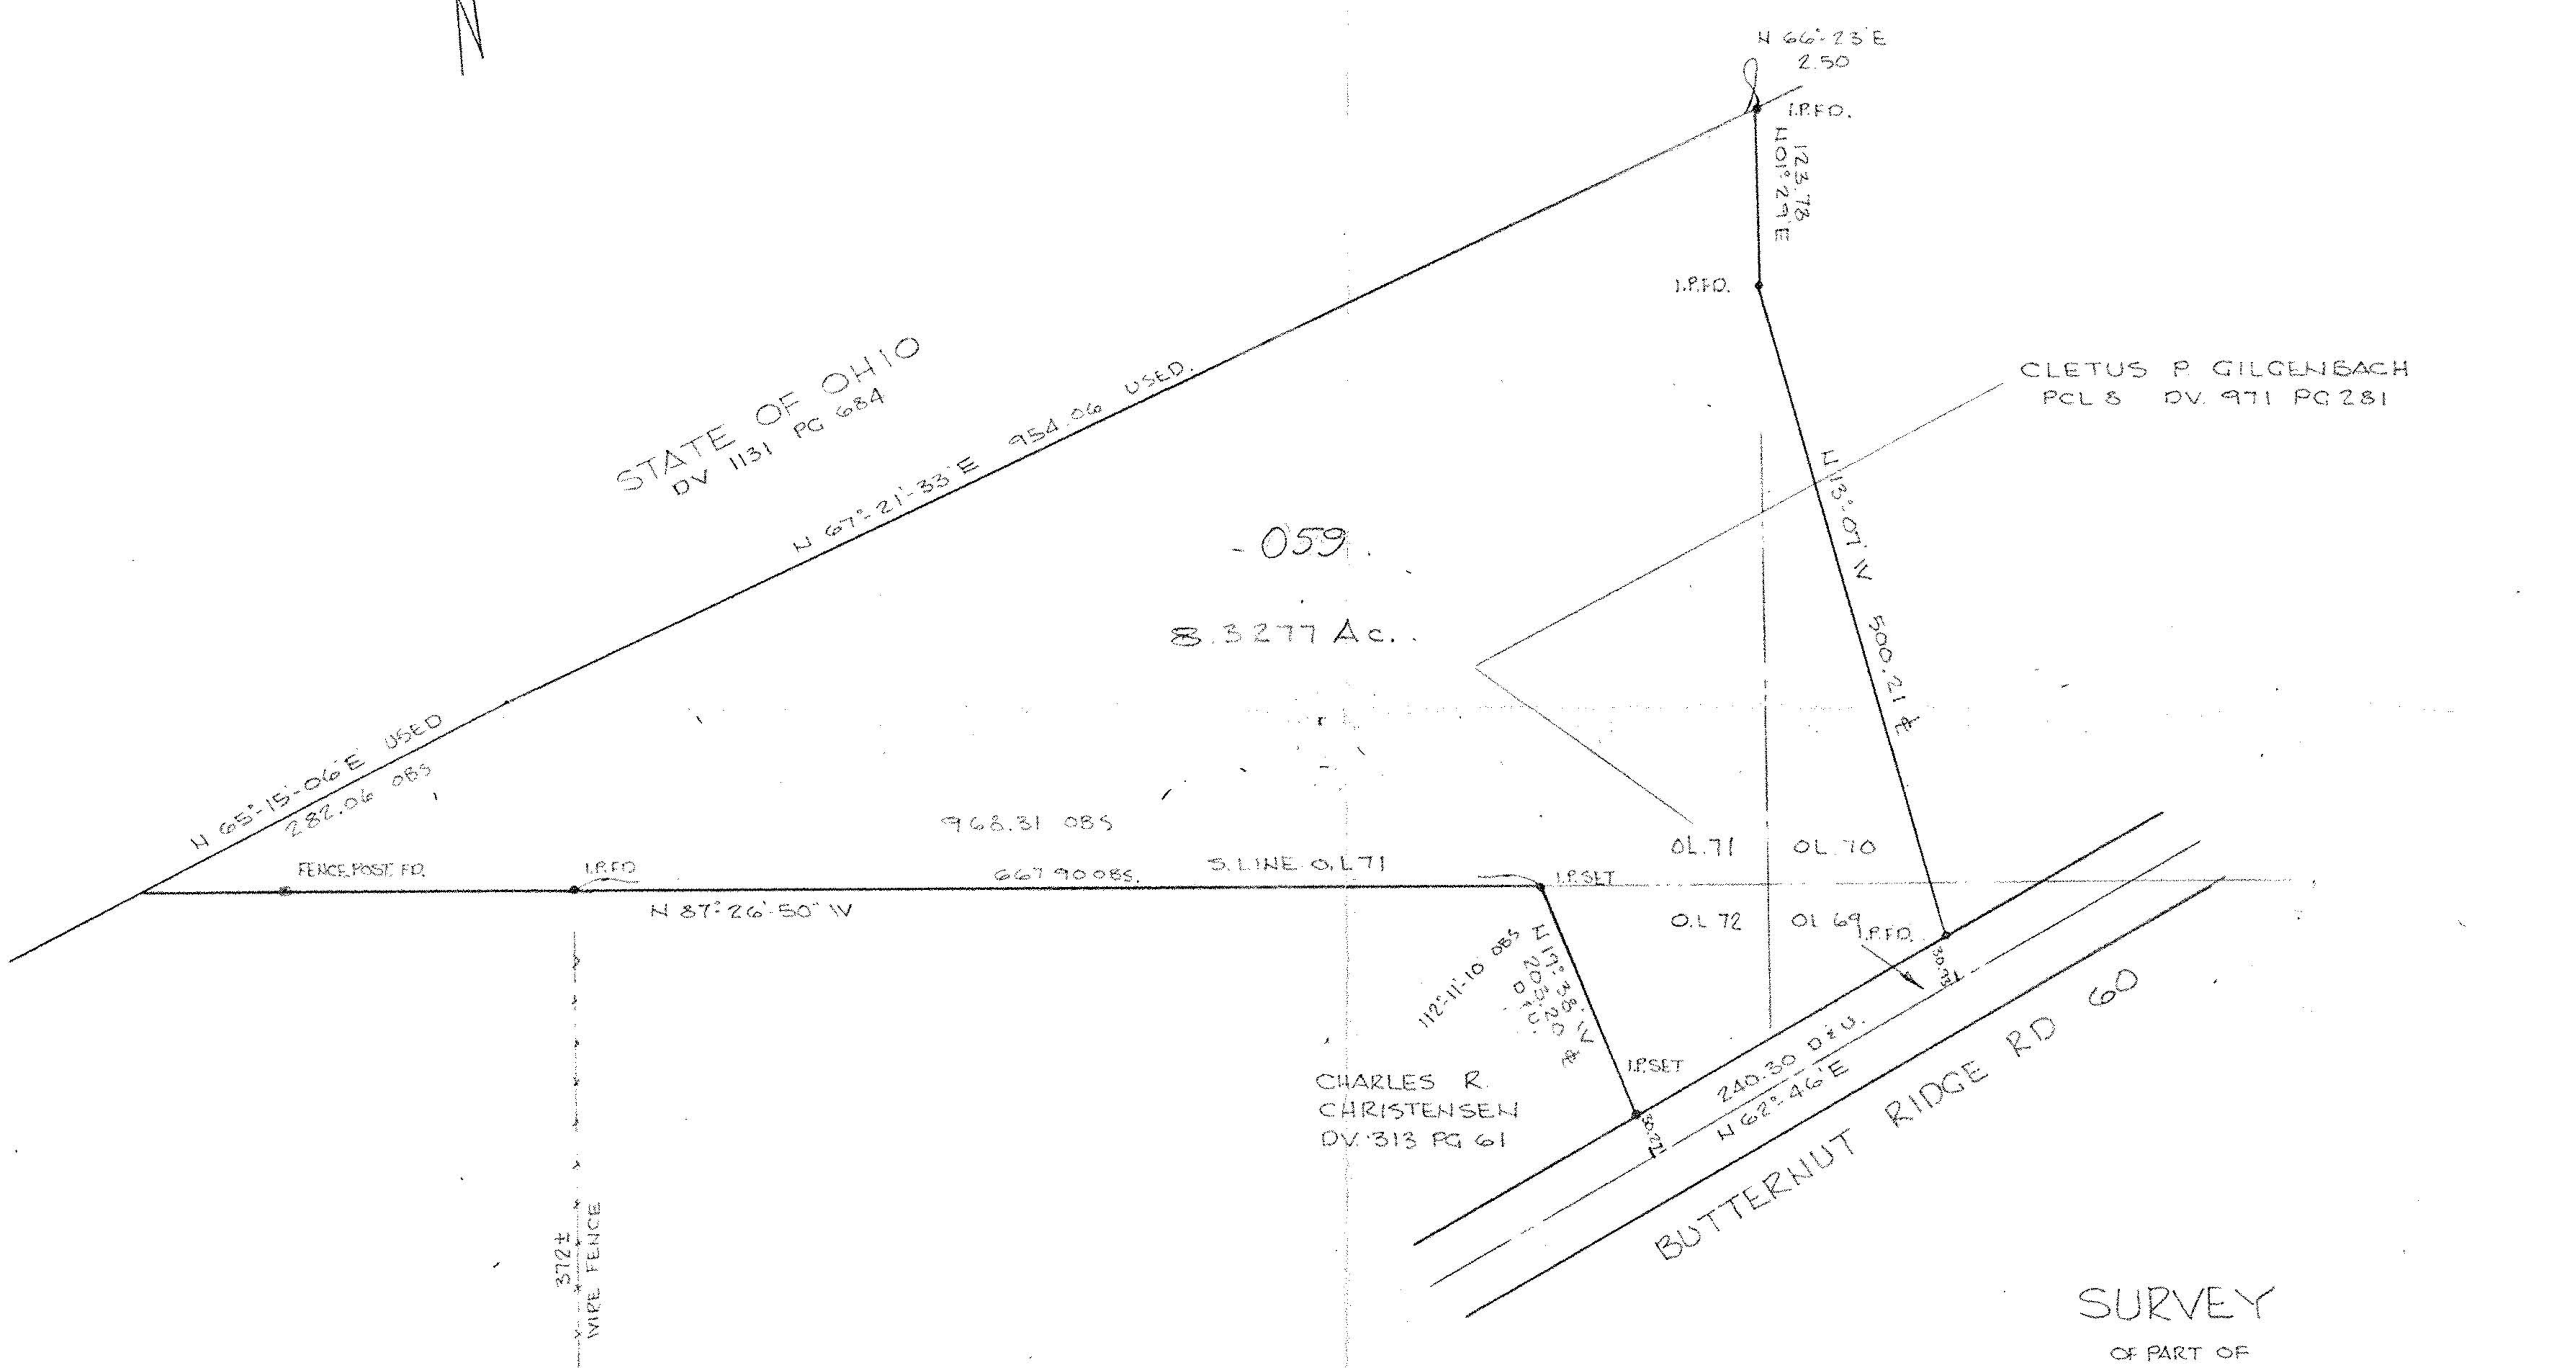

STATE OF OHIO
DV 1131 PG 684

CLETUS P GILGENBACH
PCL 8 DV. 971 PG 281

CHARLES R.
CHRISTENSEN
DV 313 PG 61

- 059
8.3277 Ac.

BUTTERNUT RIDGE RD 60

ACREAGE	
OL 69	0.29 AC.
OL 70	0.52 AC.
OL 71	7.00 AC.
OL 72	0.51 AC.

PREPARED FOR
JEFF MOULD
9405 ISLAND RD.



SURVEY
OF PART OF
ORIGINAL EATON
TWP LOTS 69, 70, 71 & 72

COUNTY OF LORAIN STATE OF OHIO

#18940A

APPROVED	
LORAIN CO.	
MAP DEPT.	
DATE 5-8-90	
PAGE 11-00-071B	
BY CAROLYN FRANCIS	
VOID	
AFTER	

11-00-071-000

8647