


MAP OF SURVEY FOR DON ANDERSON
 O.L. 74 - EATON TWP. - LORAIN CO.
 NOV. 1988 SCALE 1"=100'
 JOHN R. HAMILTON REG. SURV. #6861

#18225

APPROVED	
LORAIN CO.	
MAP DEPT.	
DATE 11-22-88	
PAGE 11-00-074-A	
BY T-McMair	
VOID AFTER	18225

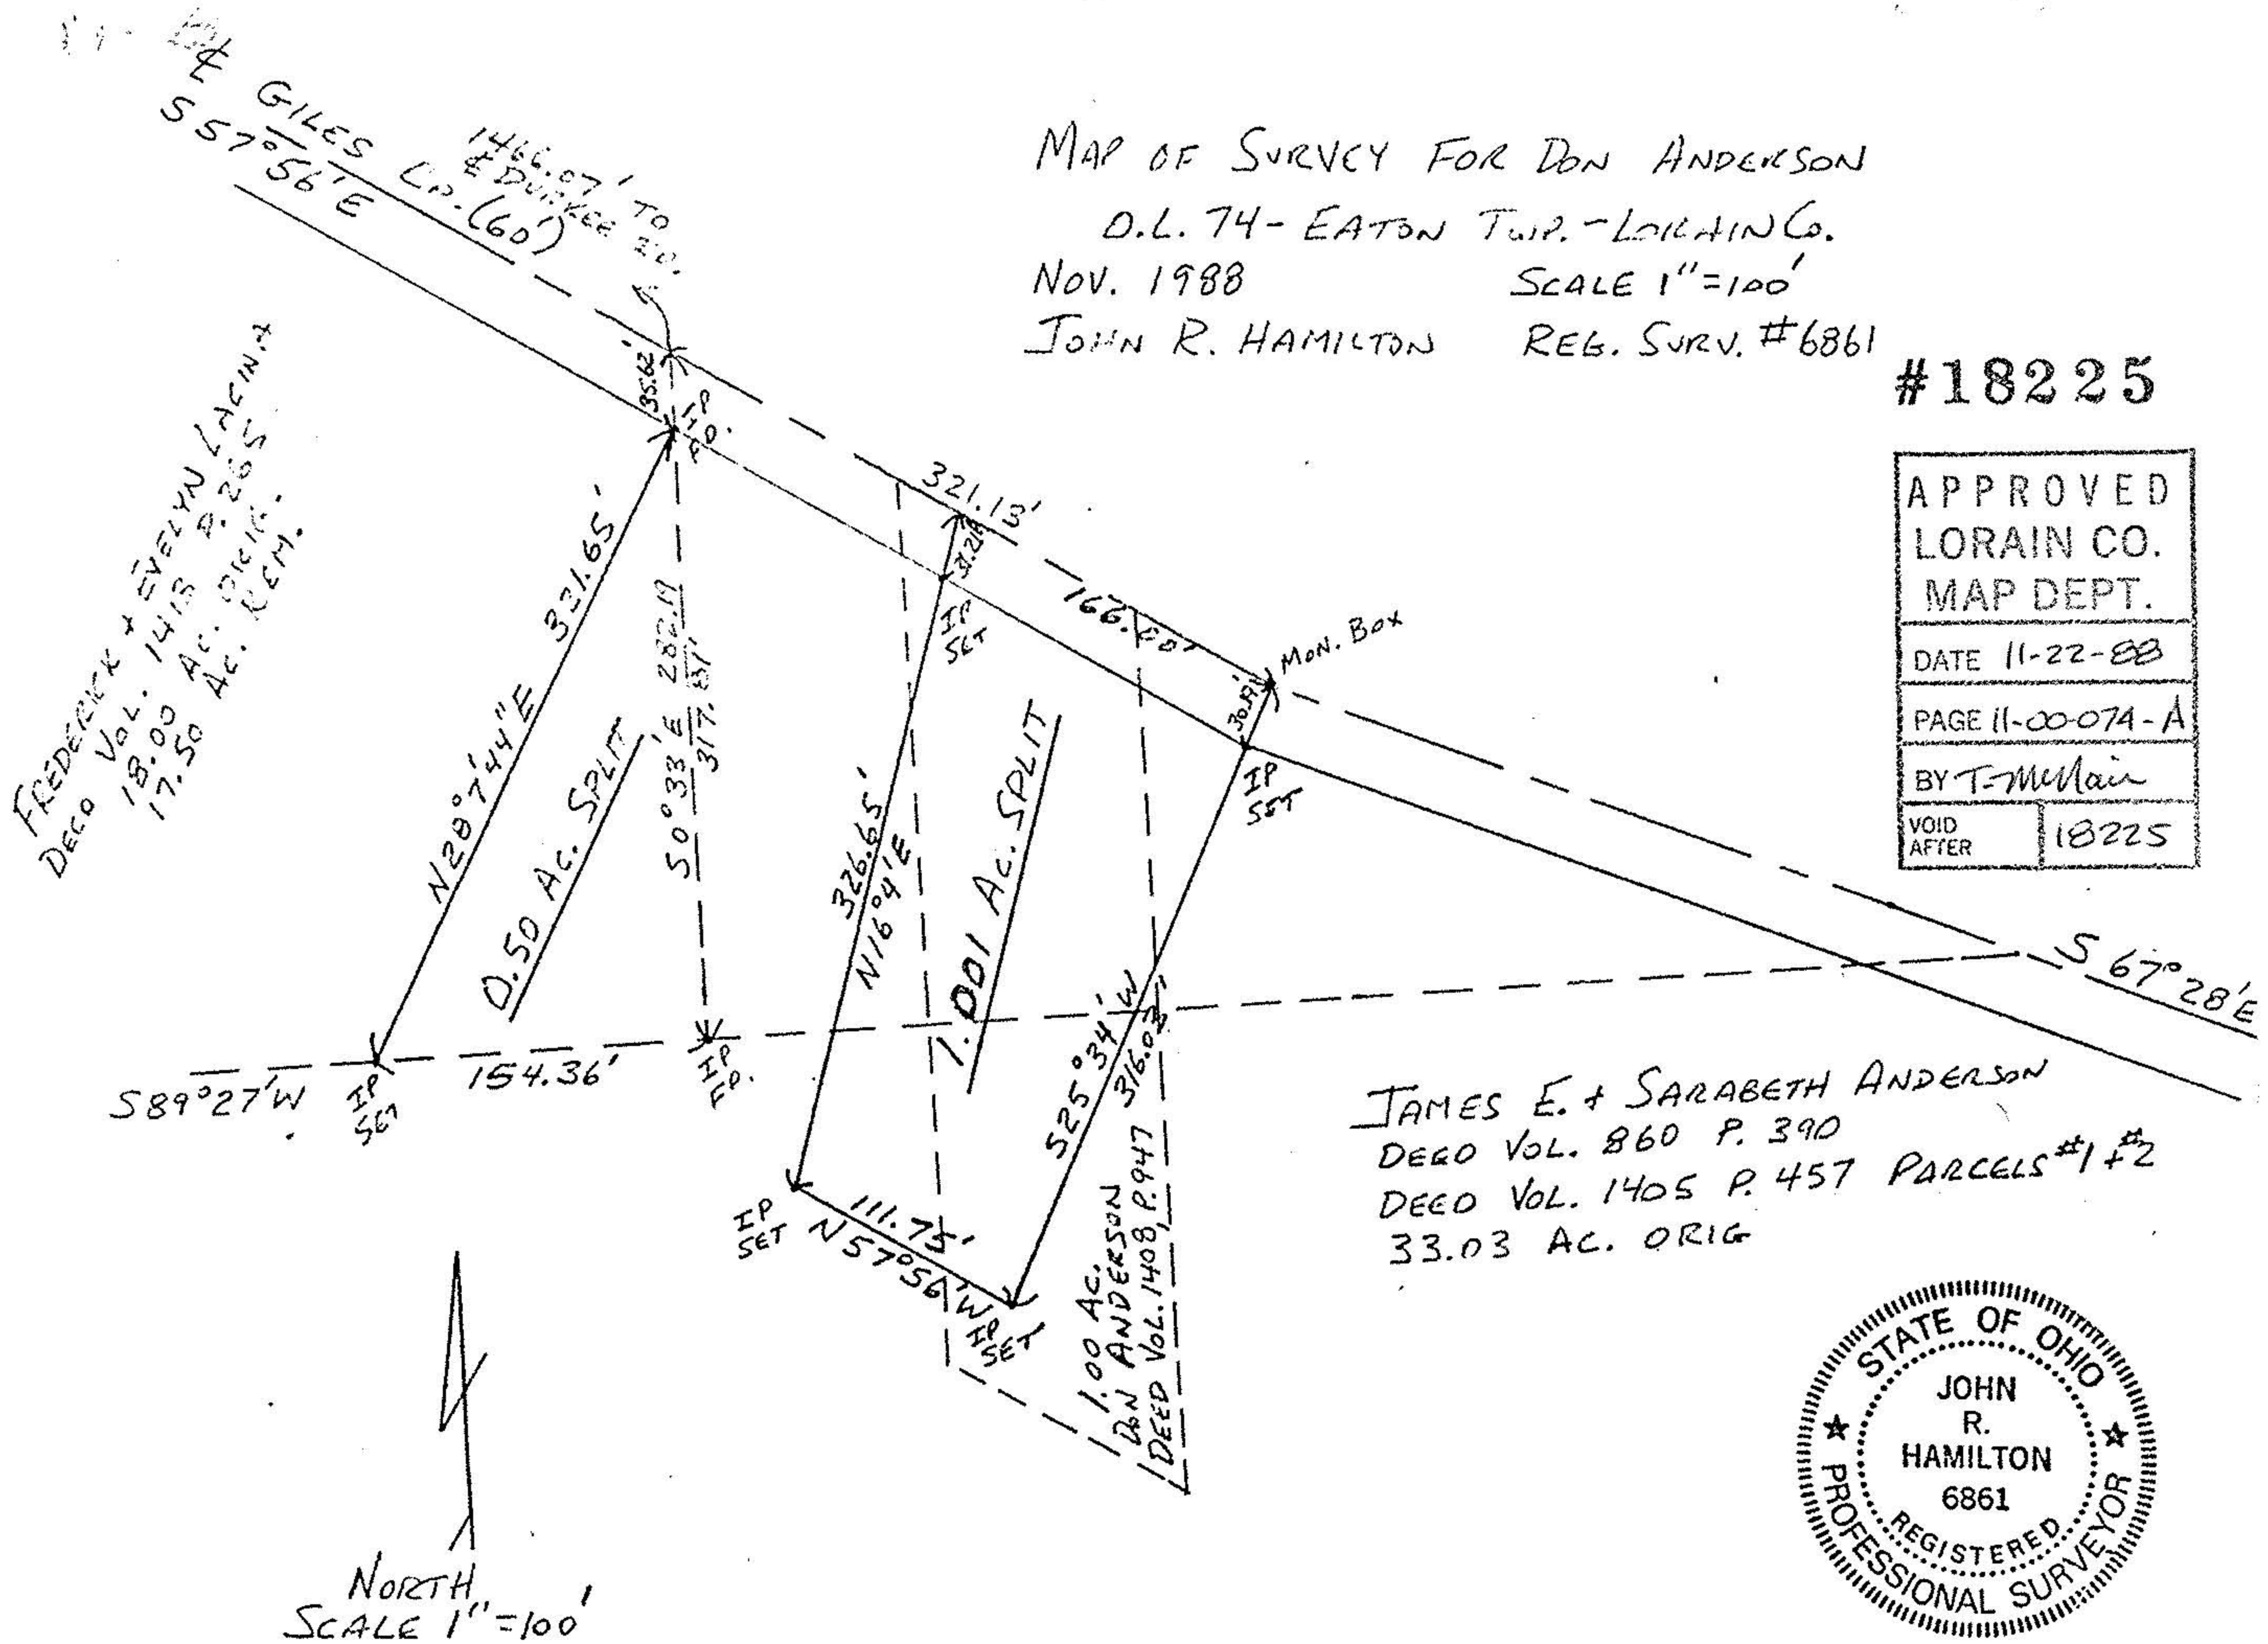

JAMES E. + SARABETH ANDERSON
 DEED VOL. 860 P. 390
 DEED VOL. 1405 P. 457 PARCELS #1 + #2
 33.03 AC. ORIG

