


Anna Hronec
D. Vol. 378 Pg 528

Steve Hronec

Paula & Mildred Sievert
D. Vol 426 Pg. 578 Oct. 18-1947

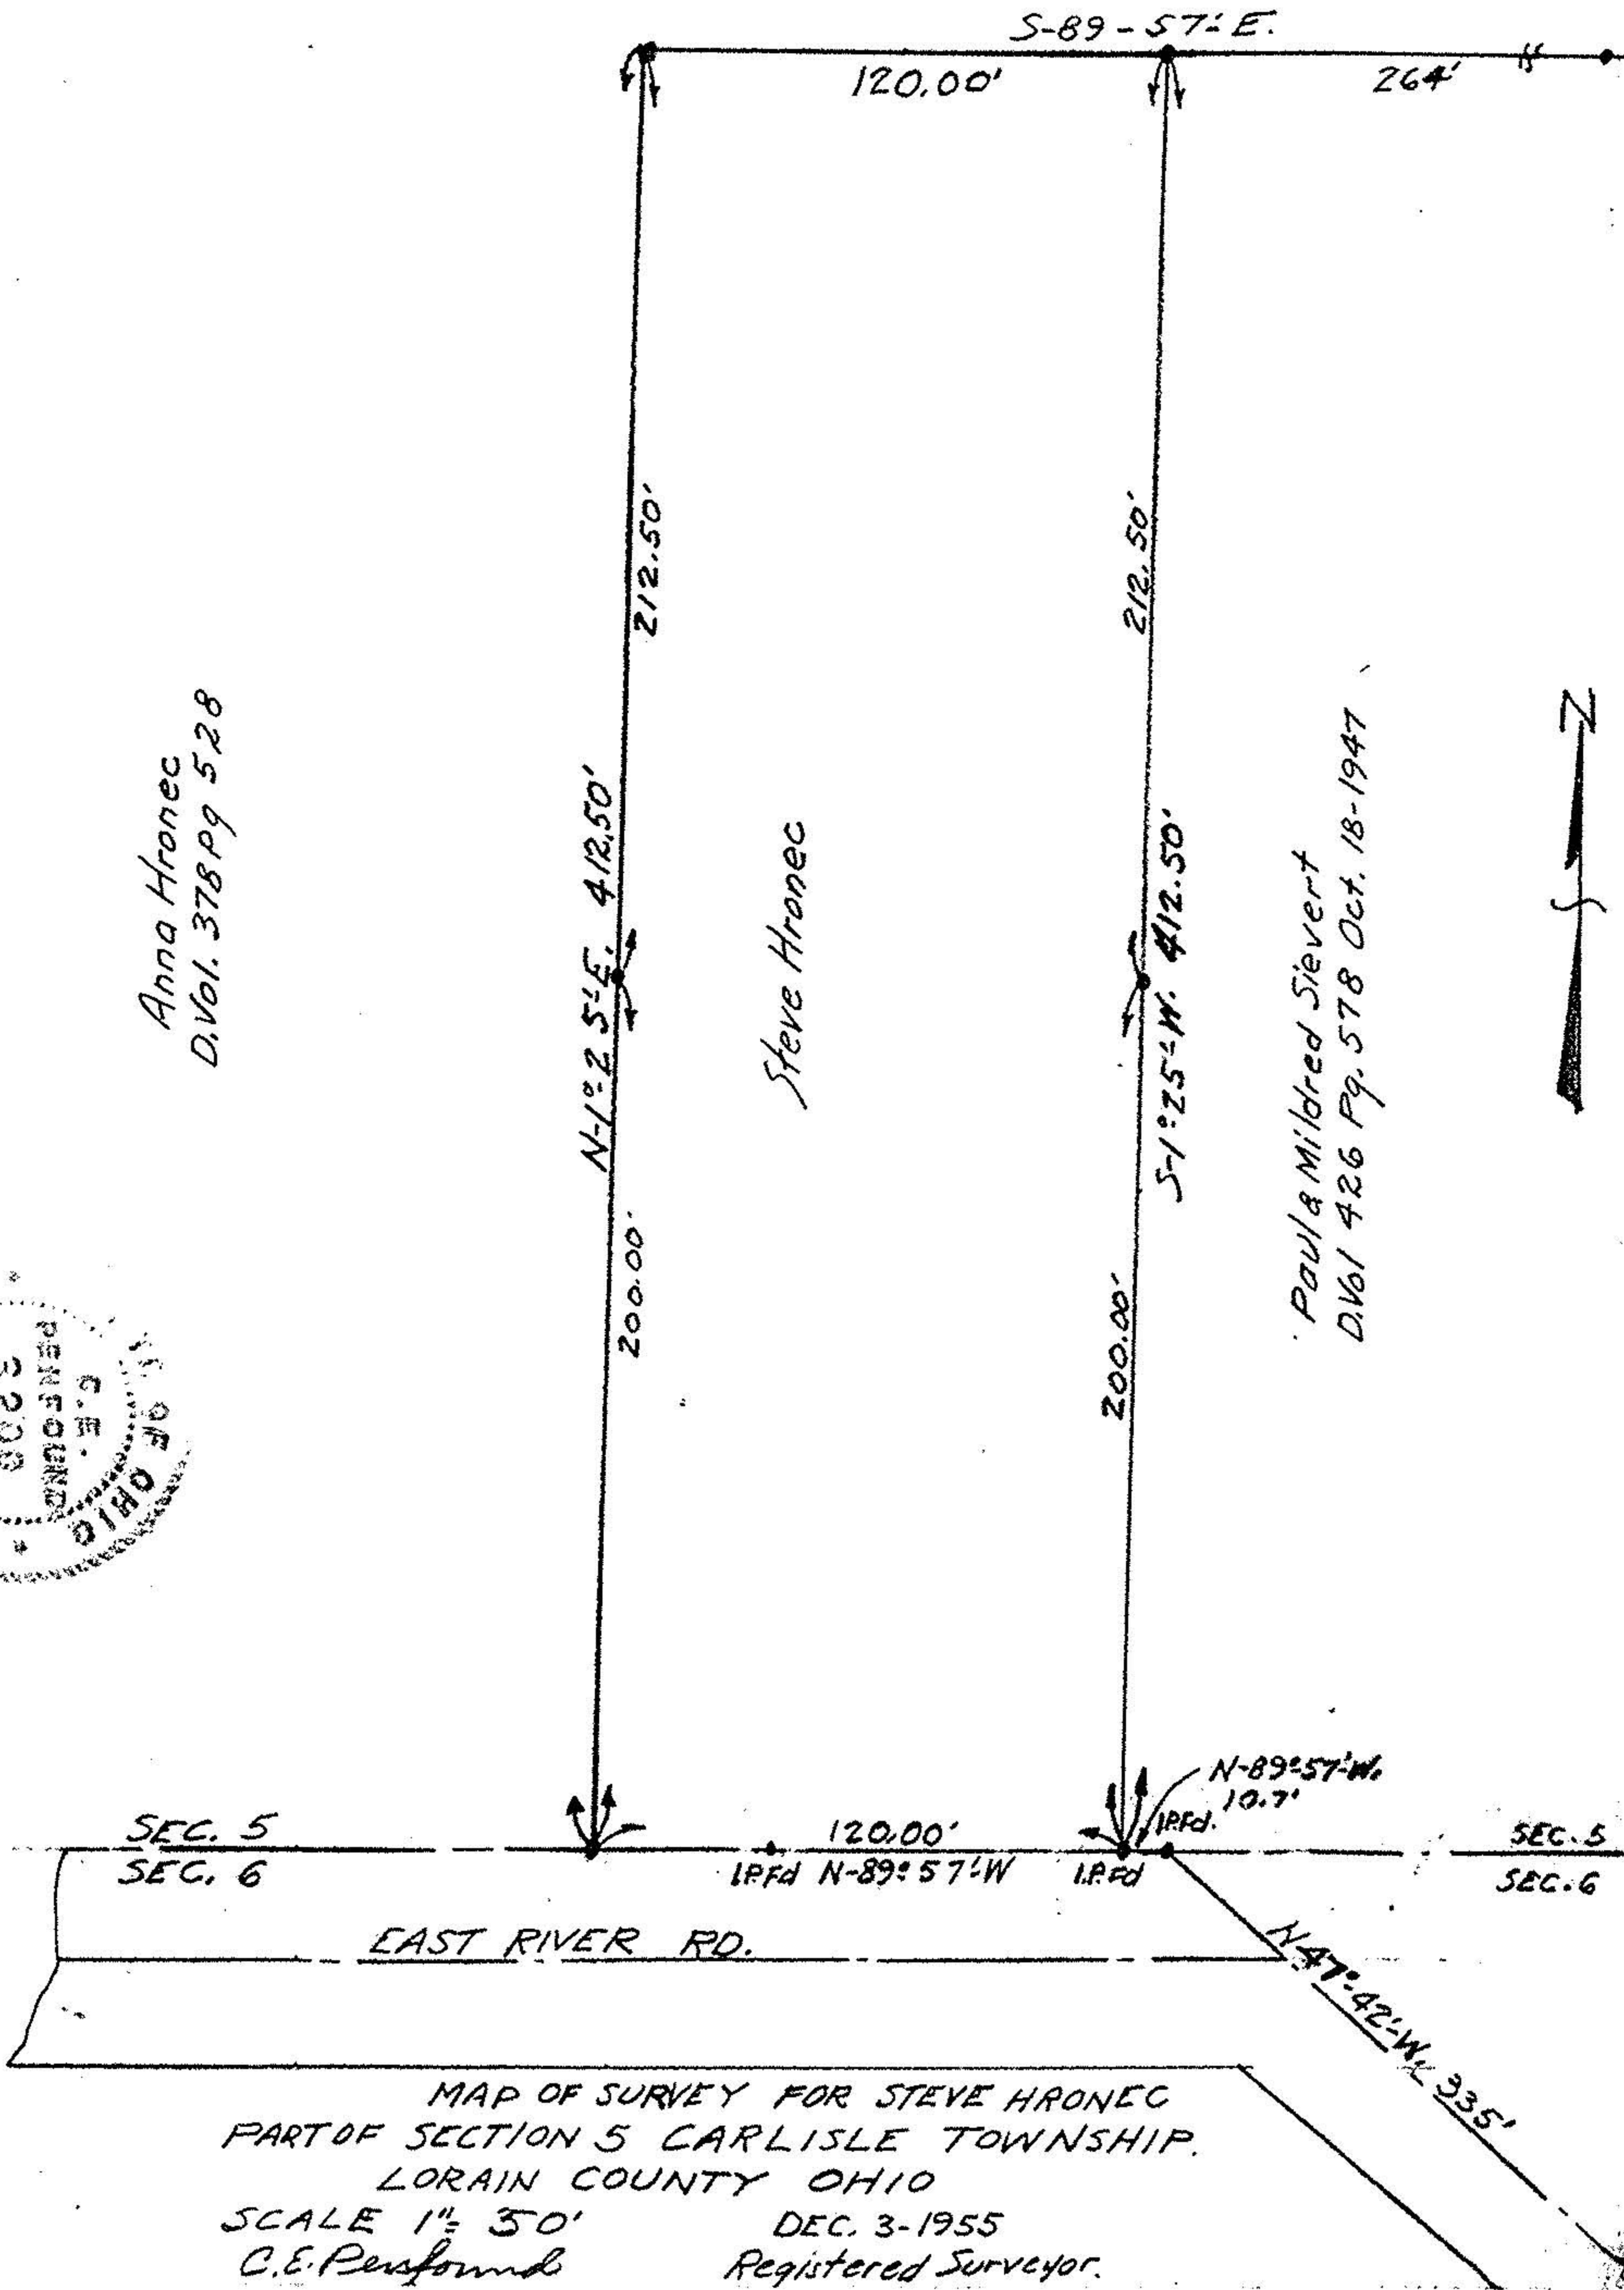

MAP OF SURVEY FOR STEVE HRONEC
 PART OF SECTION 5 CARLISLE TOWNSHIP,
 LORAIN COUNTY OHIO
 SCALE 1" = 30'
 C.E. Penfound
 DEC. 3-1955
 Registered Surveyor.