

South Park Apartments

Brodie & Eunice White
V. 909 P. 178

180.00 R. & Used &
S. 89° 42' 15" W.

210.80' r. & u. S. 89° 42' 15" W.

- 126
0.3841 Ac.

N. 89° 42' 15" E.
180.00 R. & Used &

Carl & Davie Simmons
V. 862 P. 347

- 109

- 127
1.0304 Ac.

- 114
Martha Ann Fisher
V. 1139 P. 116

150' r. & u.


150' r. & u.

N. 89° 42' 15" E.

Resubdivision of Fuller Nelson Subdivision
V. 35 P. 47 & 48

SURVEY & SPLIT
FOR
PHILLIP BRAND
OF

PART OF ORIG. SEC. 4 CARLISLE TOWNSHIP
CITY OF ELYRIA LORAIN COUNTY OHIO
LAUNDON SIMON CAHL & ASSOCIATES
ENGINEERS SURVEYORS
110 MIDDLE AVE ELYRIA, OHIO

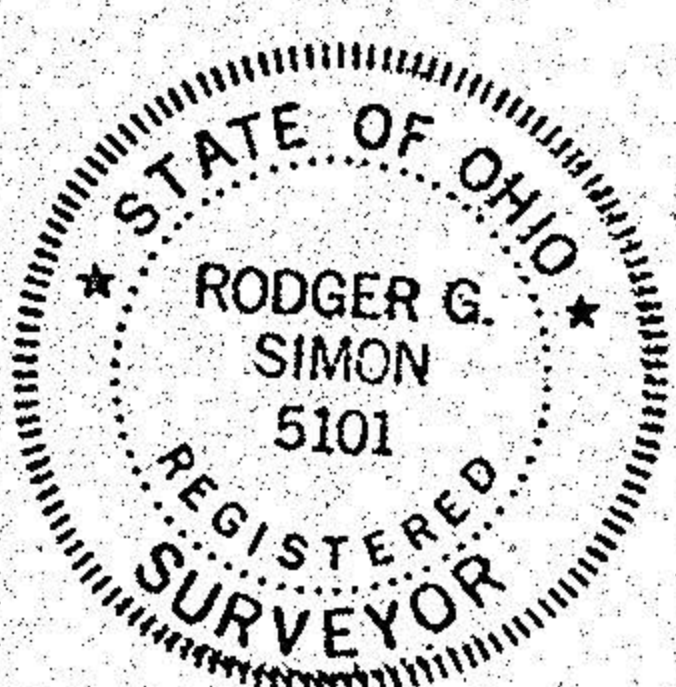

J-6 No. 93-2372
FB 231 P. 2

REV. 3-17-94



NORTH
SCALE 1" = 20'

20808

APPROVED
LORAIN CO.
MAP DEPT.
DATE 4-14-94
PAGE 10-00-004A
BY CAROLYN
FRANCIS
VOID
APR 18 1994 # 20808

NELSON ST.

LINWOOD CT. 60'

South Park Apartments

MIDDLE AVE. N. 0° 47' 05" E

72.96 R. & Used

60.00 R. & Used

60.00 R. & Used

30'

30.00

40'

10.0' I.P. Used

I.P. Fd. 0.6'S.

I.P. Fd. 0.16'S.

2" I.P. Used

I.P. Fd. 0.5'N.

92.96' r. & u.

I.P. Fd. 1'S.

60' r. & u.
212.96' r. & u.
S. 0° 49' 05" W.

I.P. Fd. 0.9'S.

60' r. & u.

I.P. Fd. 1.1'S.

I.P. 1.17'N
0.1'W

N. 0° 49' 05" E. 212.36' r. & u.

I.P. Set

2" I.P. Used

19.01'N.

30.03' r.

195.03' r.

0.80' r. & u.

3.54' r.

60'

283