


11-00-074-000


11-00-074

11-B

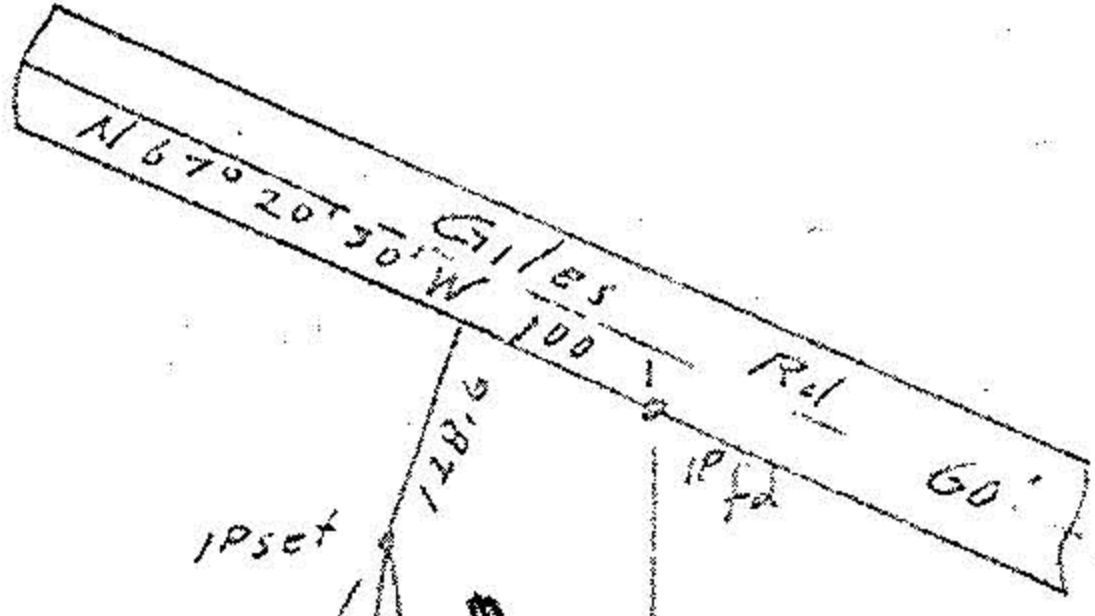

Note: Parcel of 1.06 Ac.
 Billy N & Joan M Kennedy
 Deed Vol 922 Pg 8718

Survey for
 James E & Sarabeth Anderson
 Divol 860 pg 390
 Part of Original Lot 74
 Eaton Township, Lorain County
 Ohio
 July 1, 1967 Scale 1"=200'

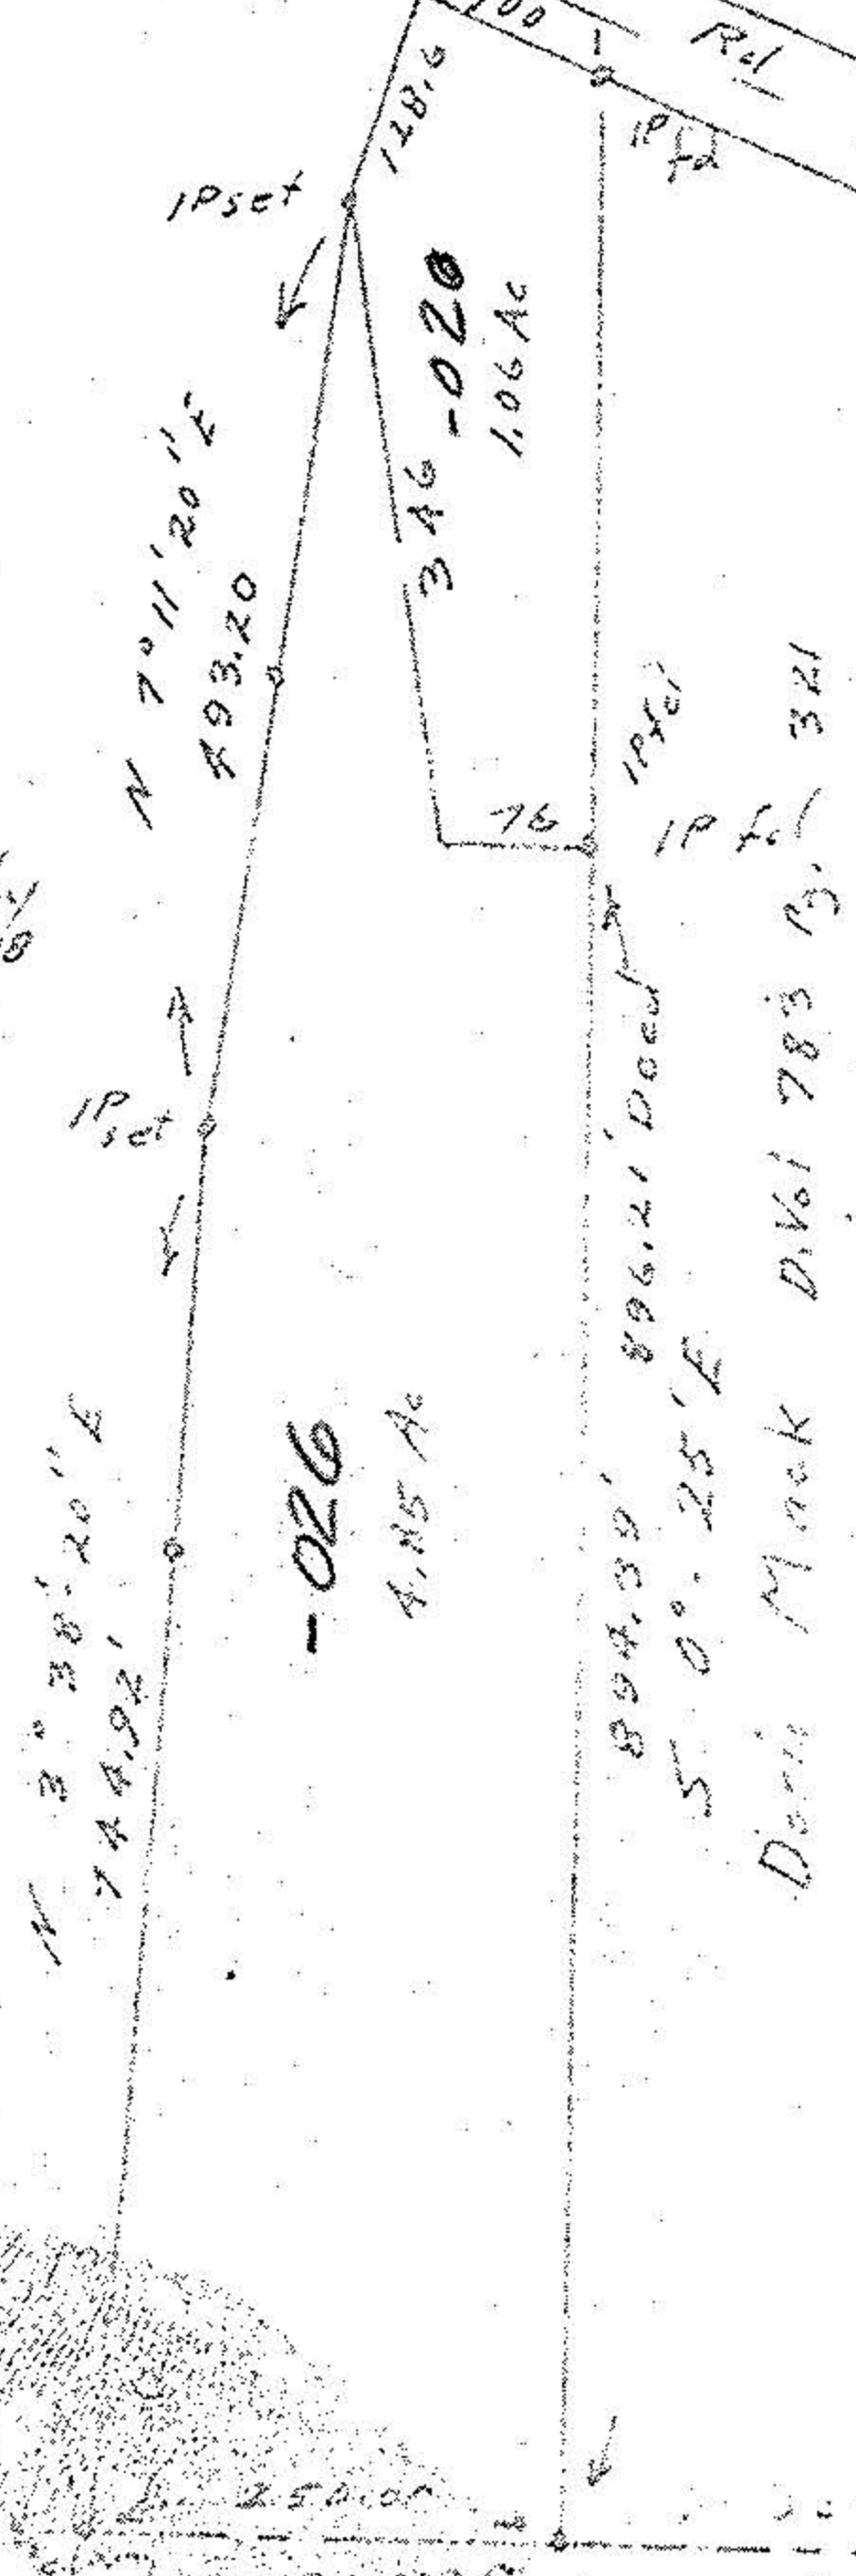

John ...
 203,741

John Poyg ...
 Reg. Surveyor
 #5292