



KLEINEDER-SCHMIDT and ASSOCIATES

EVERIA - NORWALK - MEDINA

ENGINEERS - SURVEYORS - CONSULTANTS IN LAND PLANNING

OHIO

SURVEY

Sublot(s) _____

Subd'n _____

Tract _____

Sec. _____

State of Ohio

Township EATON

Orig. Lot(s) 74

County of LORAIN

Corporation _____

#16986

APPROVED
LORAIN CO.
MAP DEPT.

DATE 9.9.86

PAGE 11-B & 11-00-074-A

BY T. McHain

VOID
AFTER


NORTH

11-B

#16986

11-00-074-000

11-00-074-A

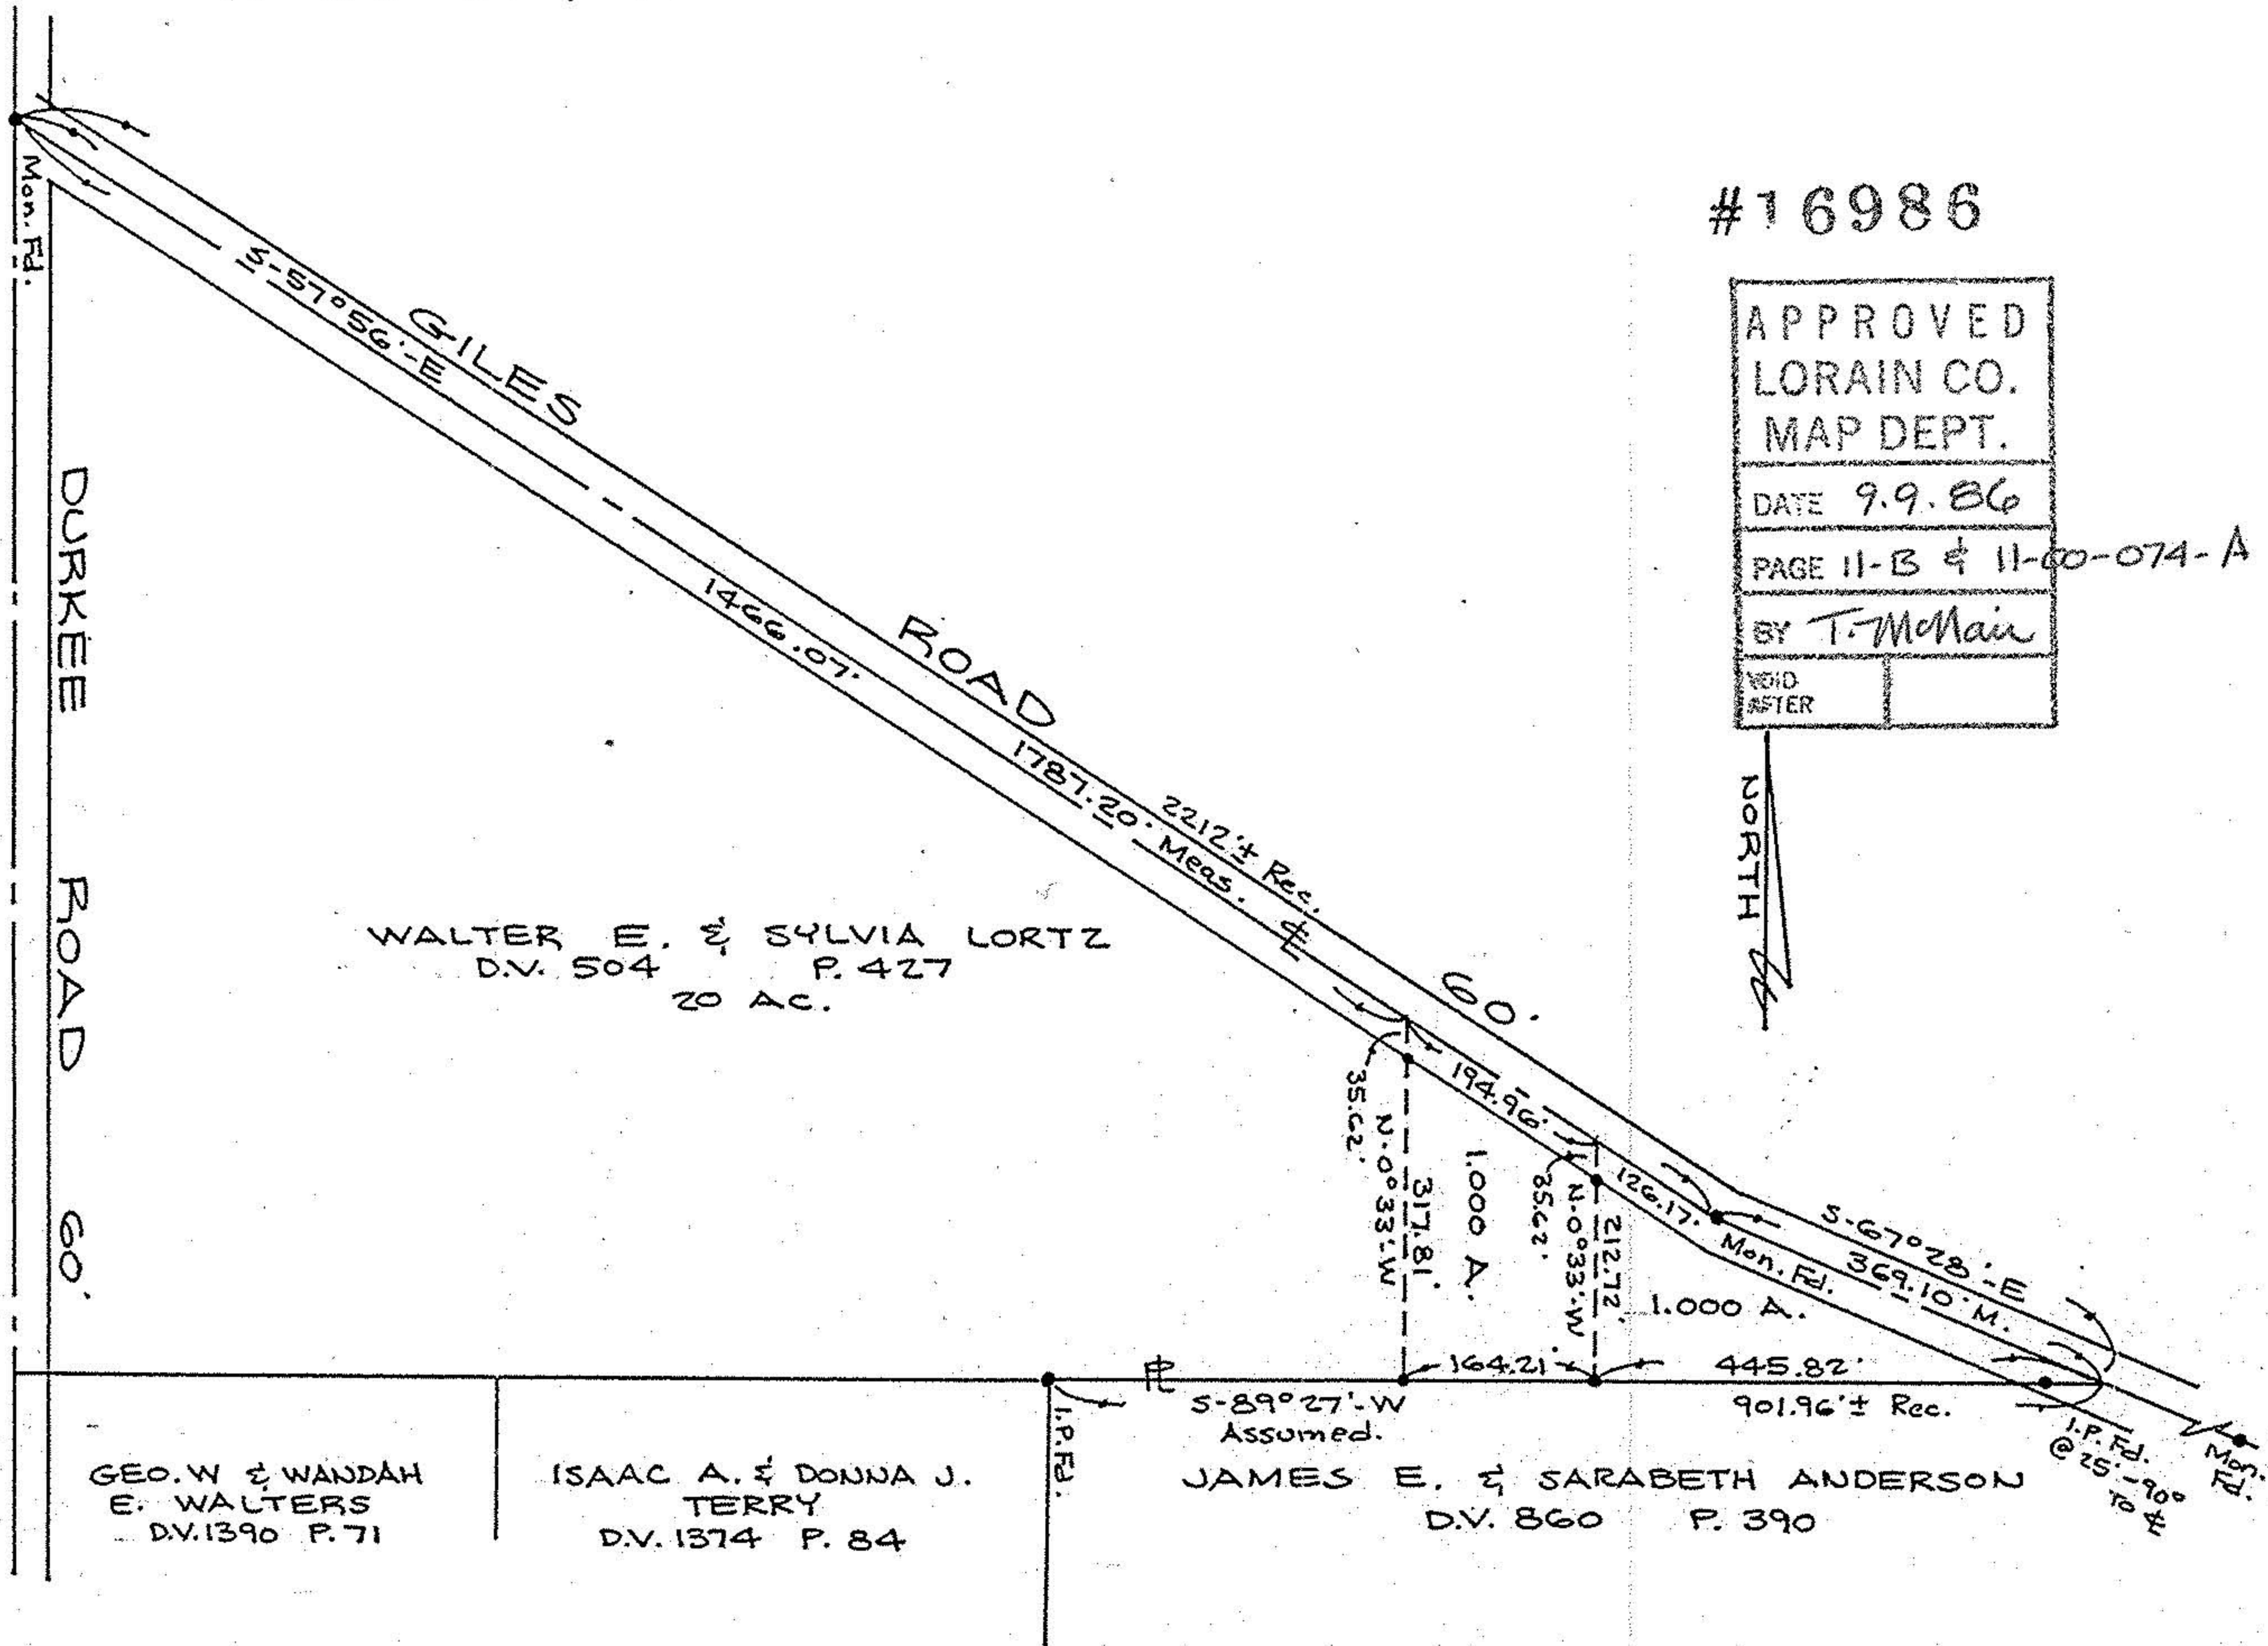

WALTER E. & SYLVIA LORTZ
D.V. 504 P. 427
20 AC.

GEO. W & WANDAH
E. WALTERS
D.V. 1390 P. 71

ISAAC A. & DONNA J.
TERRY
D.V. 1374 P. 84

JAMES E. & SARABETH ANDERSON
D.V. 860 P. 390

Prepared for:

Scale: 1" = 200'

Date: Aug. 1, 1986

Dr. by: T.E.

Tab. No.

Page No.