



11-00-076A
10651.

11-00-076-000
DUNBAR ROAD 60

JOSEPH & EVELYN SPANOKI
5-13-64 DV 574 P. 421

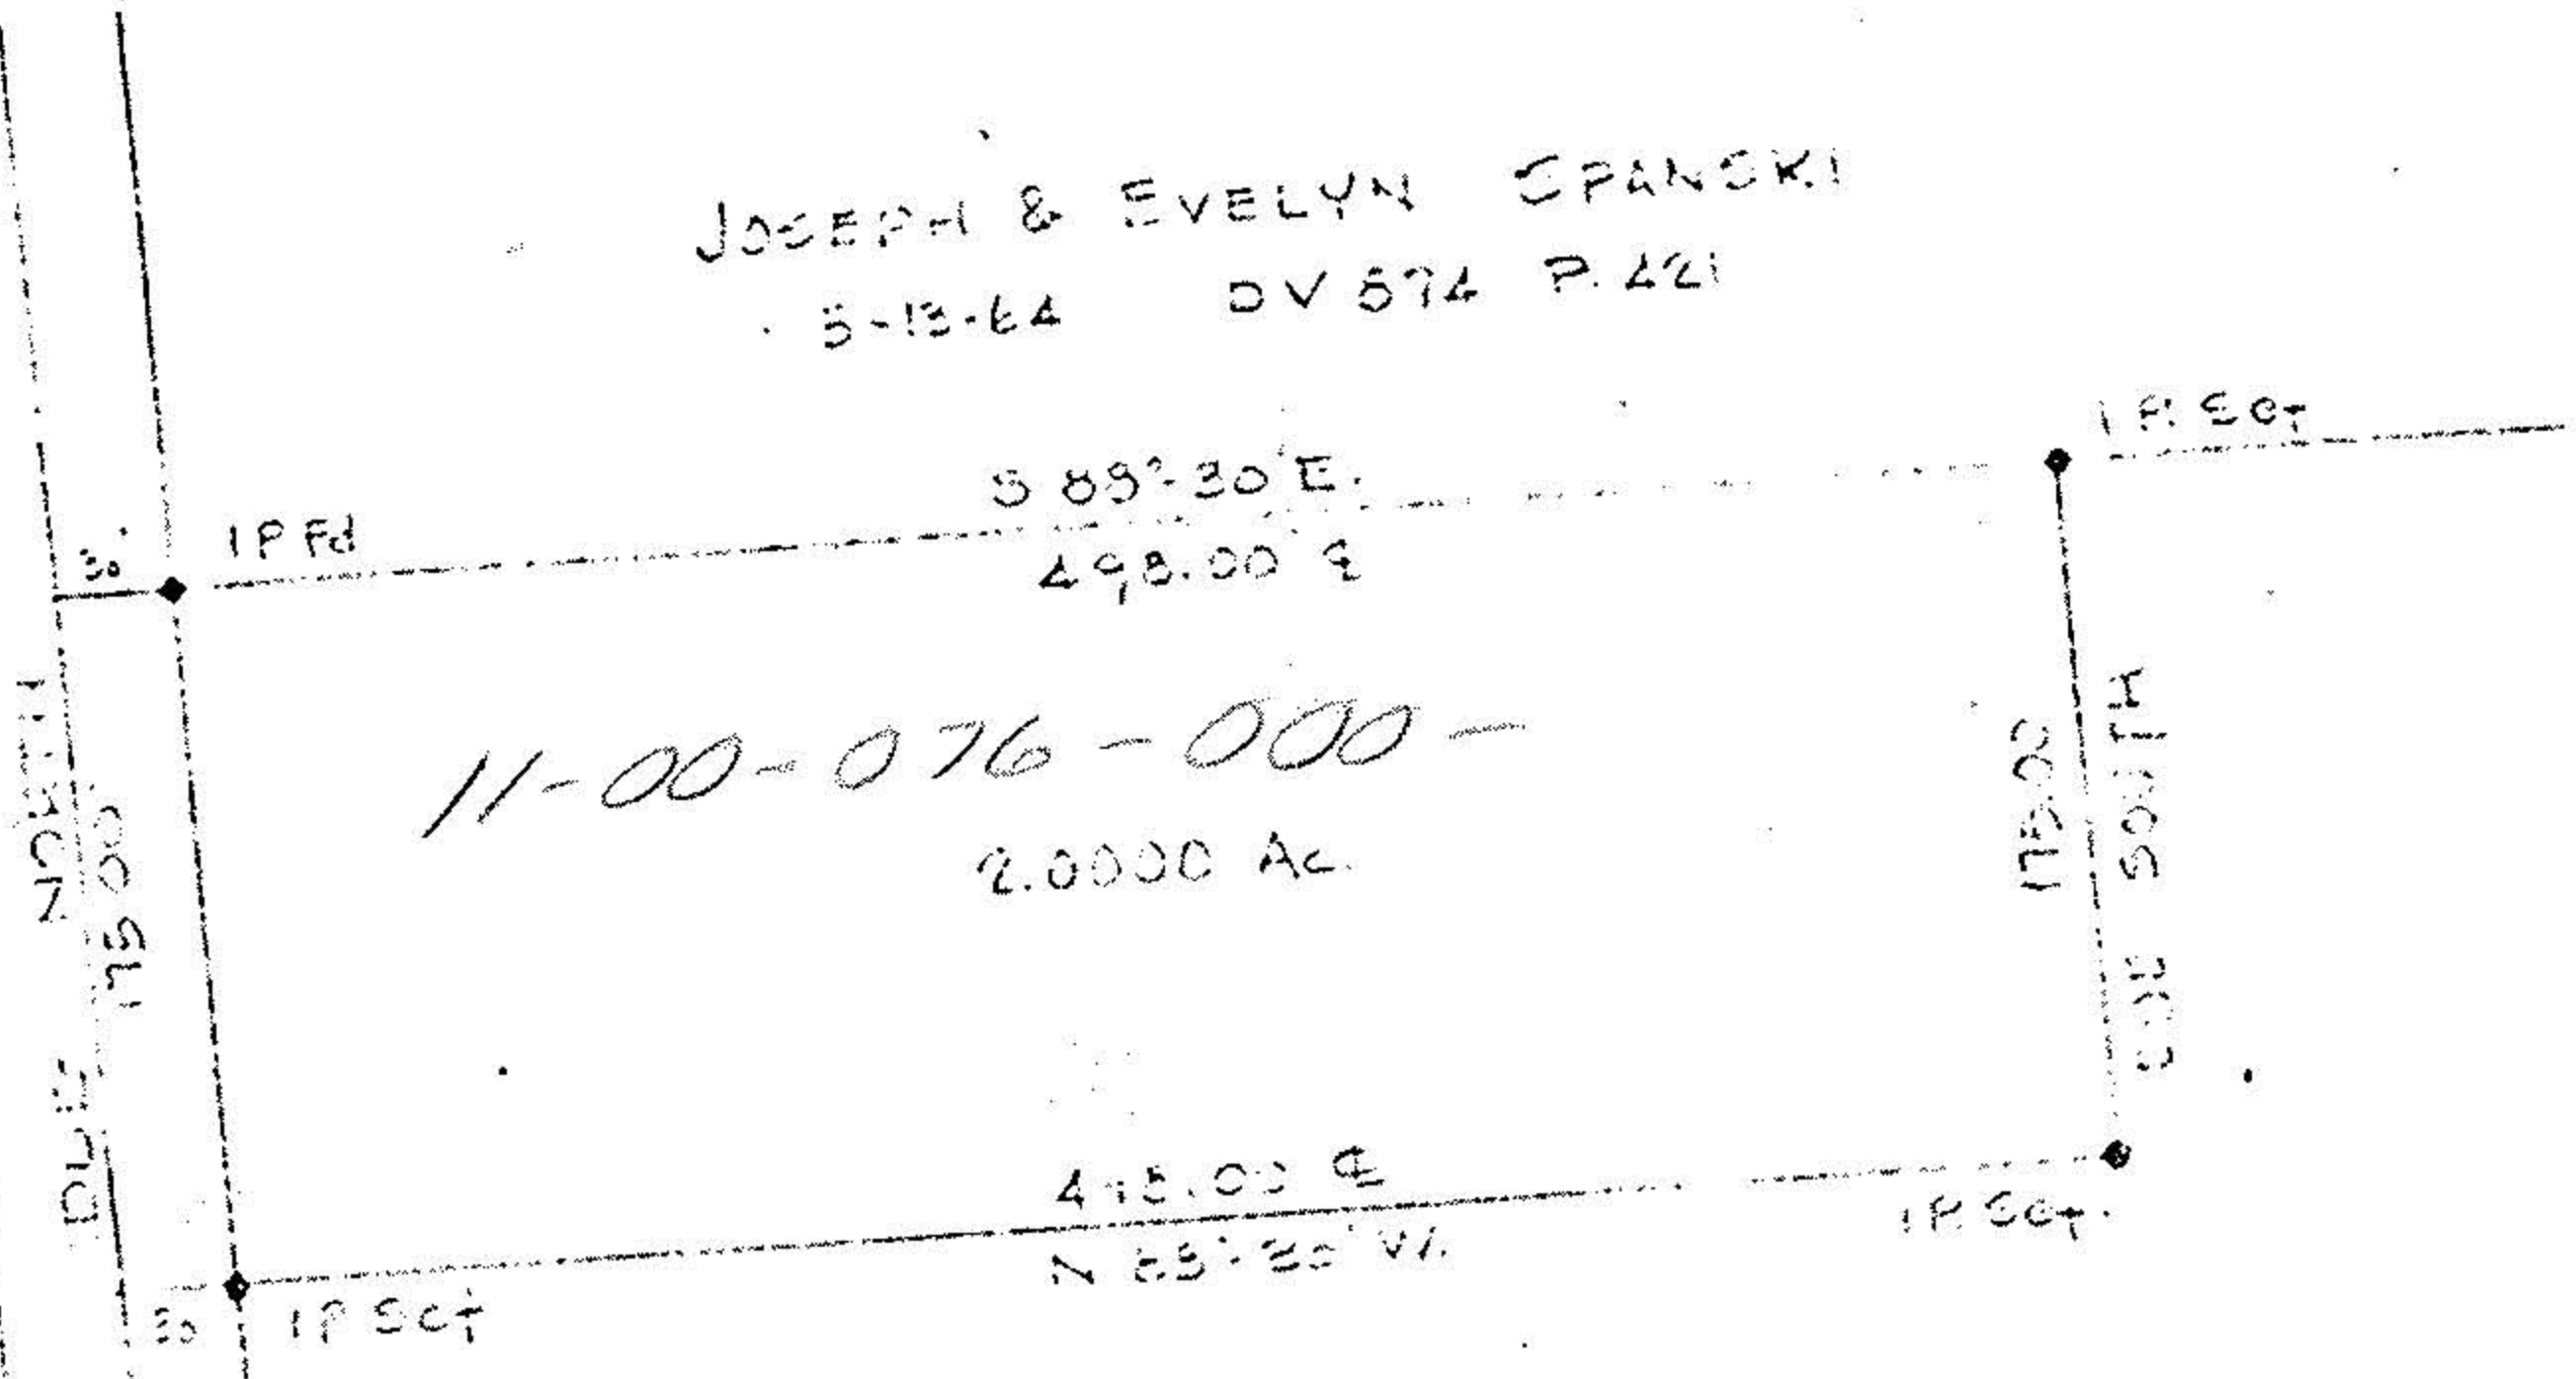

JUN 23 1977

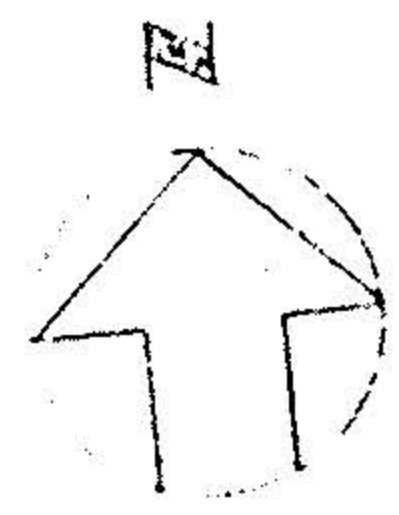

11-00-076A

SURVEY FOR
PASQUALE & ELMA M. CUCUZZA
 OL 76 ELTON TWP LORAIN COUNTY OHIO
 SCALE 1"=100'
 LAUNDON SIMON CALL & ASSOC
 ENGINEERS
 JOB No 77-424
 SURVEYORS
 FEB 10/77