




LAUNDON . SIMON . CAHL & ASSOC. INC.
 CONSULTING ENGINEERS & SURVEYORS
 219 COURT ST. ELYRIA, OHIO 44035

SURVEY FOR:
D. SCOTT & FRANCES JOHNSON
 OF S/L 22 & PT. OF S/L 23 IN J.C. MILLER'S ALLOT. P.V. 6 P. 47

Orig. Lot	City of	Date 3-1988	Scale 1"=40'
Orig. Sec. 4	Village of	Dwn. by R.G.S.	Chkd. by C.J.
Tract	County of LORAIN	Job No. 88-1718	F.B.
Township of CARLISLE	State of OHIO	Printed	

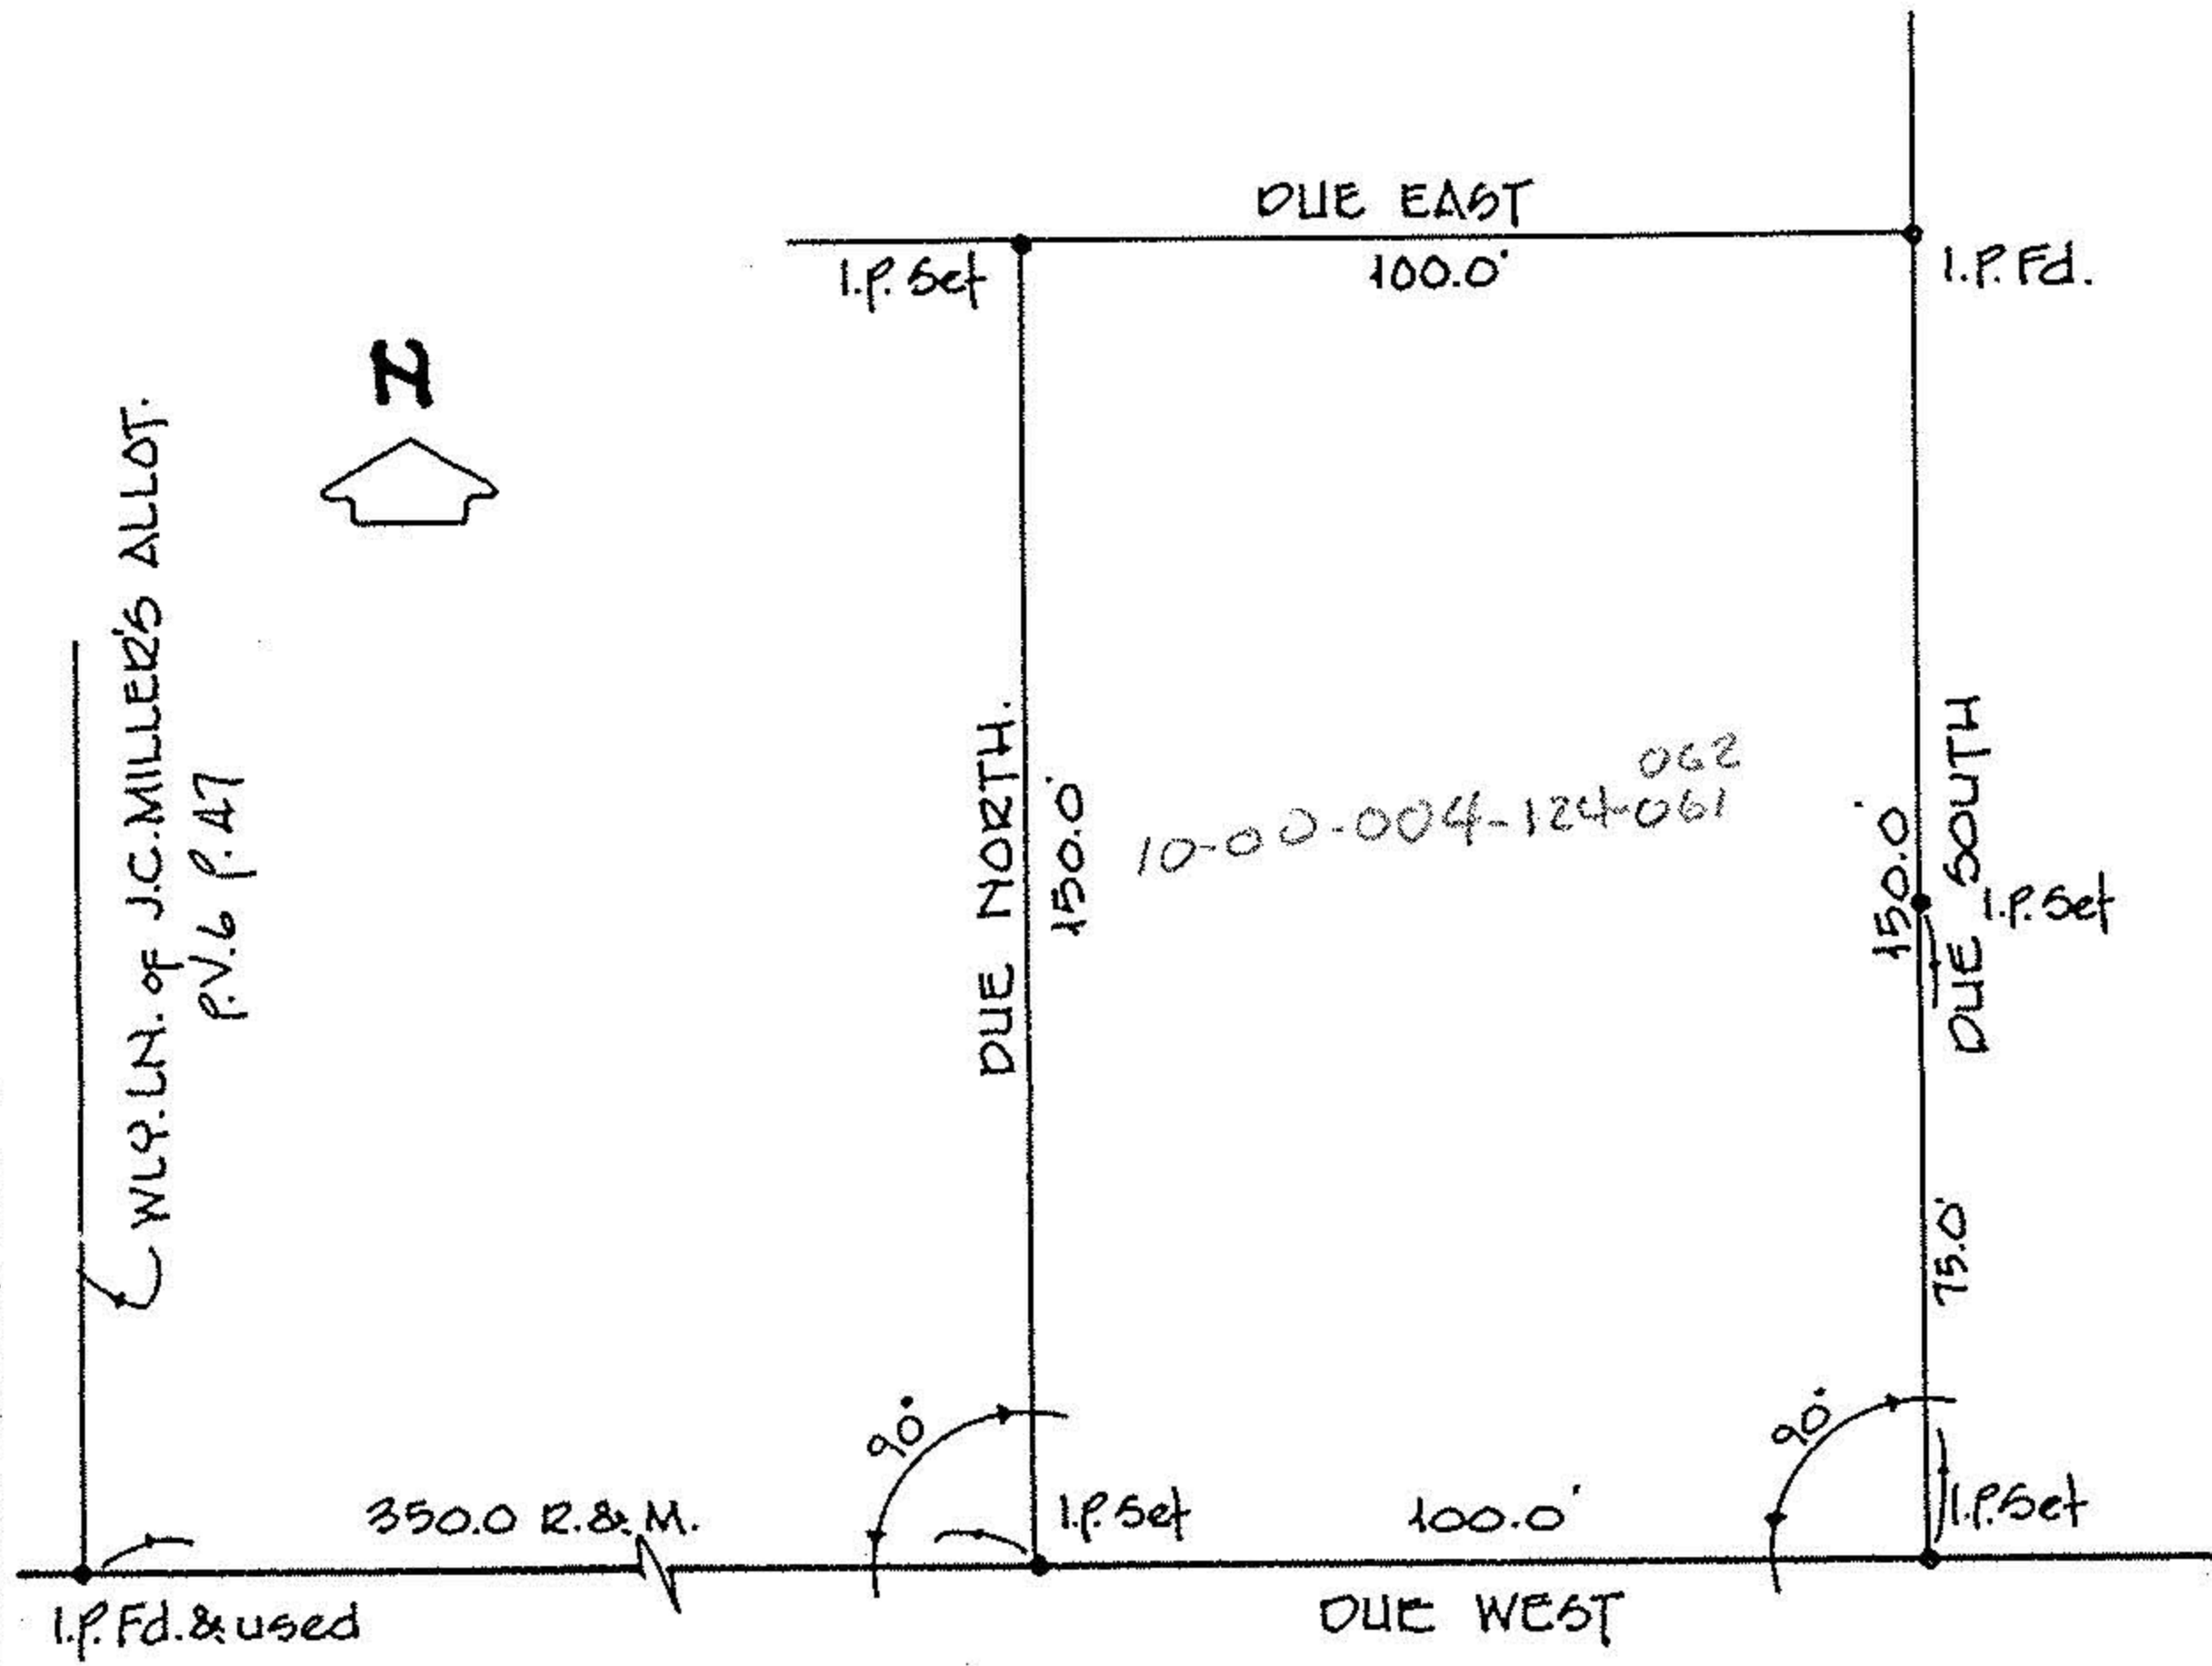

MILLER COURT 50'