



# KLEINOEDER · SCHMIDT


## and ASSOCIATES

ENGINEERS — SURVEYORS — CONSULTANTS in LAND PLANNING  
ELYRIA · NORWALK · MEDINA OHIO

JOB NO 79-14

SUBLOTS 26 & 27  
CASTLETON ESTATES ~ P.V. 36 PP. 52-54  
TOWNSHIP OF EATON COUNTY OF LORAIN  
STATE OF OHIO

11-00-086-000  
# 15961

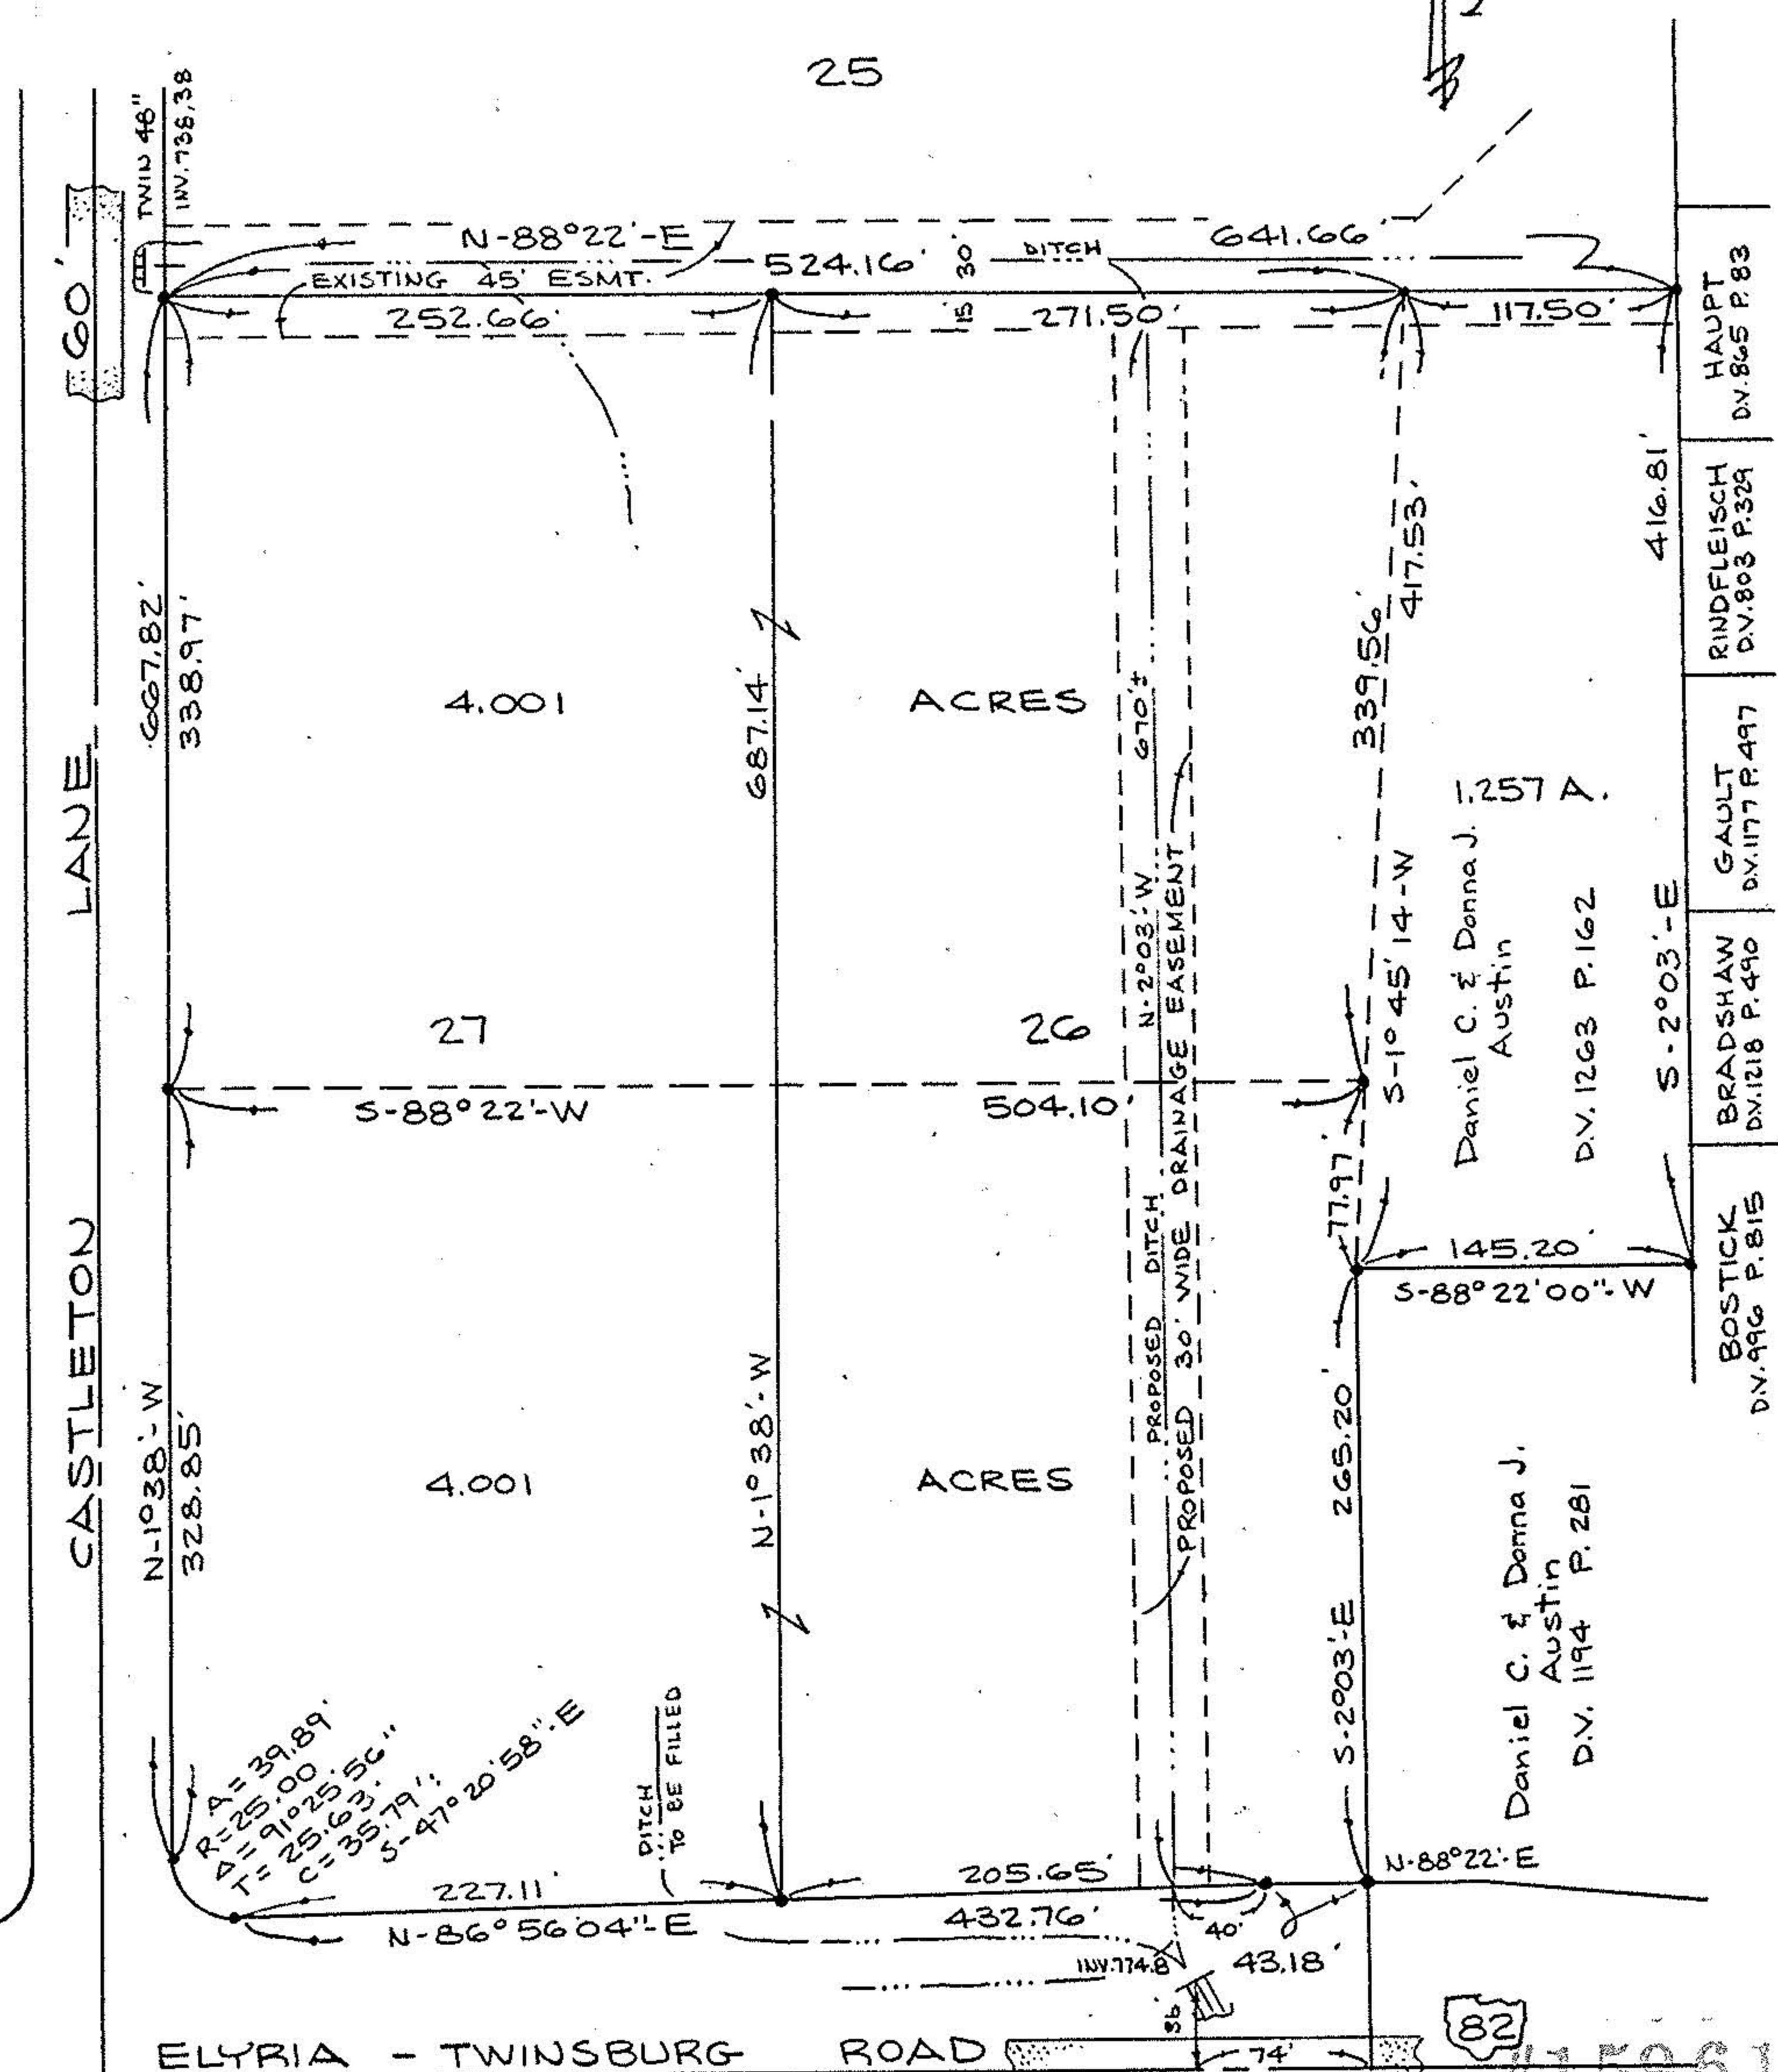

#15961  
APPROVED  
LORAIN CO.  
MAP DEPT.

Prepared for: DALE YOST

DATE 12.26.84  
PAGE 11-00-086-B

Scale: 1" = 100'      Date: MAY 15, 1984      REV. 7-25-84 (DITCH RELOC.) BY T. McNamee