


PARENT PARCEL: 10-00-006-120-046

CHILD PARCEL: 10-00-006-120-056 & -057

STARTING POINT: N.W. CORNER OF BAHMER'S LAND & CL OF BUTTERNUT RIDGE RD.

NO. 00096-X

BUTTERNUT RIDGE RD. 60'

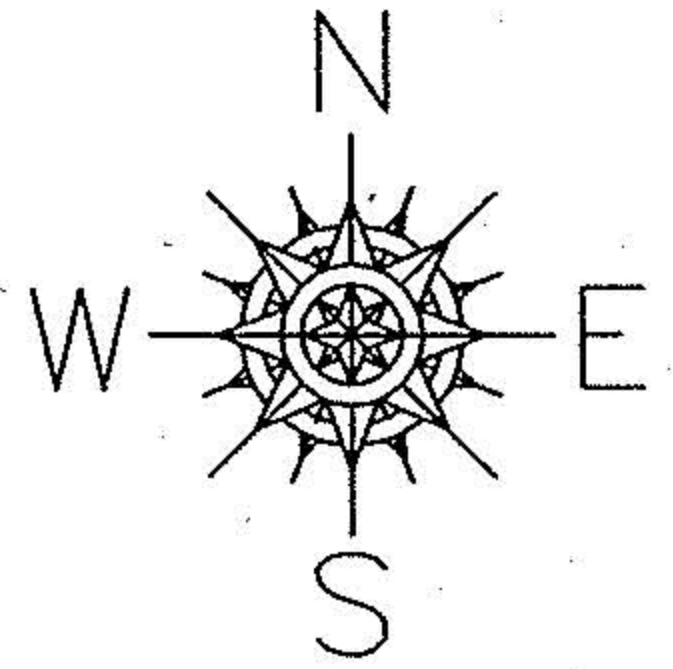

UNCOMBINATION


~~10-00-006-120-046~~  
~~1.68 A.~~

10-00-006-120-056  
1.38 A.

&


10-00-006-120-057  
0.30 A.

SURVEYED BY  
J. W. WARDEN

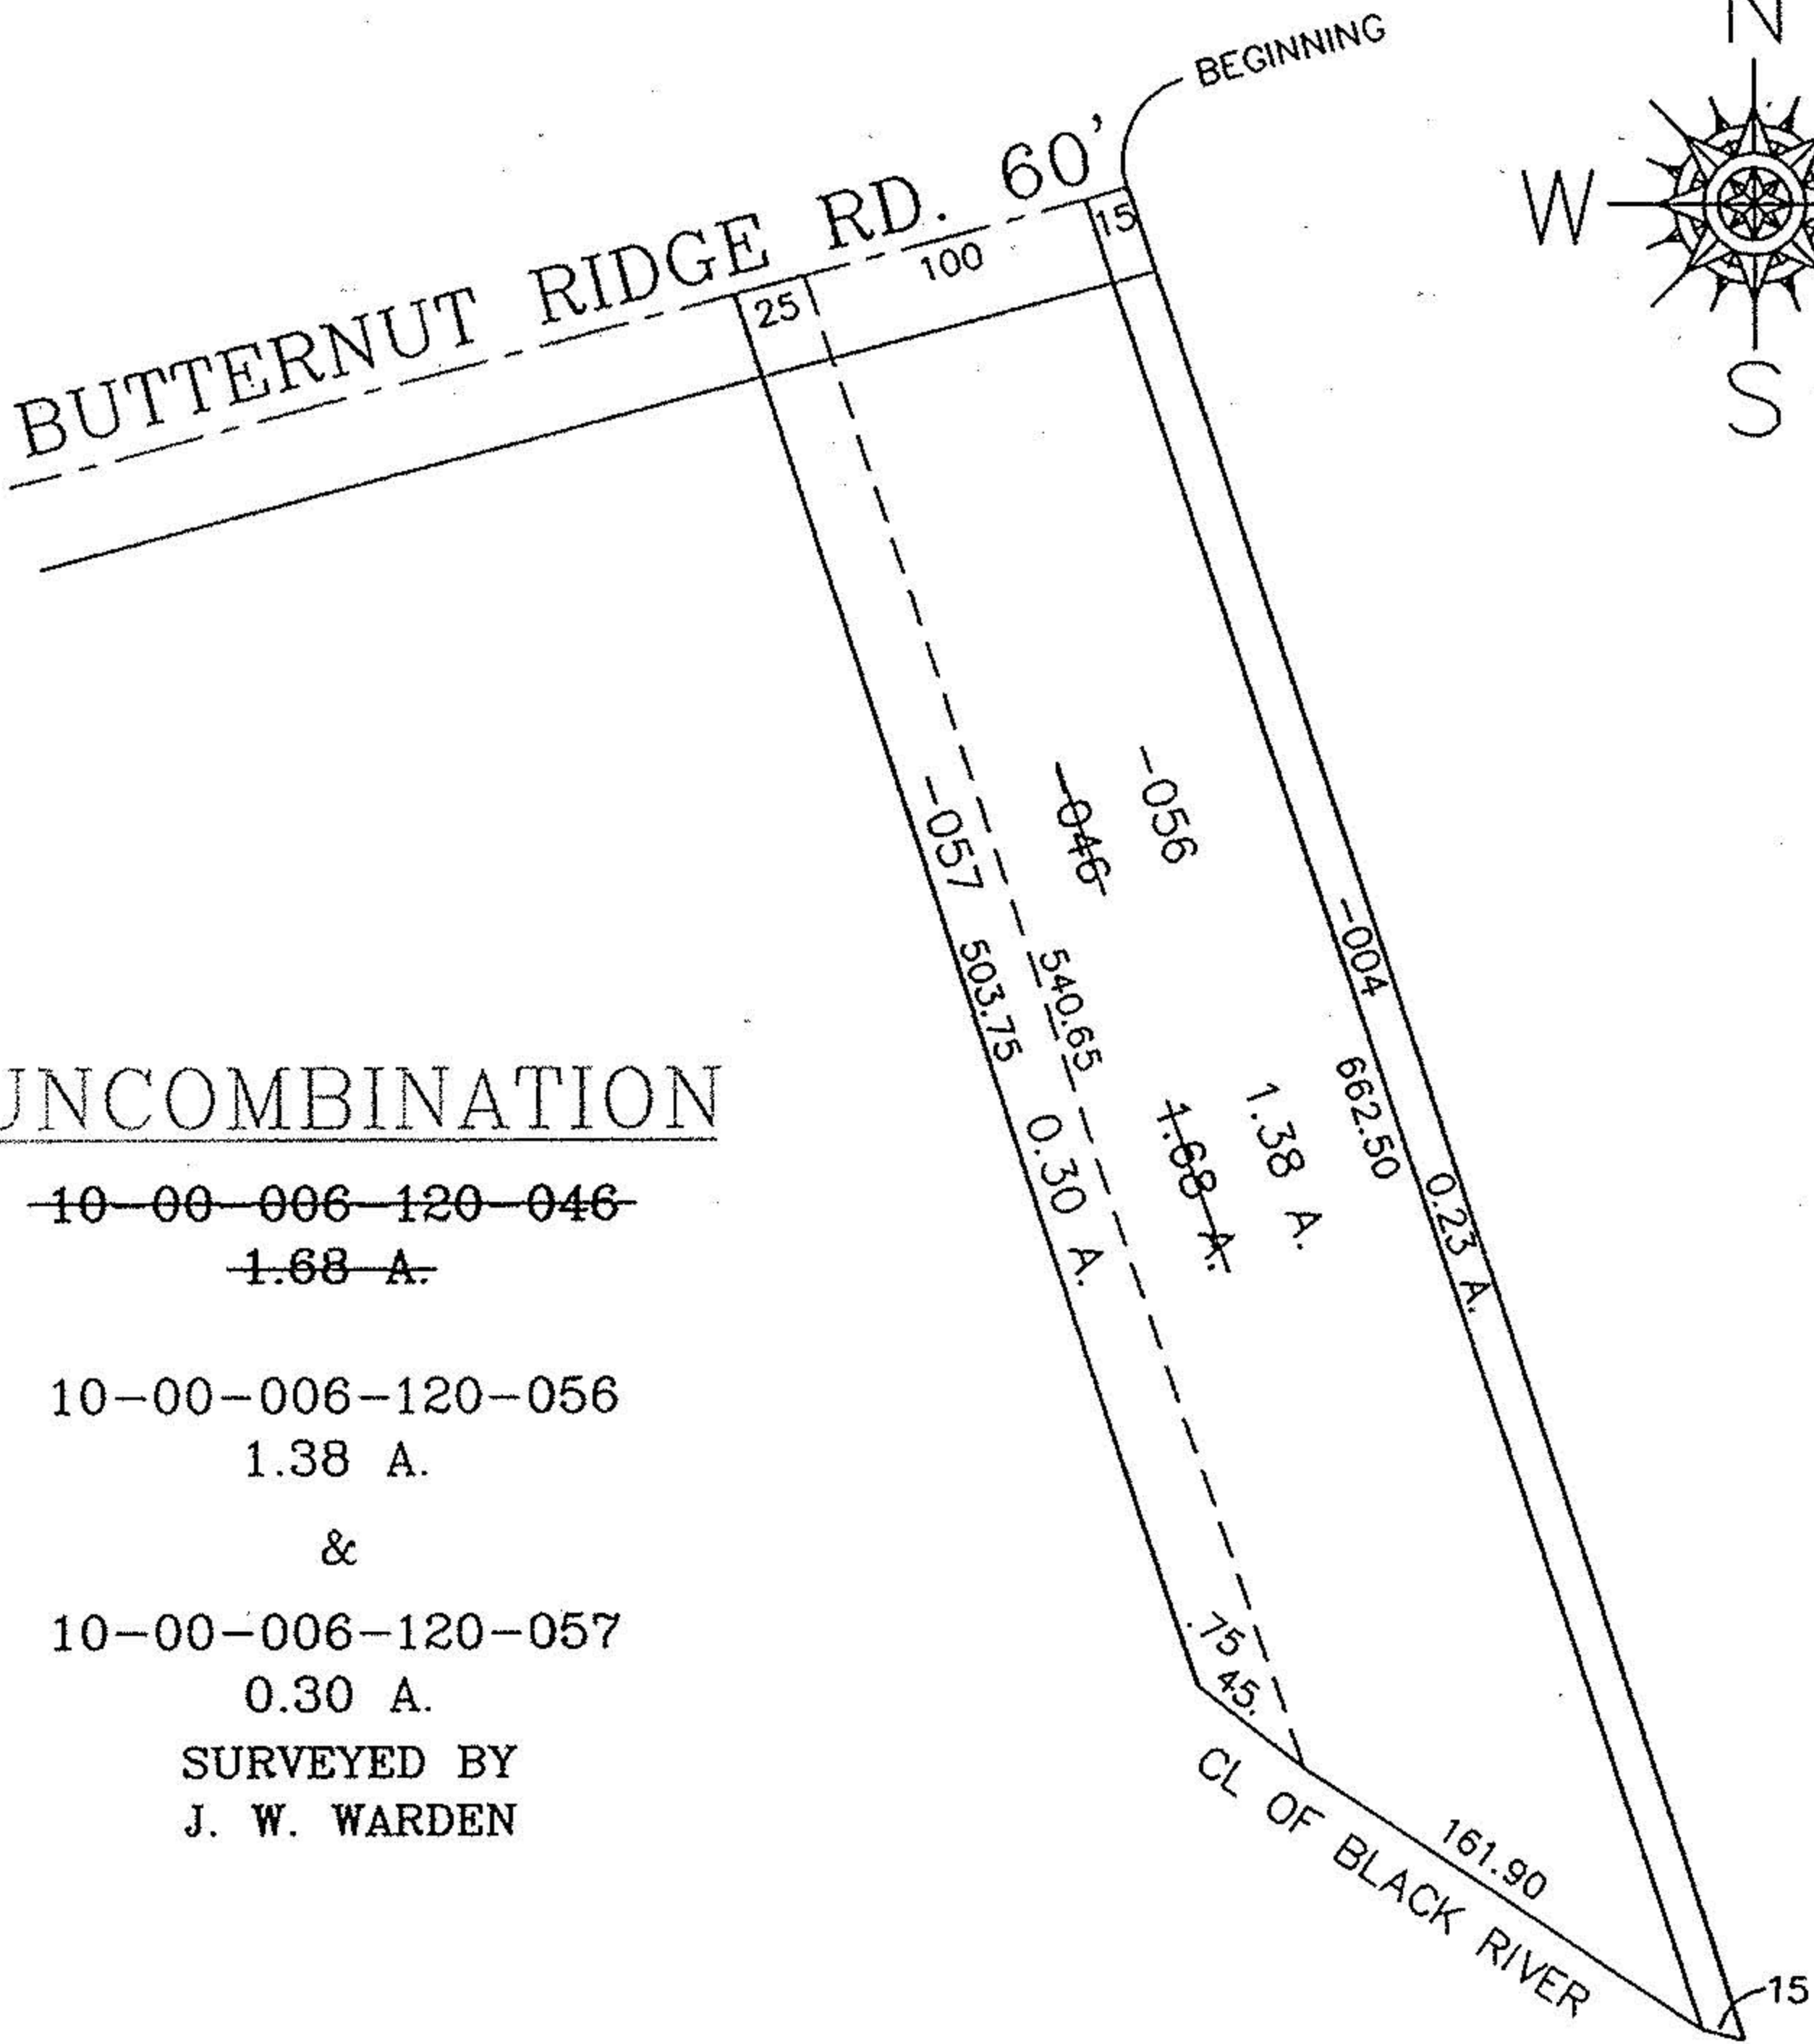

PRIOR INSTRUMENT: DV 851/346

PRIOR INSTRUMENT: DV 834/723

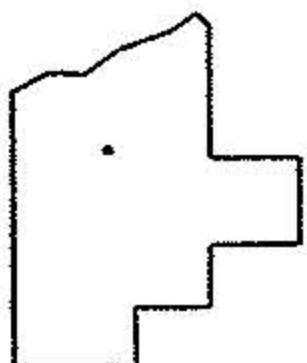

SPLITS/DEEDS PROCESSED

LORAIN COUNTY TAX MAP DEPARTMENT  
226 MIDDLE AVE. ELYRIA, OHIO

SURVEYED BY: J.W. WARDEN

CLOSURE: 1.15 : 10.000

MAP PAGE(S): 10-00-006-F

APPROVED BY: TJS DATE: 07/14/99

SCALE: 1" = 100