




LAUNDON • SIMON • CAHL & ASSOC., INC.
CONSULTING ENGINEERS & SURVEYORS
110 MIDDLE AVE., ELYRIA, O. 44035

SURVEY FOR:
OSWALD O. & MARJORIE J.
POULSEN

Orig. Lot	City of	Date DEC. '91 Scale 1"=100'
Orig. Sec. 6	Village of	Dwn. by R.G.S. Chkd. by R.C.
Tract	County of LORAIN	Job No. 91-2123 F.B.
Township of CARLISLE	State of OHIO	Printed DEC 26 1991

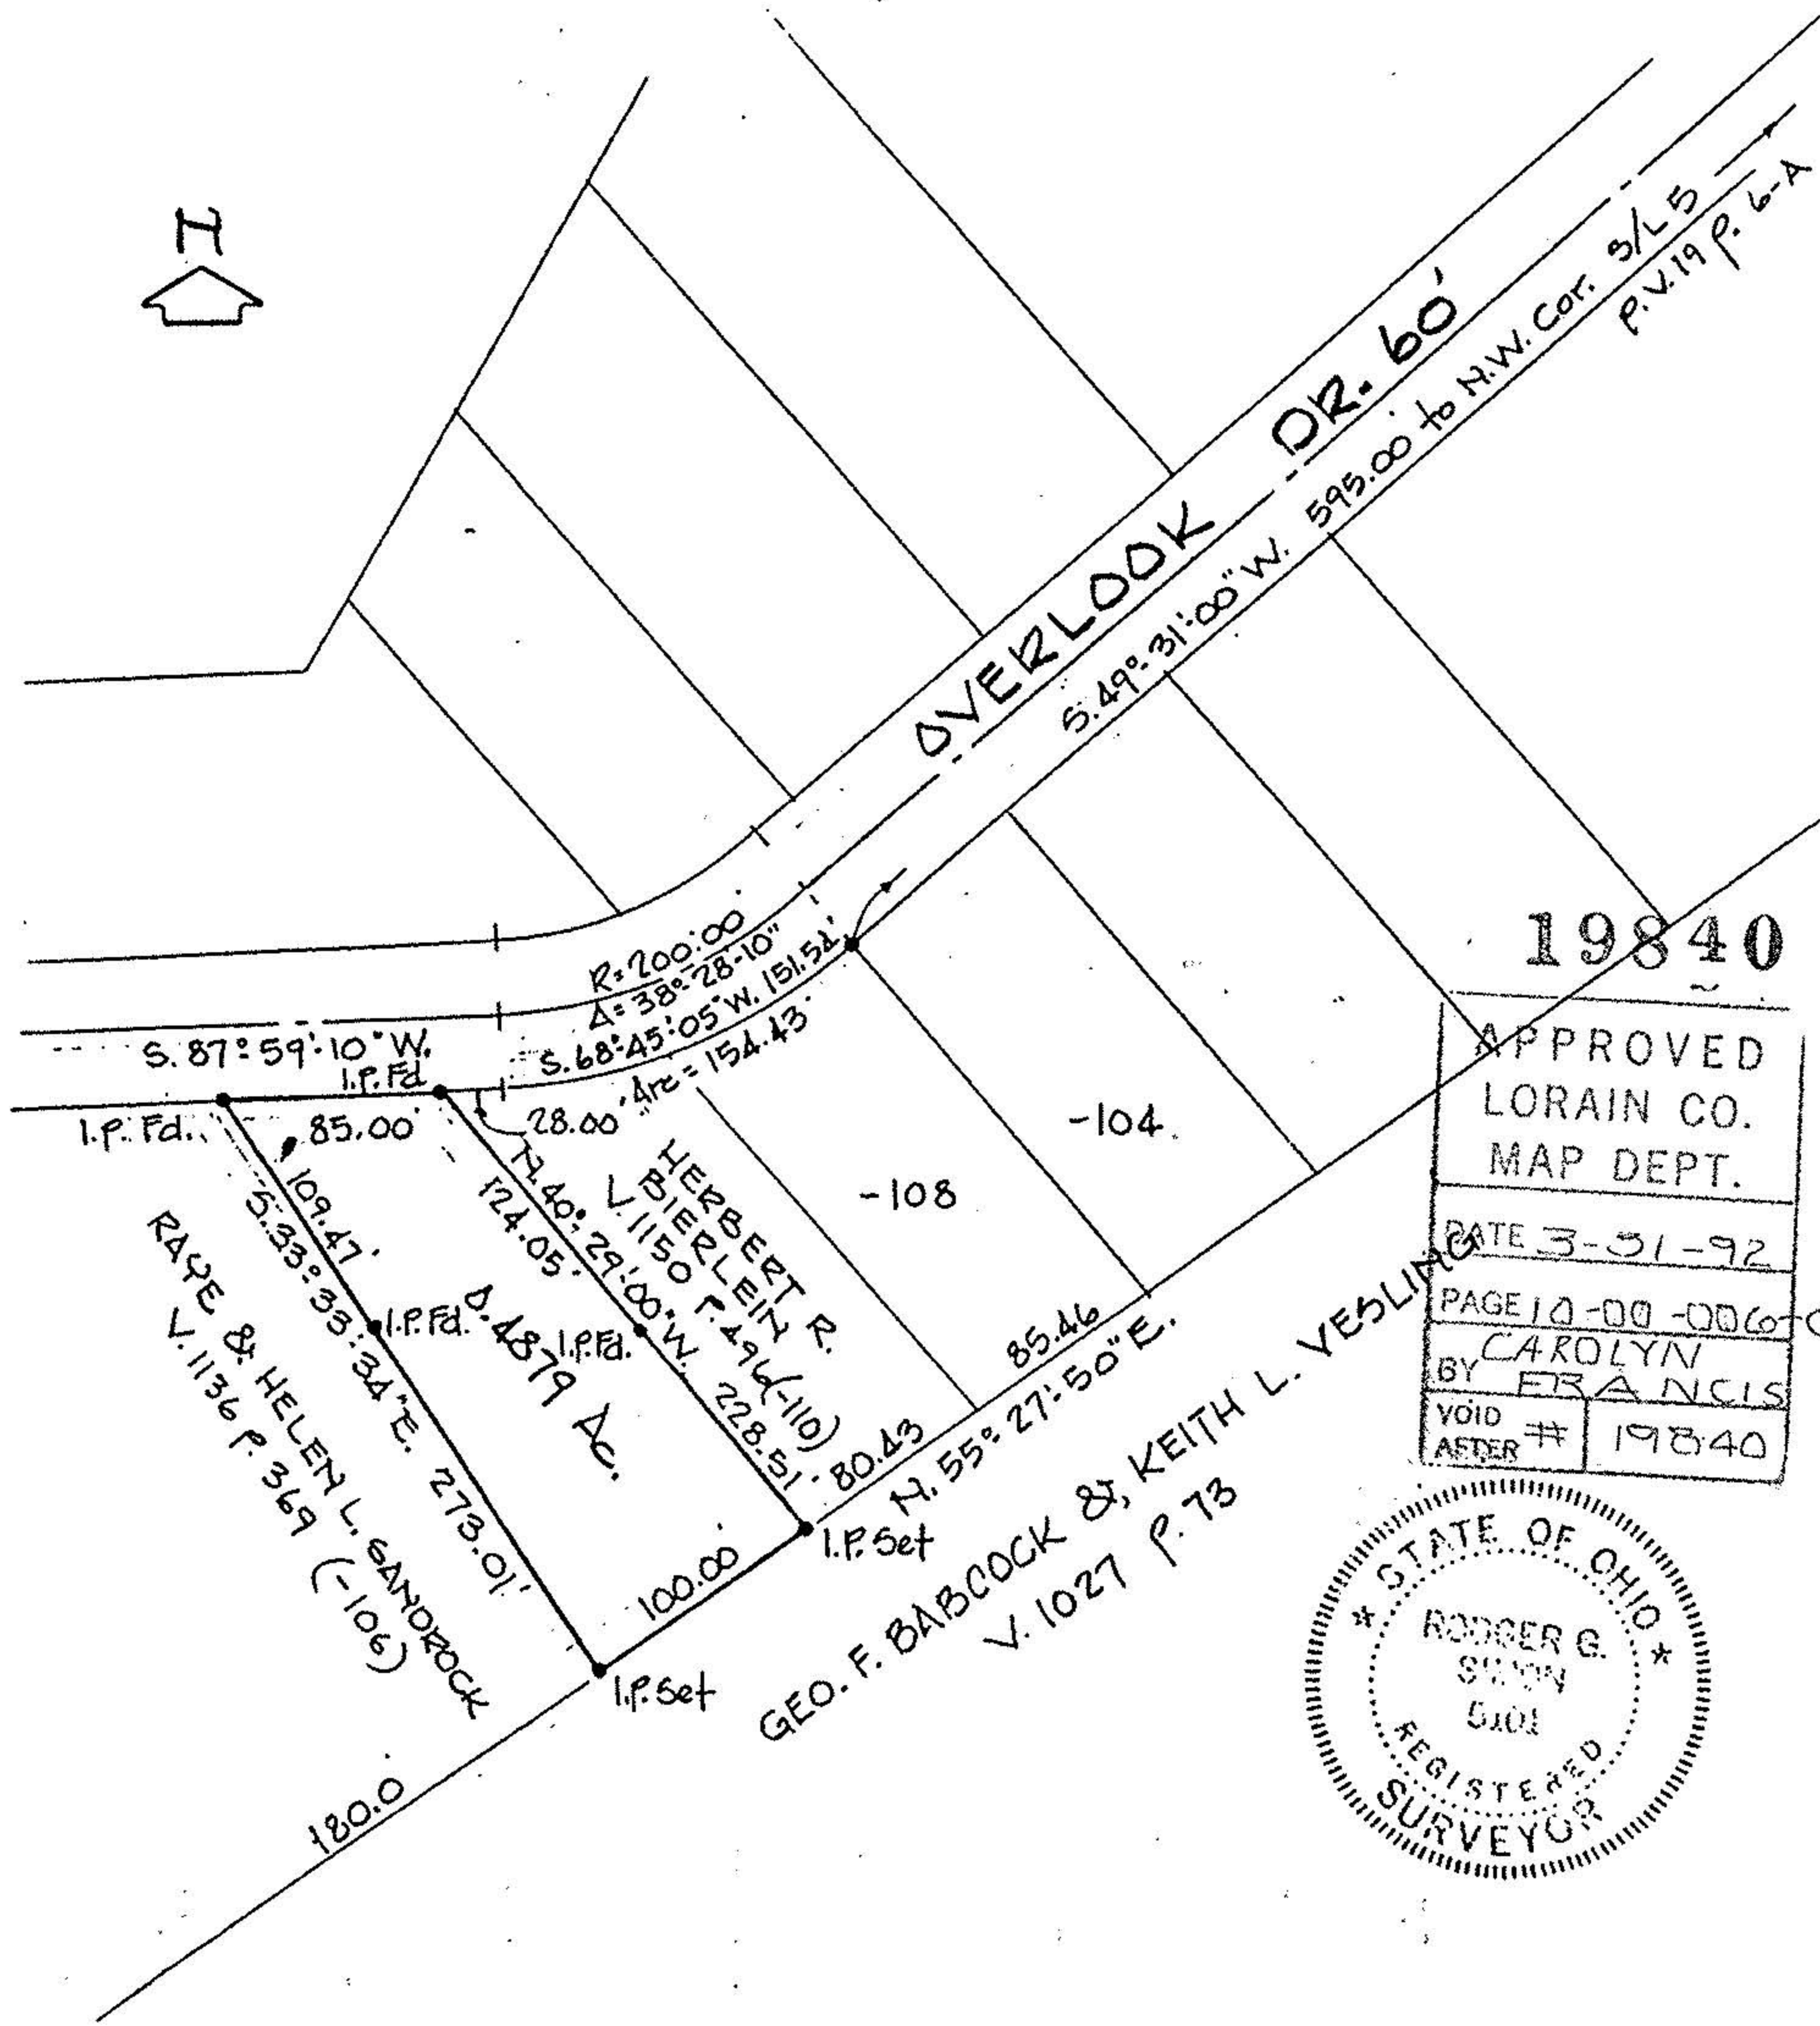

19840

APPROVED
LORAIN CO.
MAP DEPT.
DATE 3-31-92
PAGE 10-00-006 G
BY CAROLYN
FRANCIS
VOID AFTER # 19840



10-00-00-01