


Spitzer Hardware & Supply

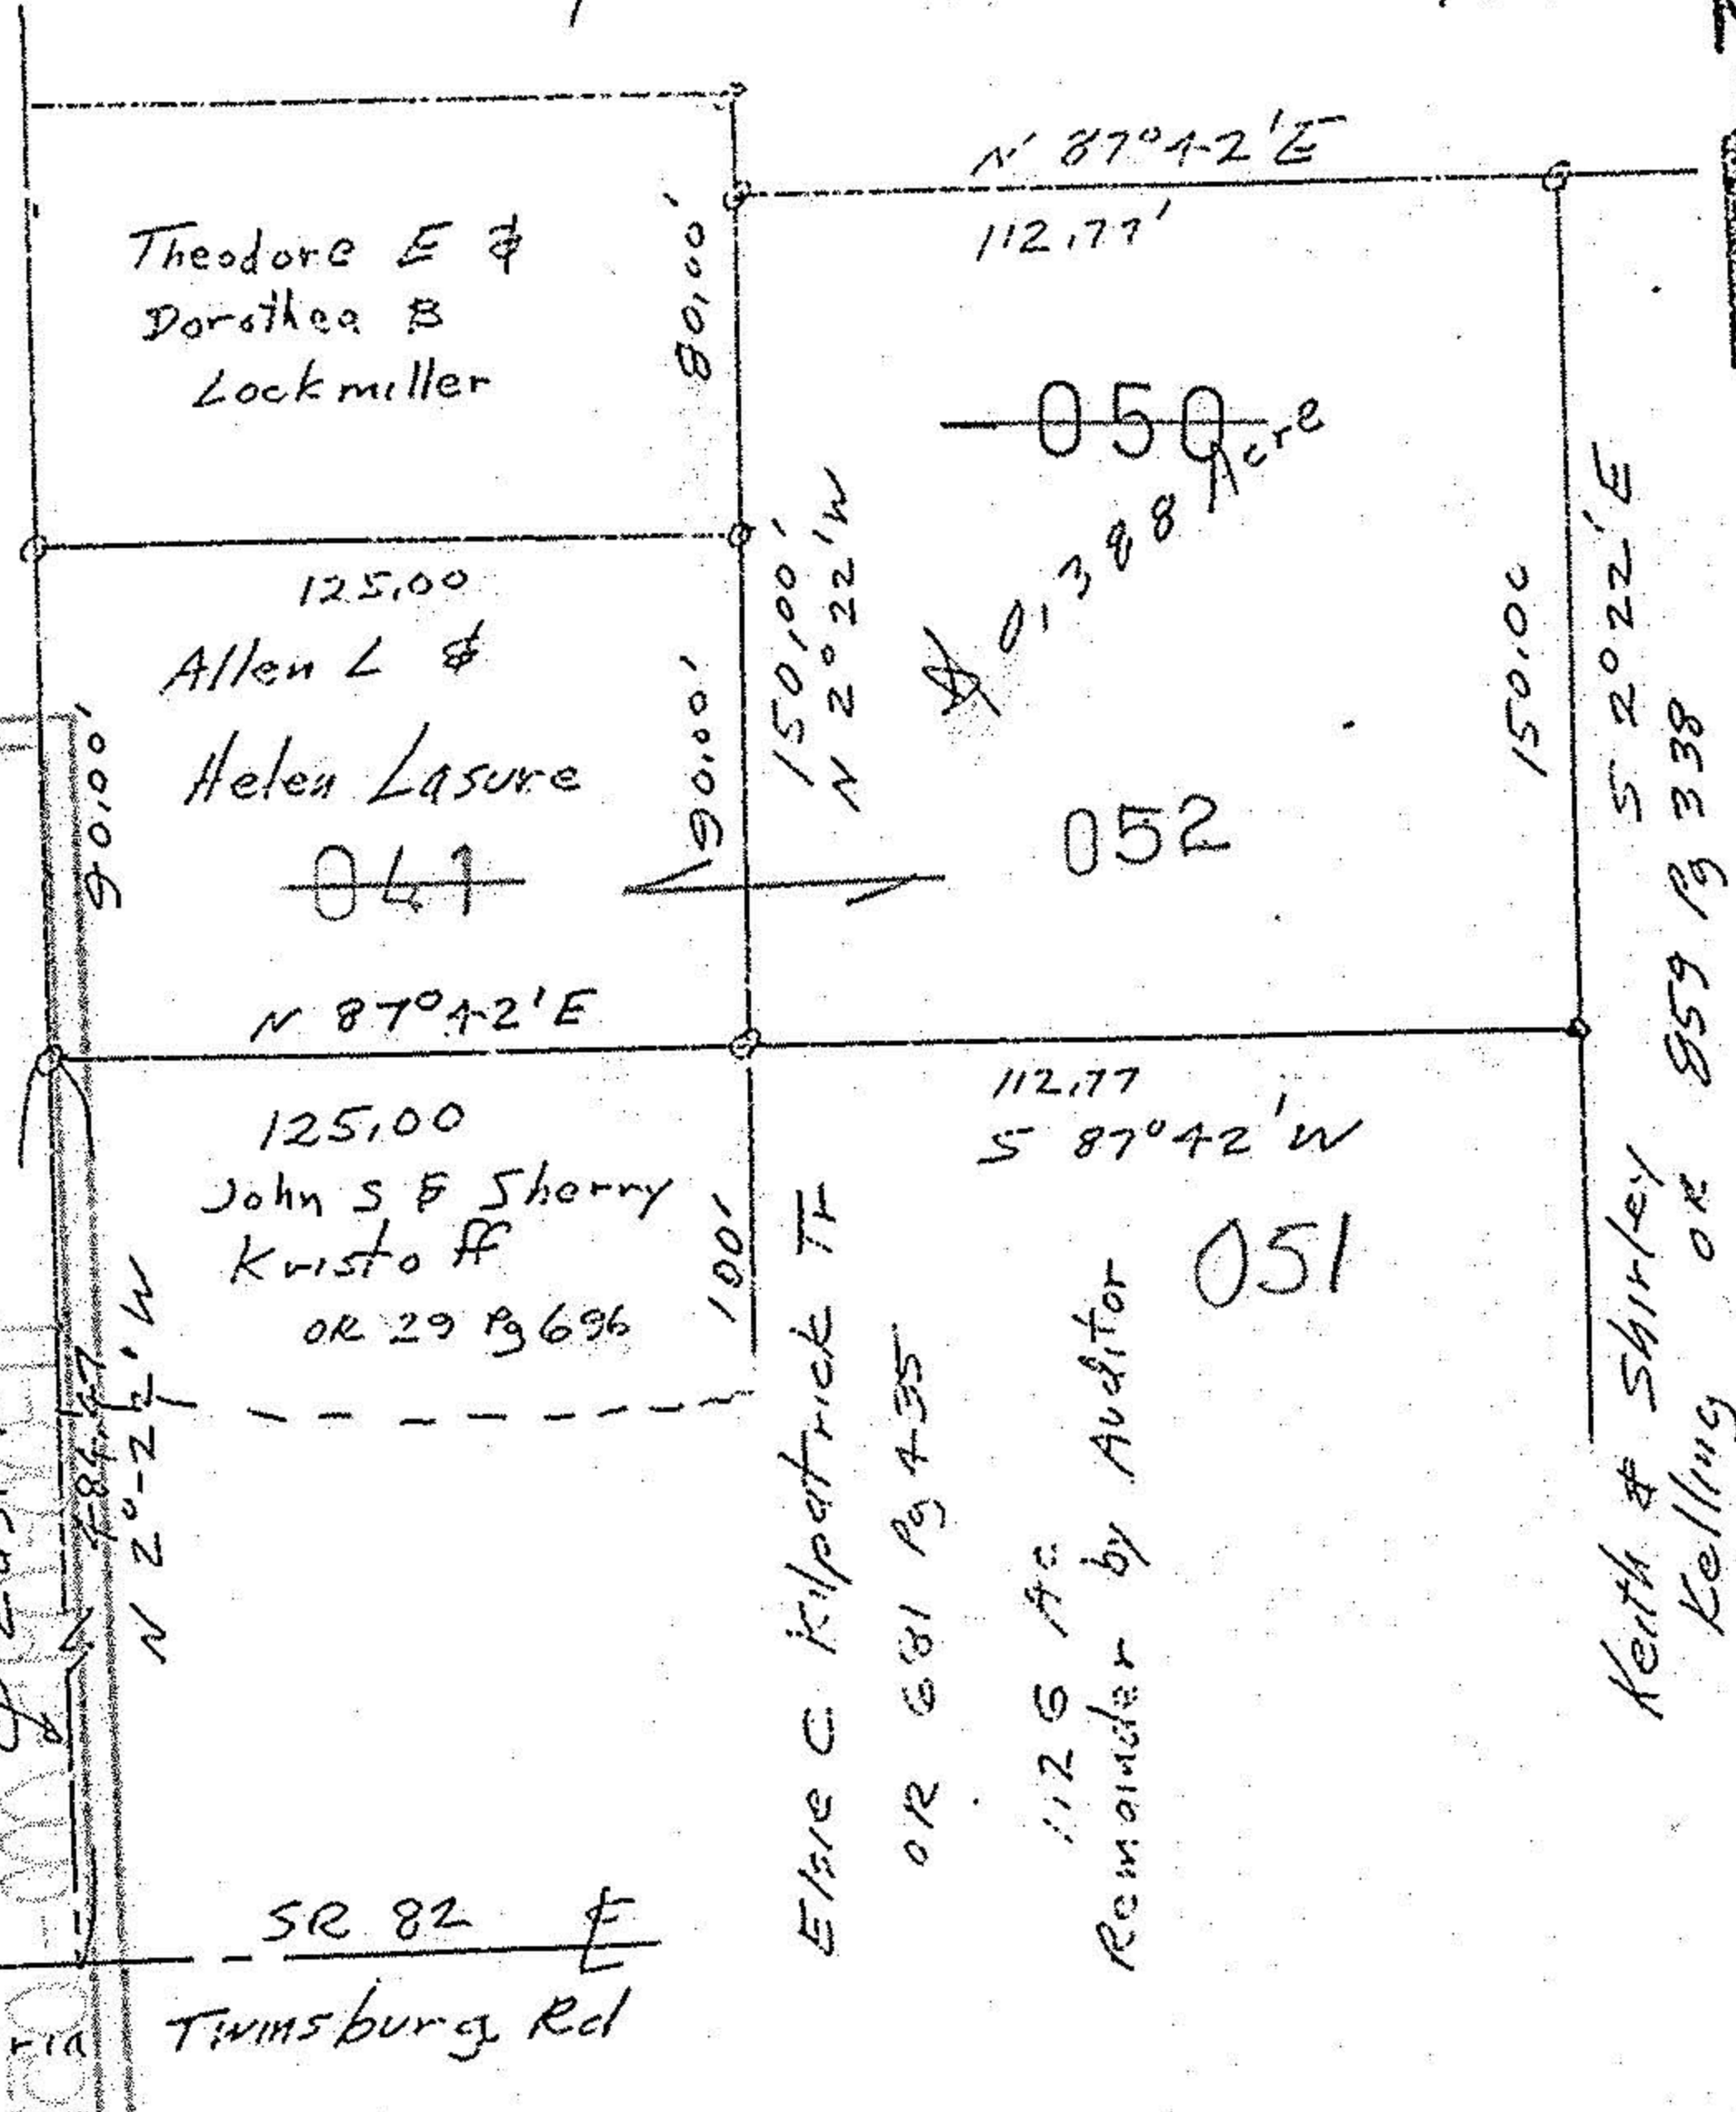

B.B. NO. 11-00-095-000-020

PAGE 11-00-095 B

NO. 5140

DATE

SUBJECT


11-00-095-000-020

(Eaton Twp Trustees)
Eastwood Drive

Eastwood Drive
N 87°42' E
N 20°22' W

SR 82
Elyria Twinsburg Rd

0 iron pipes fd
iron pipes set

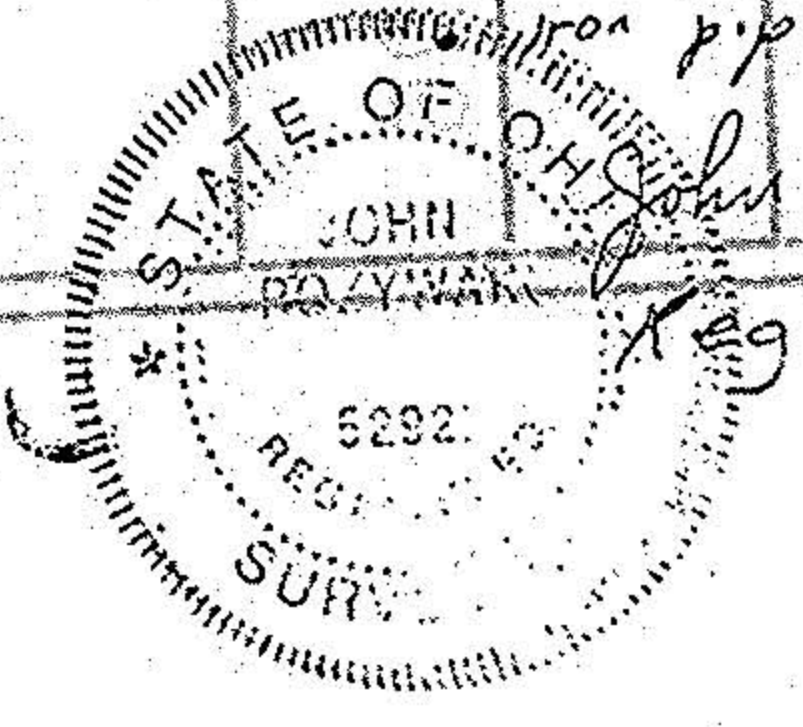

John Pogywale
Surveyor
5292

Survey of a Parcel Split
Original Lot 95 Eaton Township
Lorain County Ohio
Scale 1" = 60' Mar 25, 1995

21490

APPROVED LORAIN CO. MAP DEPT
DATE 9-14-95
PAGE 11-00-095 B
BY CAROLYN FRANCIS
#21490

11-00-095-000-