




LAUNDON • SIMON • CAHL & ASSOC., INC.  
CONSULTING ENGINEERS & SURVEYORS  
110 MIDDLE AVE., ELYRIA, O. 44035


SURVEY FOR:  
OSWALD O. & MARJORIE J.  
POULSEN

Orig. Lot	City of	Date DEC. '91 Scale 1"=100'
Orig. Sec. 6	Village of	Dwn. by R.G.S. Chkd. by R.C.
Tract	County of LORAIN	Job No. 91-2123 F.B.
Township of CARLISLE	State of OHIO	Printed DEC 26 1991

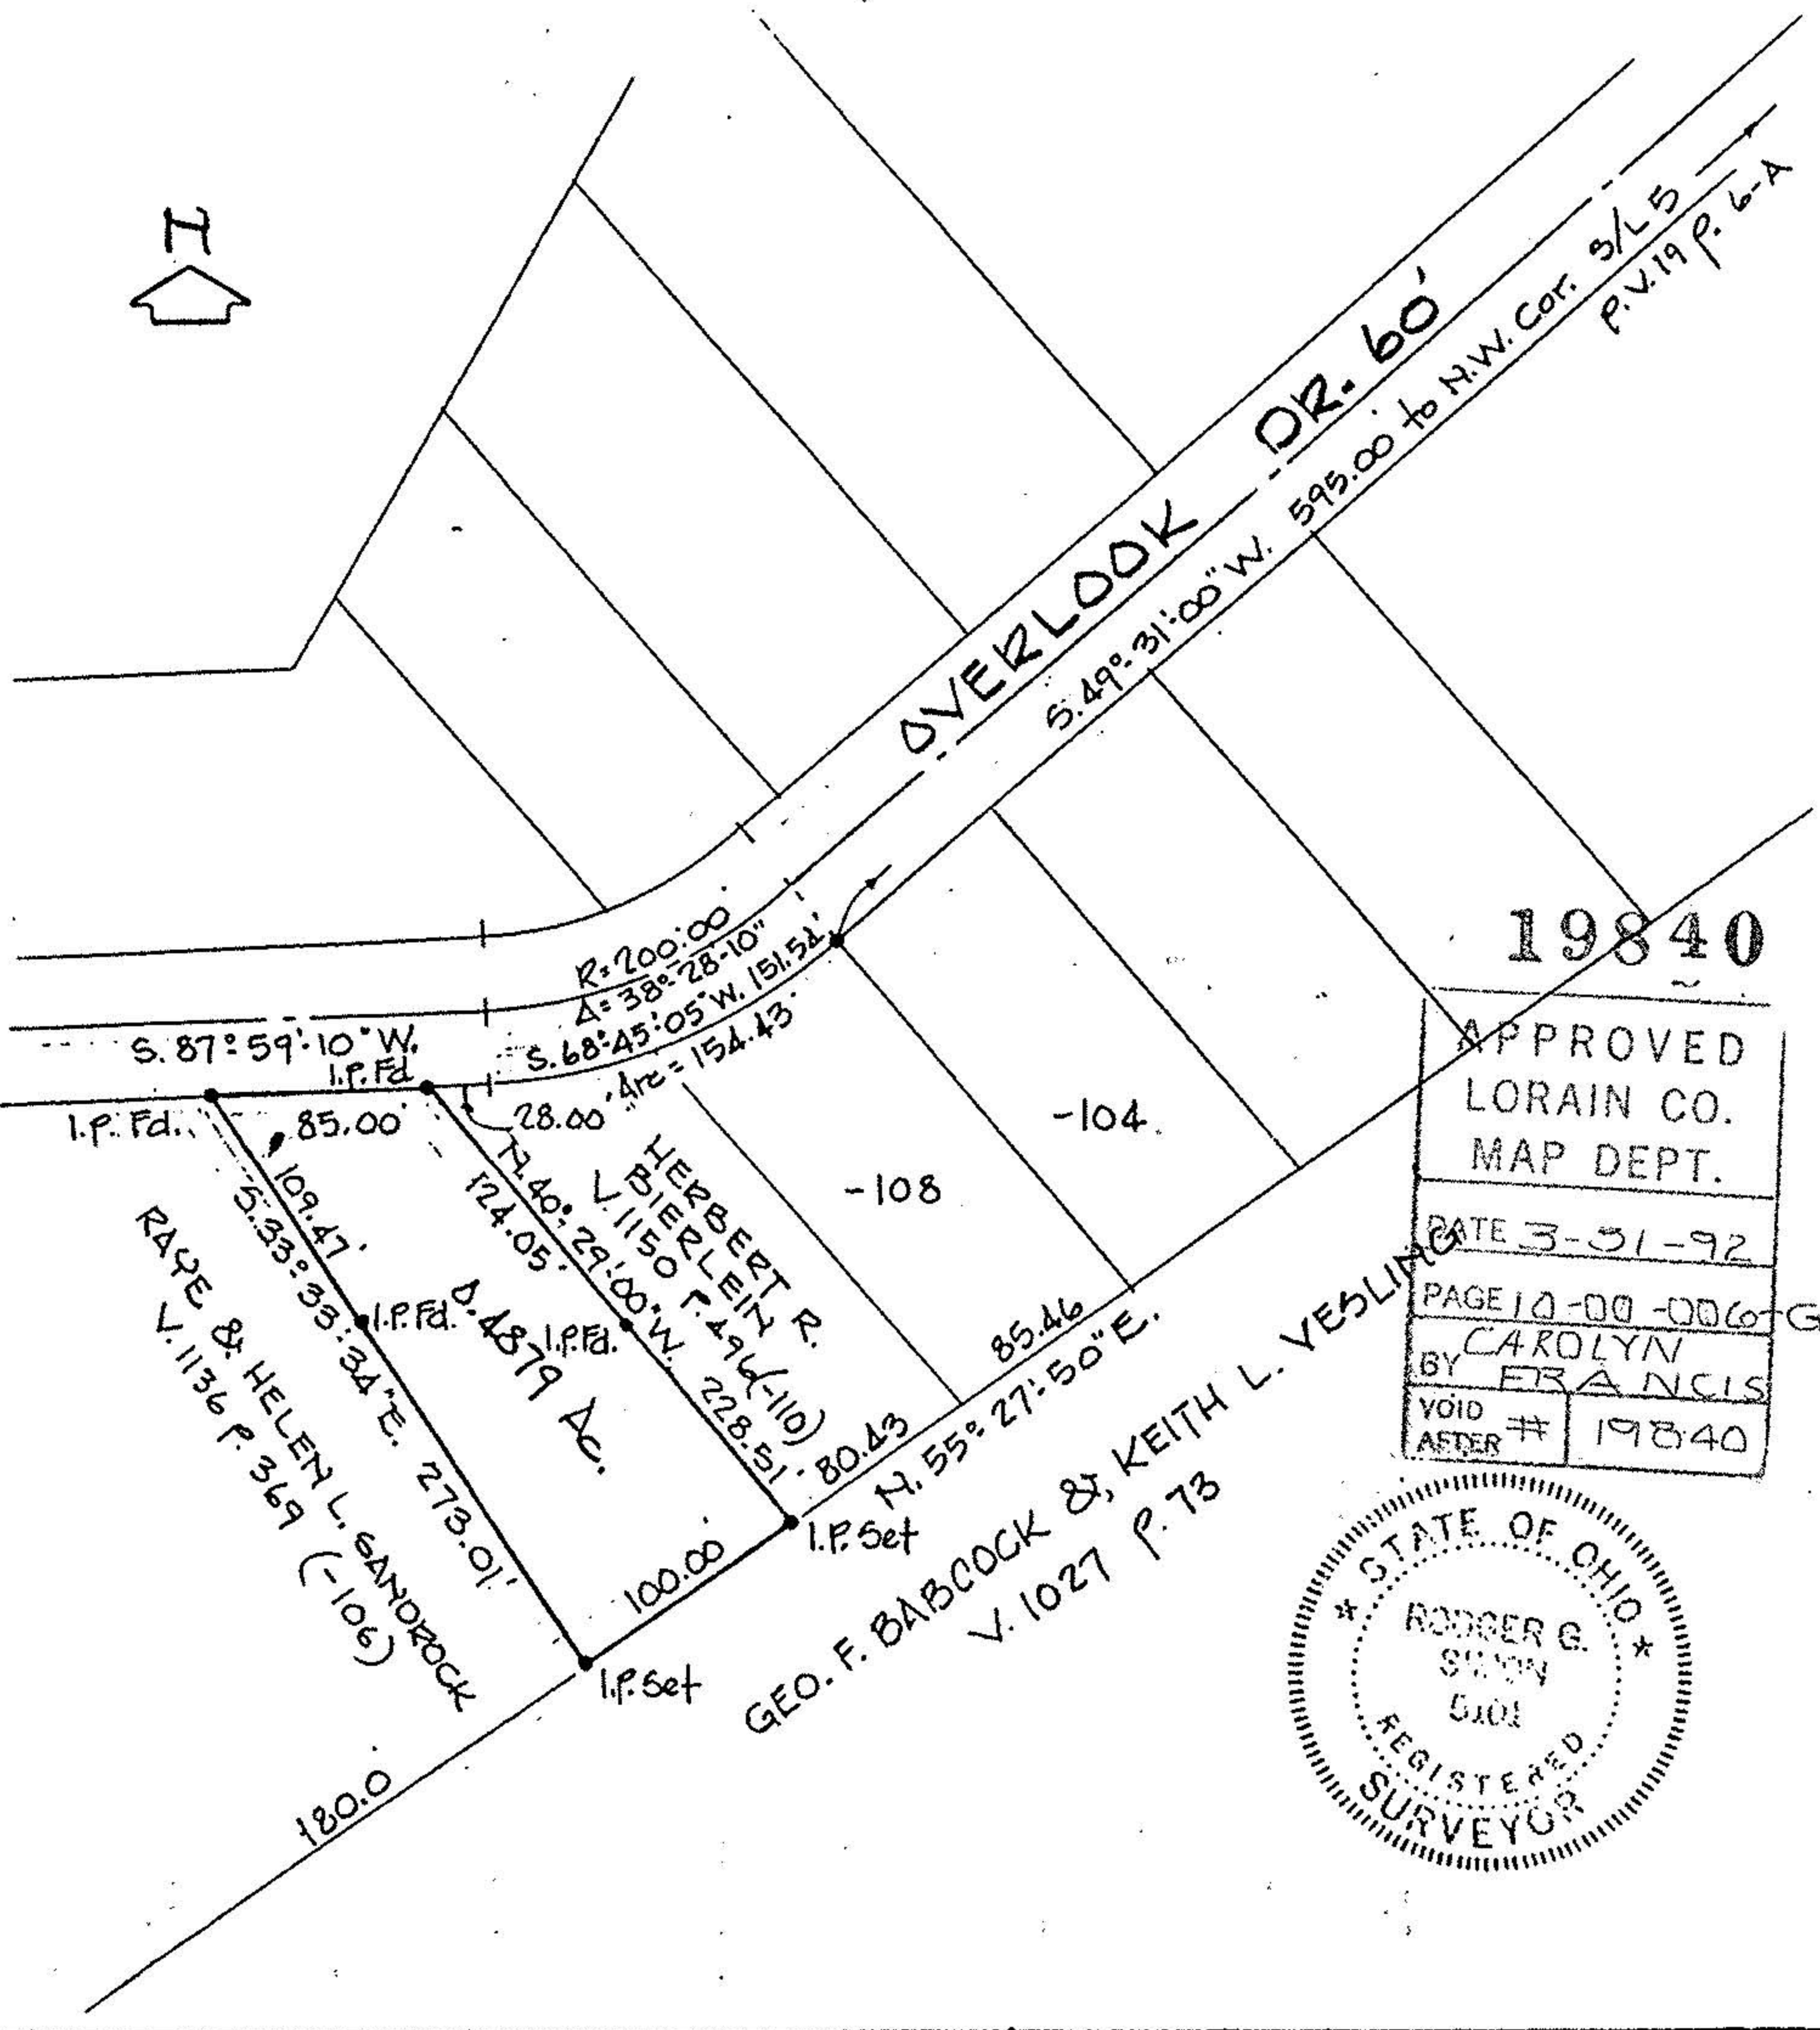

19840

APPROVED  
LORAIN CO.  
MAP DEPT.  
DATE 3-31-92  
PAGE 10-00-0060-G  
BY CAROLYN FRANCIS  
VOID AFTER # 19840

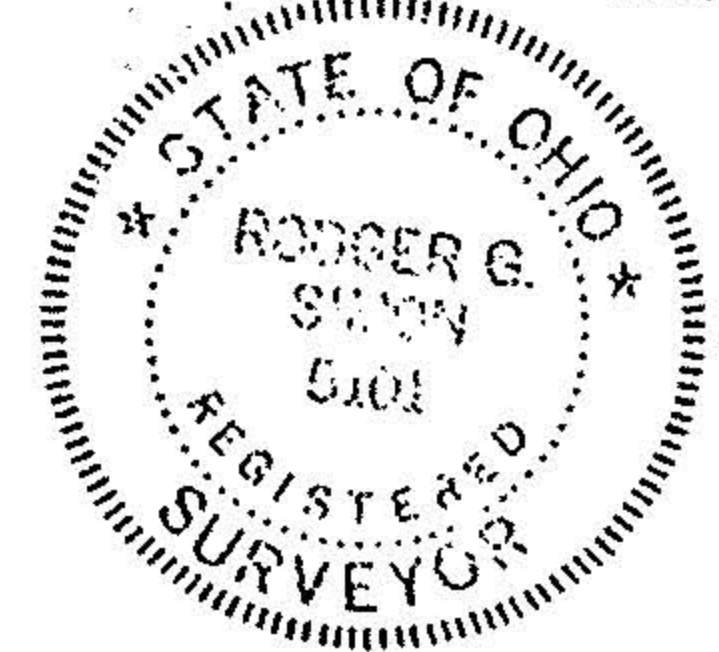

10-00-0060-G