




LAUNDON • SIMON • CAHL & ASSOC., INC.
 CONSULTING ENGINEERS & SURVEYORS
 110 MIDDLE AVE., ELYRIA, O. 44035

SURVEY FOR:
 OSWALD O. & MARJORIE POULSEN

Orig. Lot	City of	Date OCT. '94	Scale 1"=40'
Orig. Sec. 6	Village of	Dwn. by R.G.S.	Chkd. by R.C.
Tract	County of LORAIN	Job No. 94-2648	F.B.
Township of CARLISLE	State of OHIO	Printed	

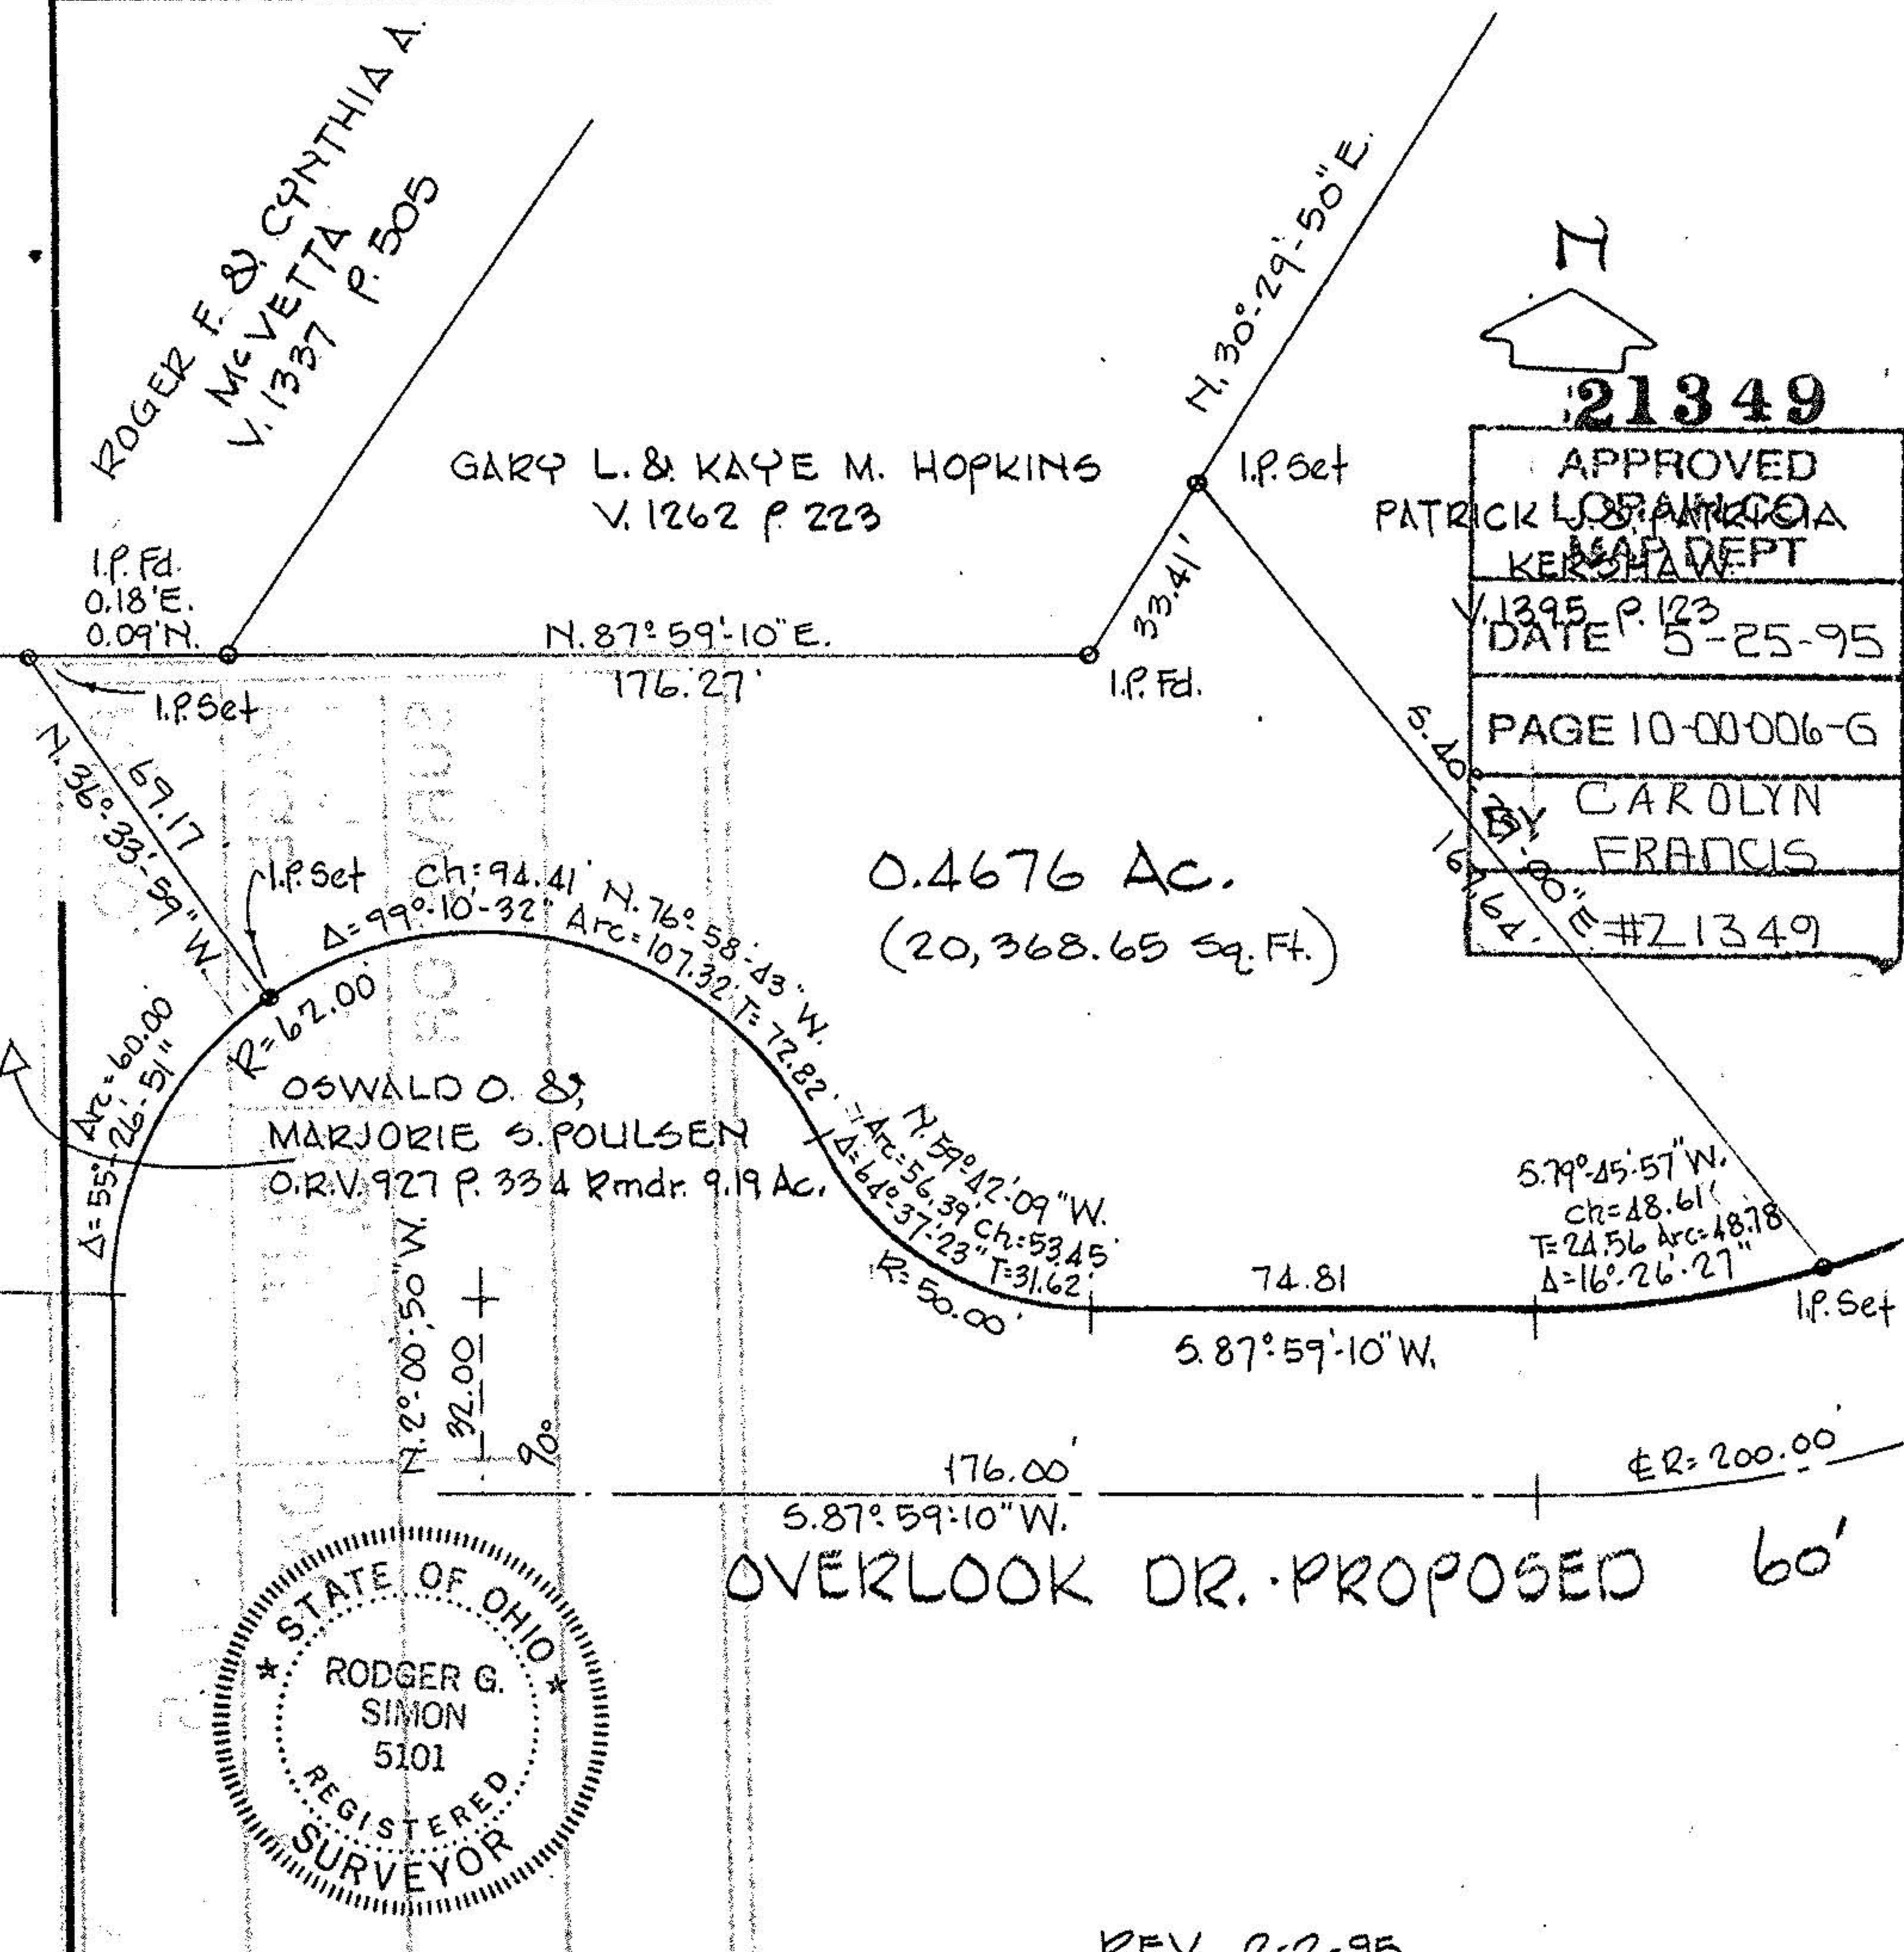

N

21349

APPROVED
PATRICK LOFRANCO MAP DEPT
V. 1395 P. 123 DATE 5-25-95
PAGE 10-00006-G
BY CAROLYN FRANCIS
#21349



REV. 2-2-95