


10-00-011-101-035 10-A

#12316

10-00-011-101-036

WEST RIDGE ROAD 60'

P.O. Box

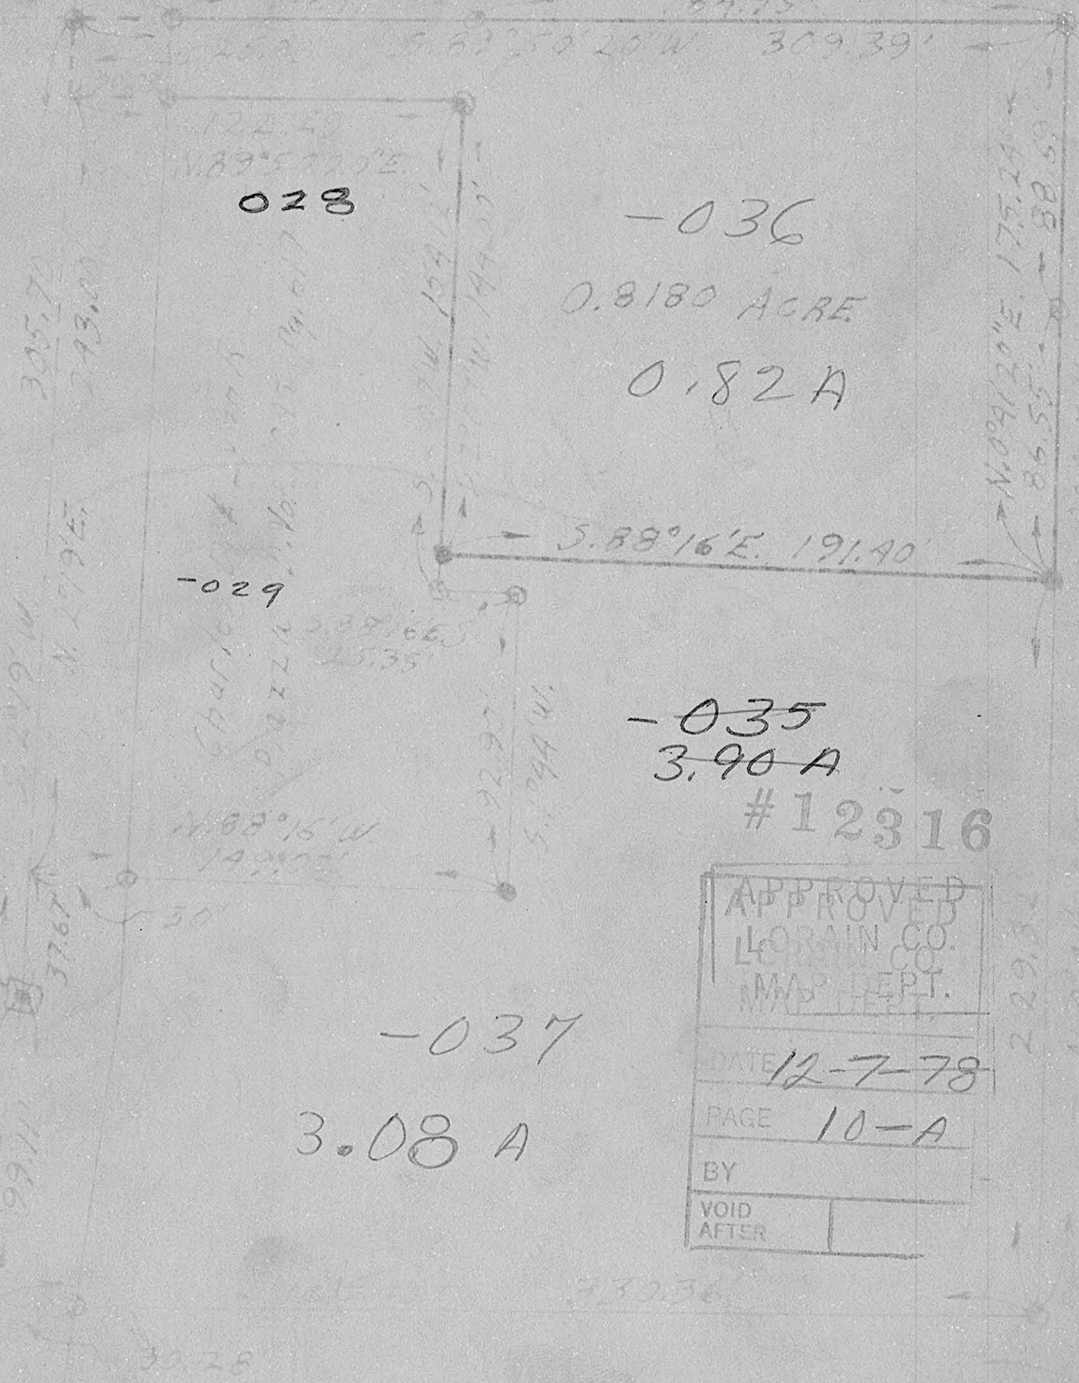

#12316

| | |
|------------|---------|
| APPROVED | |
| LORAIN CO. | |
| MAP DEPT. | |
| DATE | 12-7-78 |
| PAGE | 10-A |
| BY | |
| VOID AFTER | |

PLAT OF SURVEYING FOR DOMINIC MARY PIAZZA

10-A