


May 27-1954
 PORTER SUBN. NO. 1 90:00.
 PLAT. VOL. 16 PG. 30



PT OF SECTION 12
 CARLISLE TWP. LORAIN CO. OHIO
 SCALE 1" = 30' APRIL 8-1960
 C.E. Benford Reg. Surveyor

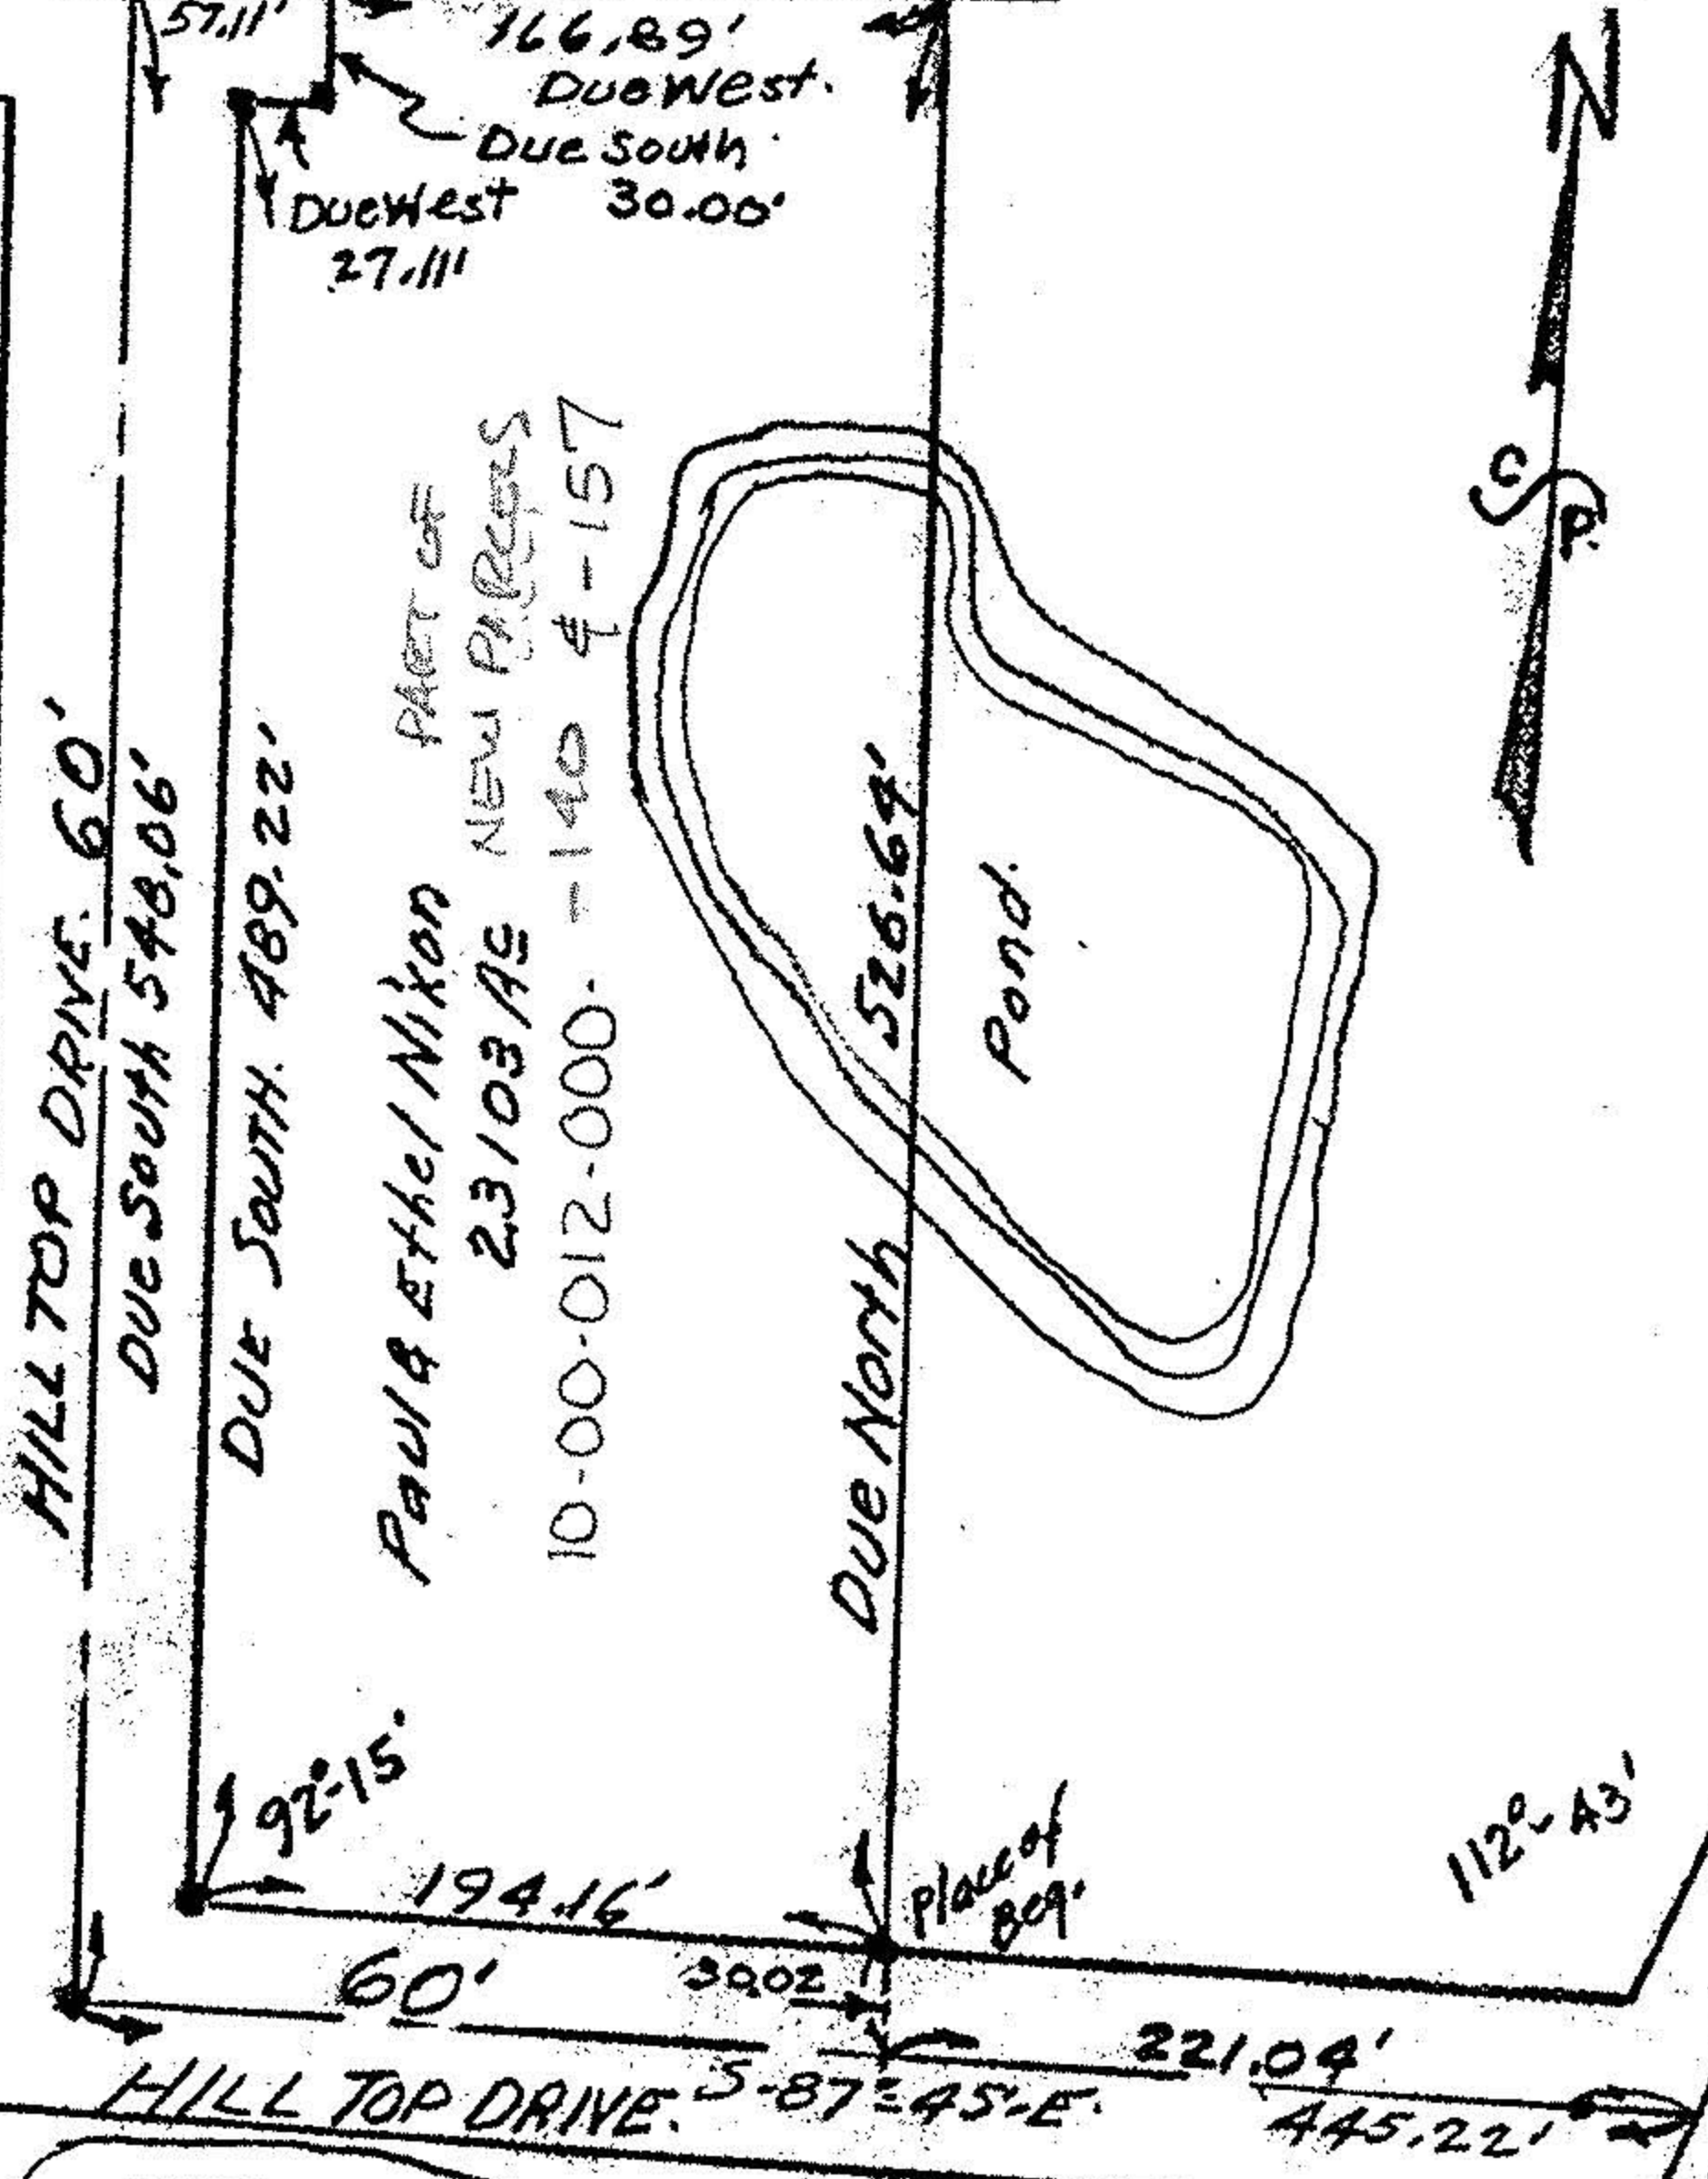