

CARDINAL SURVEYS
 PLAT OF SURVEY
 PREPARED FOR ROBERT ROBINSON

#15172

APPROVED
 LORAIN CO.
 MAP DEPT.


DATE 7.14.83

PAGE 10.00.016.B

BY T. McHain

VOID
 AFTER

10-20-010-000
 7110116

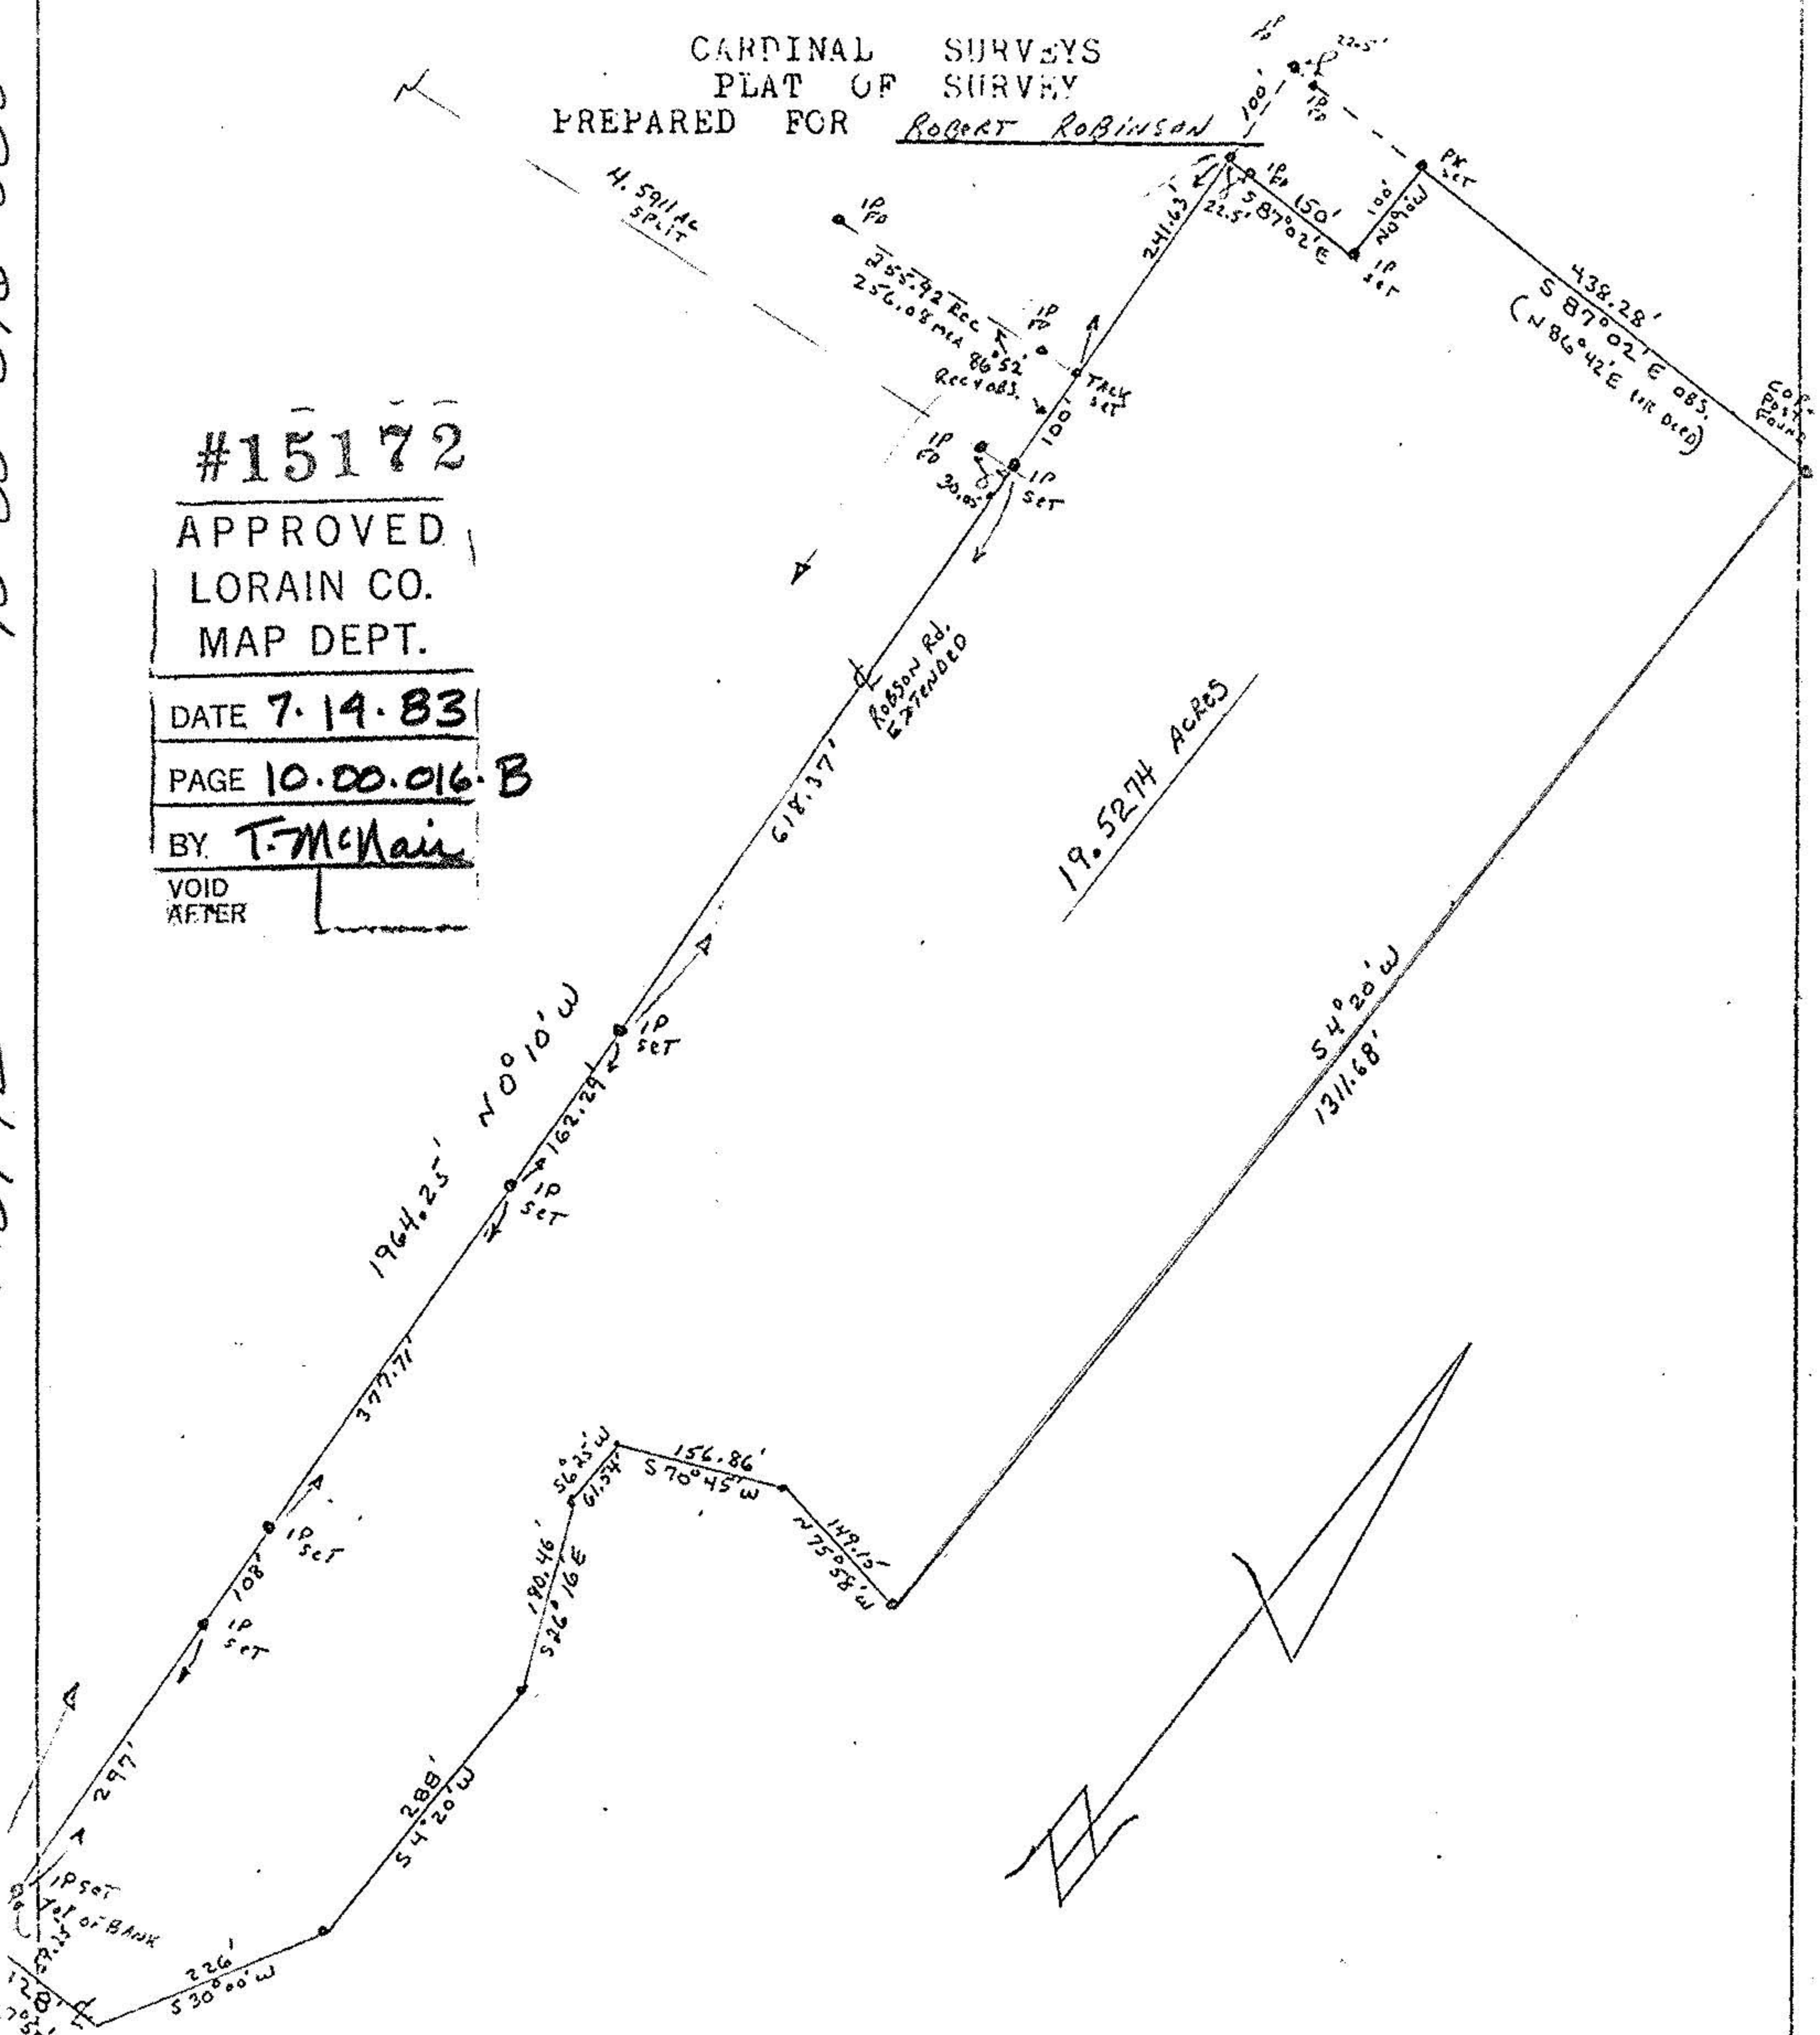

DATE: JUNE 4, 1983

SCALE: $1" = 200'$

SPLIT # 15172