


10-00-016-B

#17001

10-00-016-000

CARDINAL SURVEYS
PLAT OF SURVEY
PREPARED FOR BOB & BARB ROBINSON

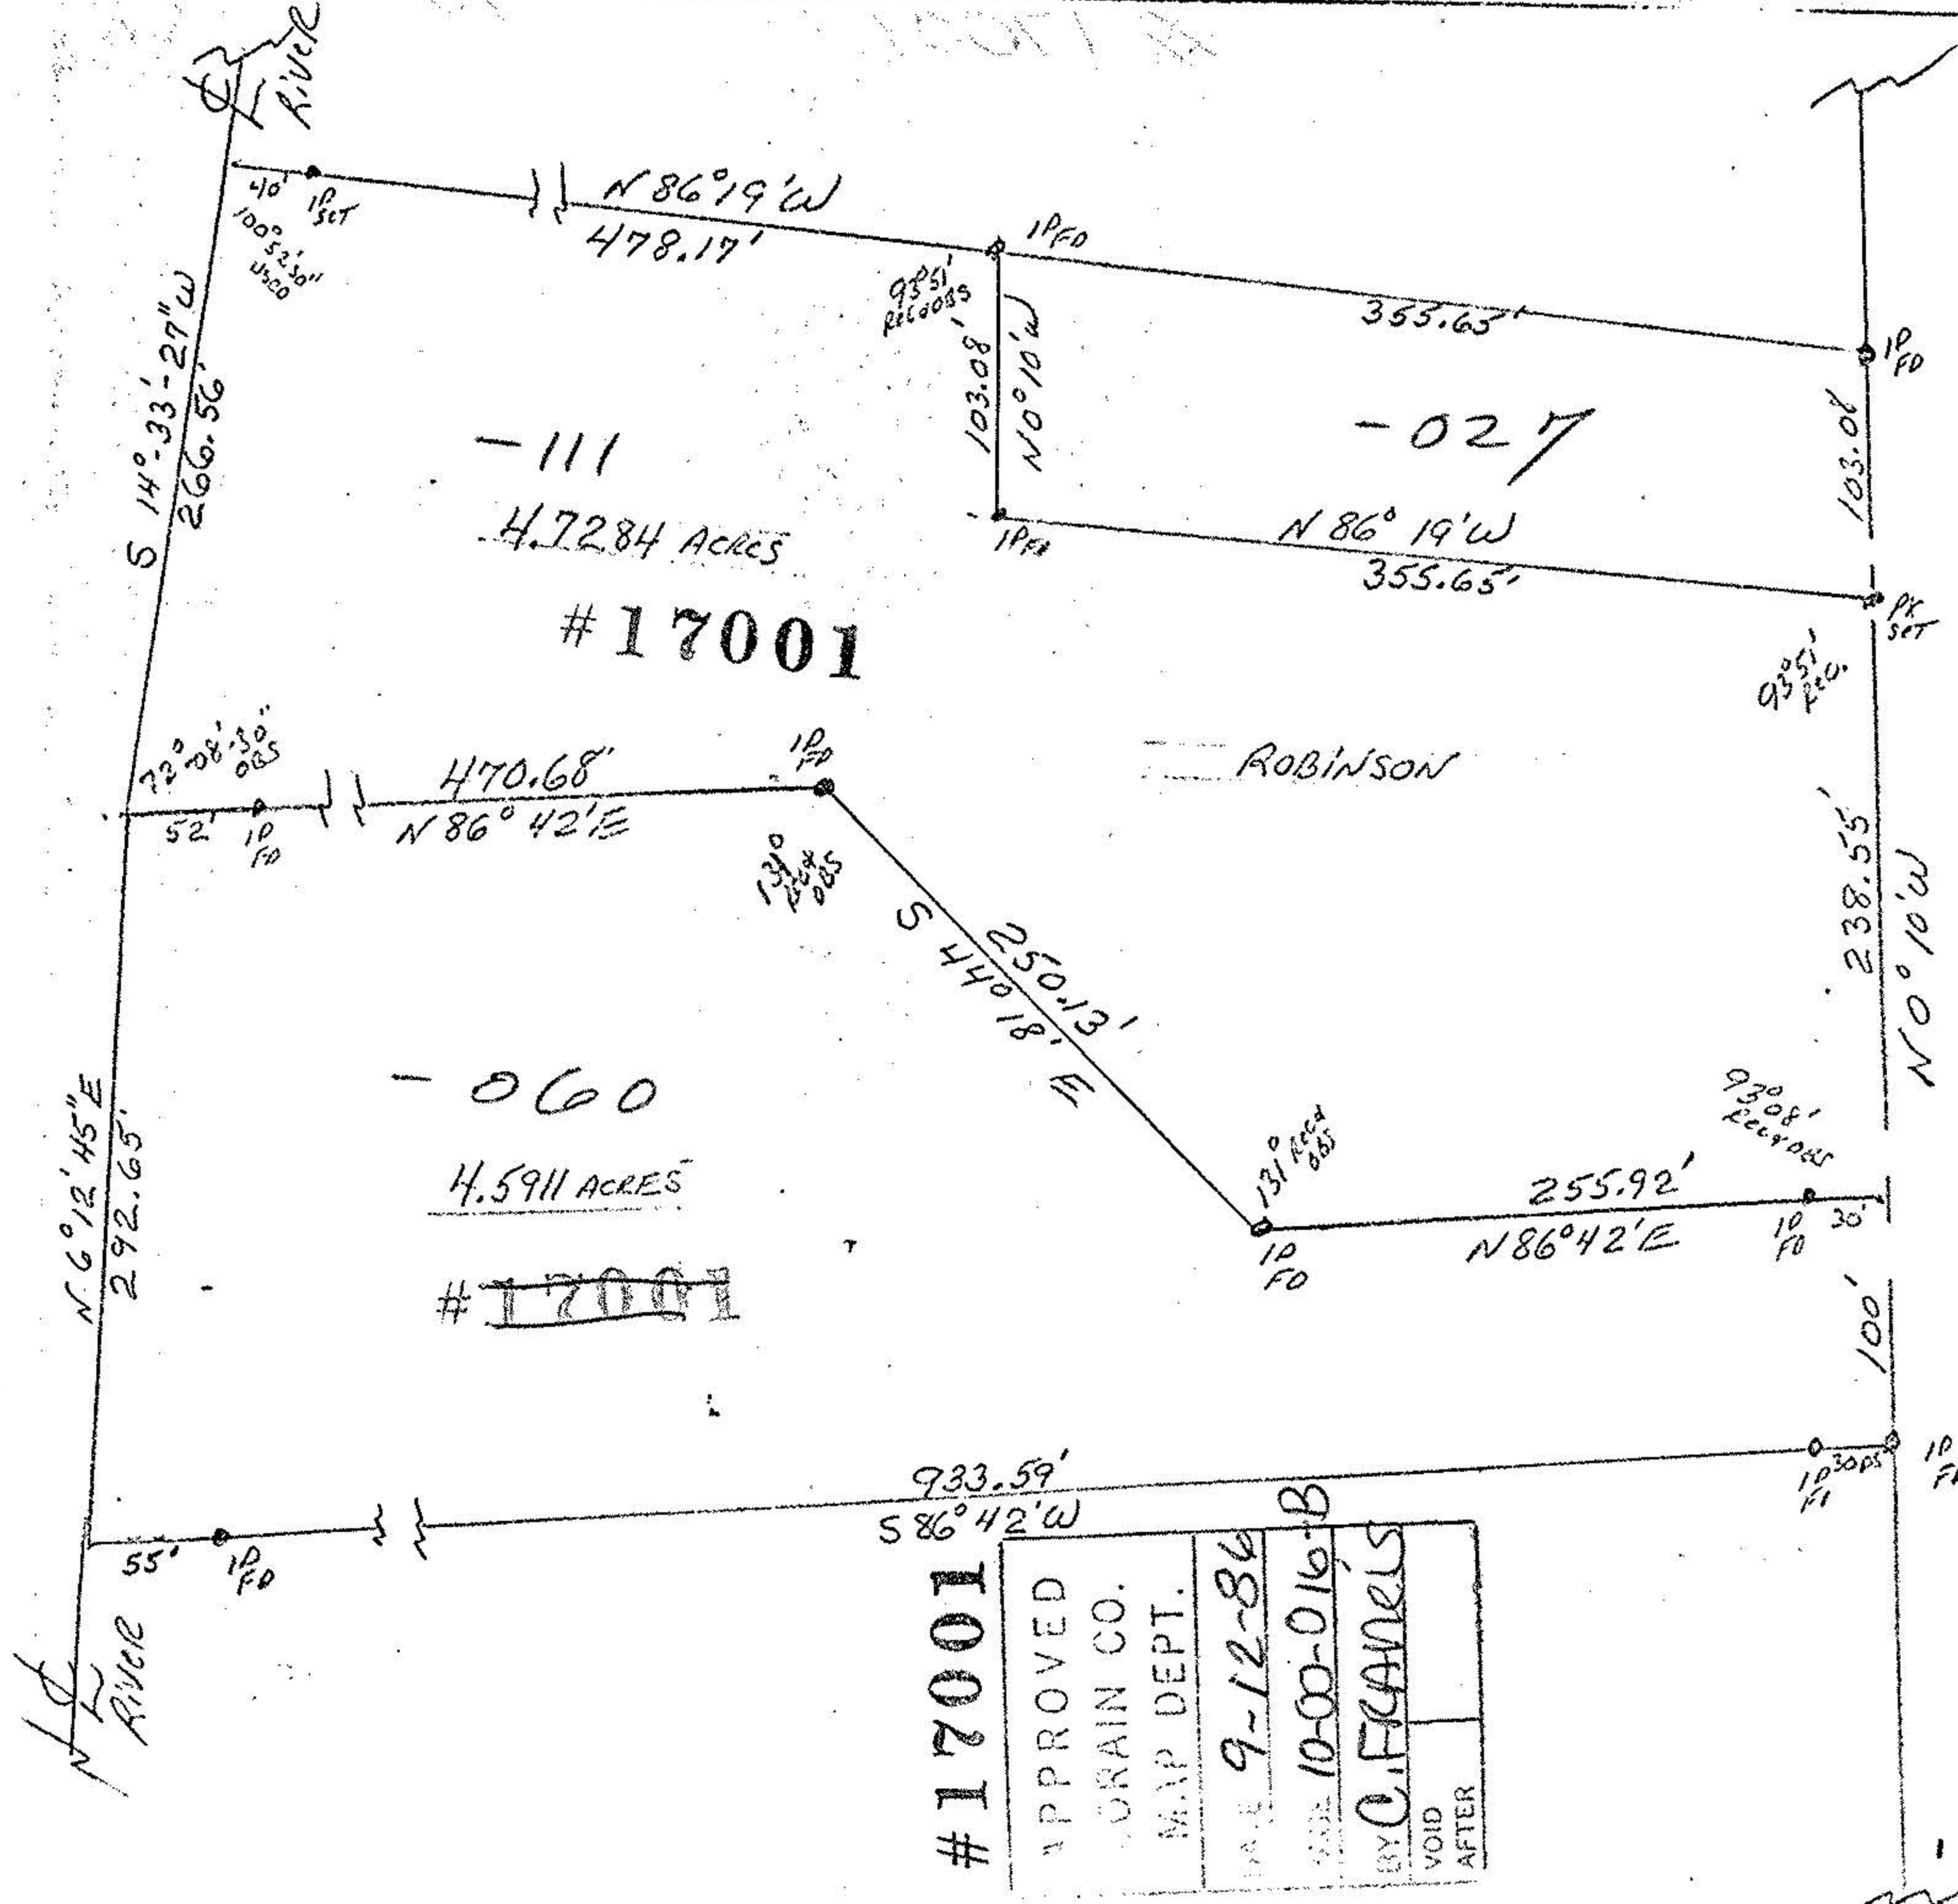

SCALE: 1"=100'



#17001

APPROVED
CORAIN CO.
MAP DEPT.
DATE 9-12-86
CODE 10-00-016-B
BY C. FRANKS
VOID AFTER

DATE: AUG. 26, 1986