


SLIFE RD.



about 1385.72'

S-9°-33'-E.

Rhoda Sayers, Charles Borling Jr.
& Carol Carr.
D. Vol. 575 Pg 172 June 1-1953

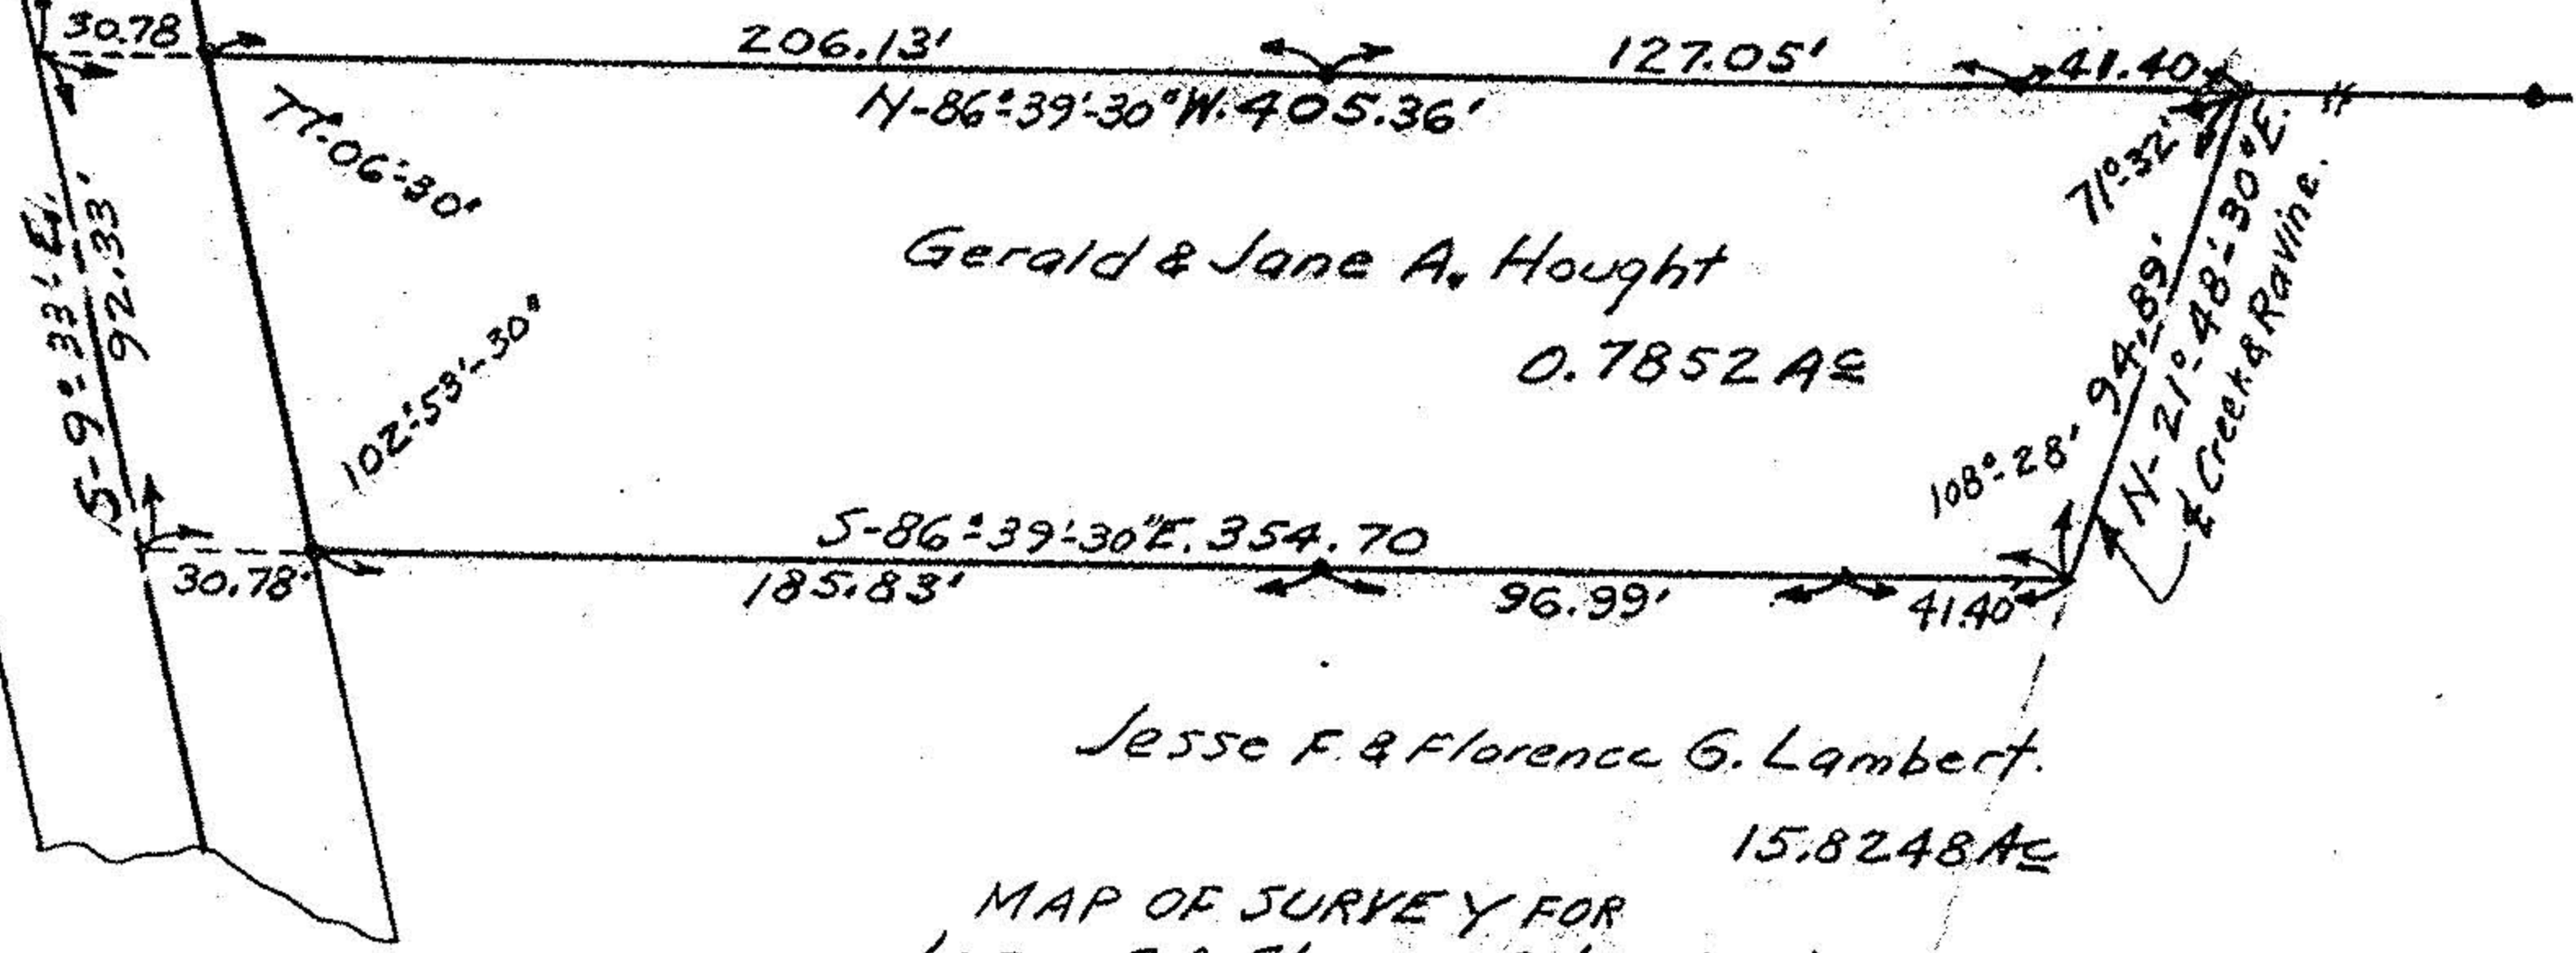

Gerald & Jane A. Hought
0.7852 AC

Jesse F. & Florence G. Lambert.
15.8248 AC

MAP OF SURVEY FOR
Jesse F. & Florence G. Lambert.
CARLISLE TWP. SECTION NO. 16
LORAIN COUNTY OHIO
SCALE 1" = 60' MARCH 12-1955
C.E. Penfound Registered Surveyor.