
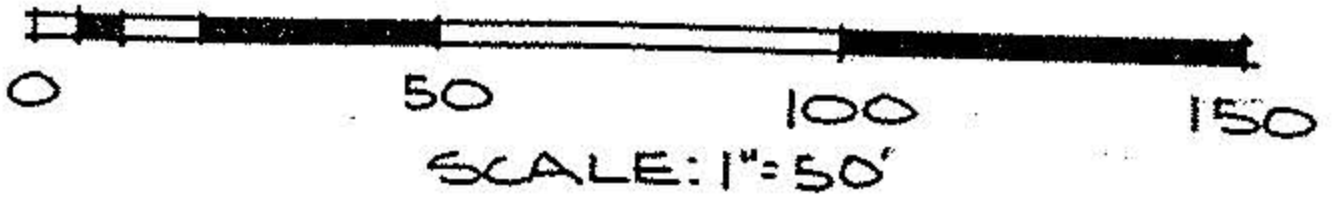


NORTH

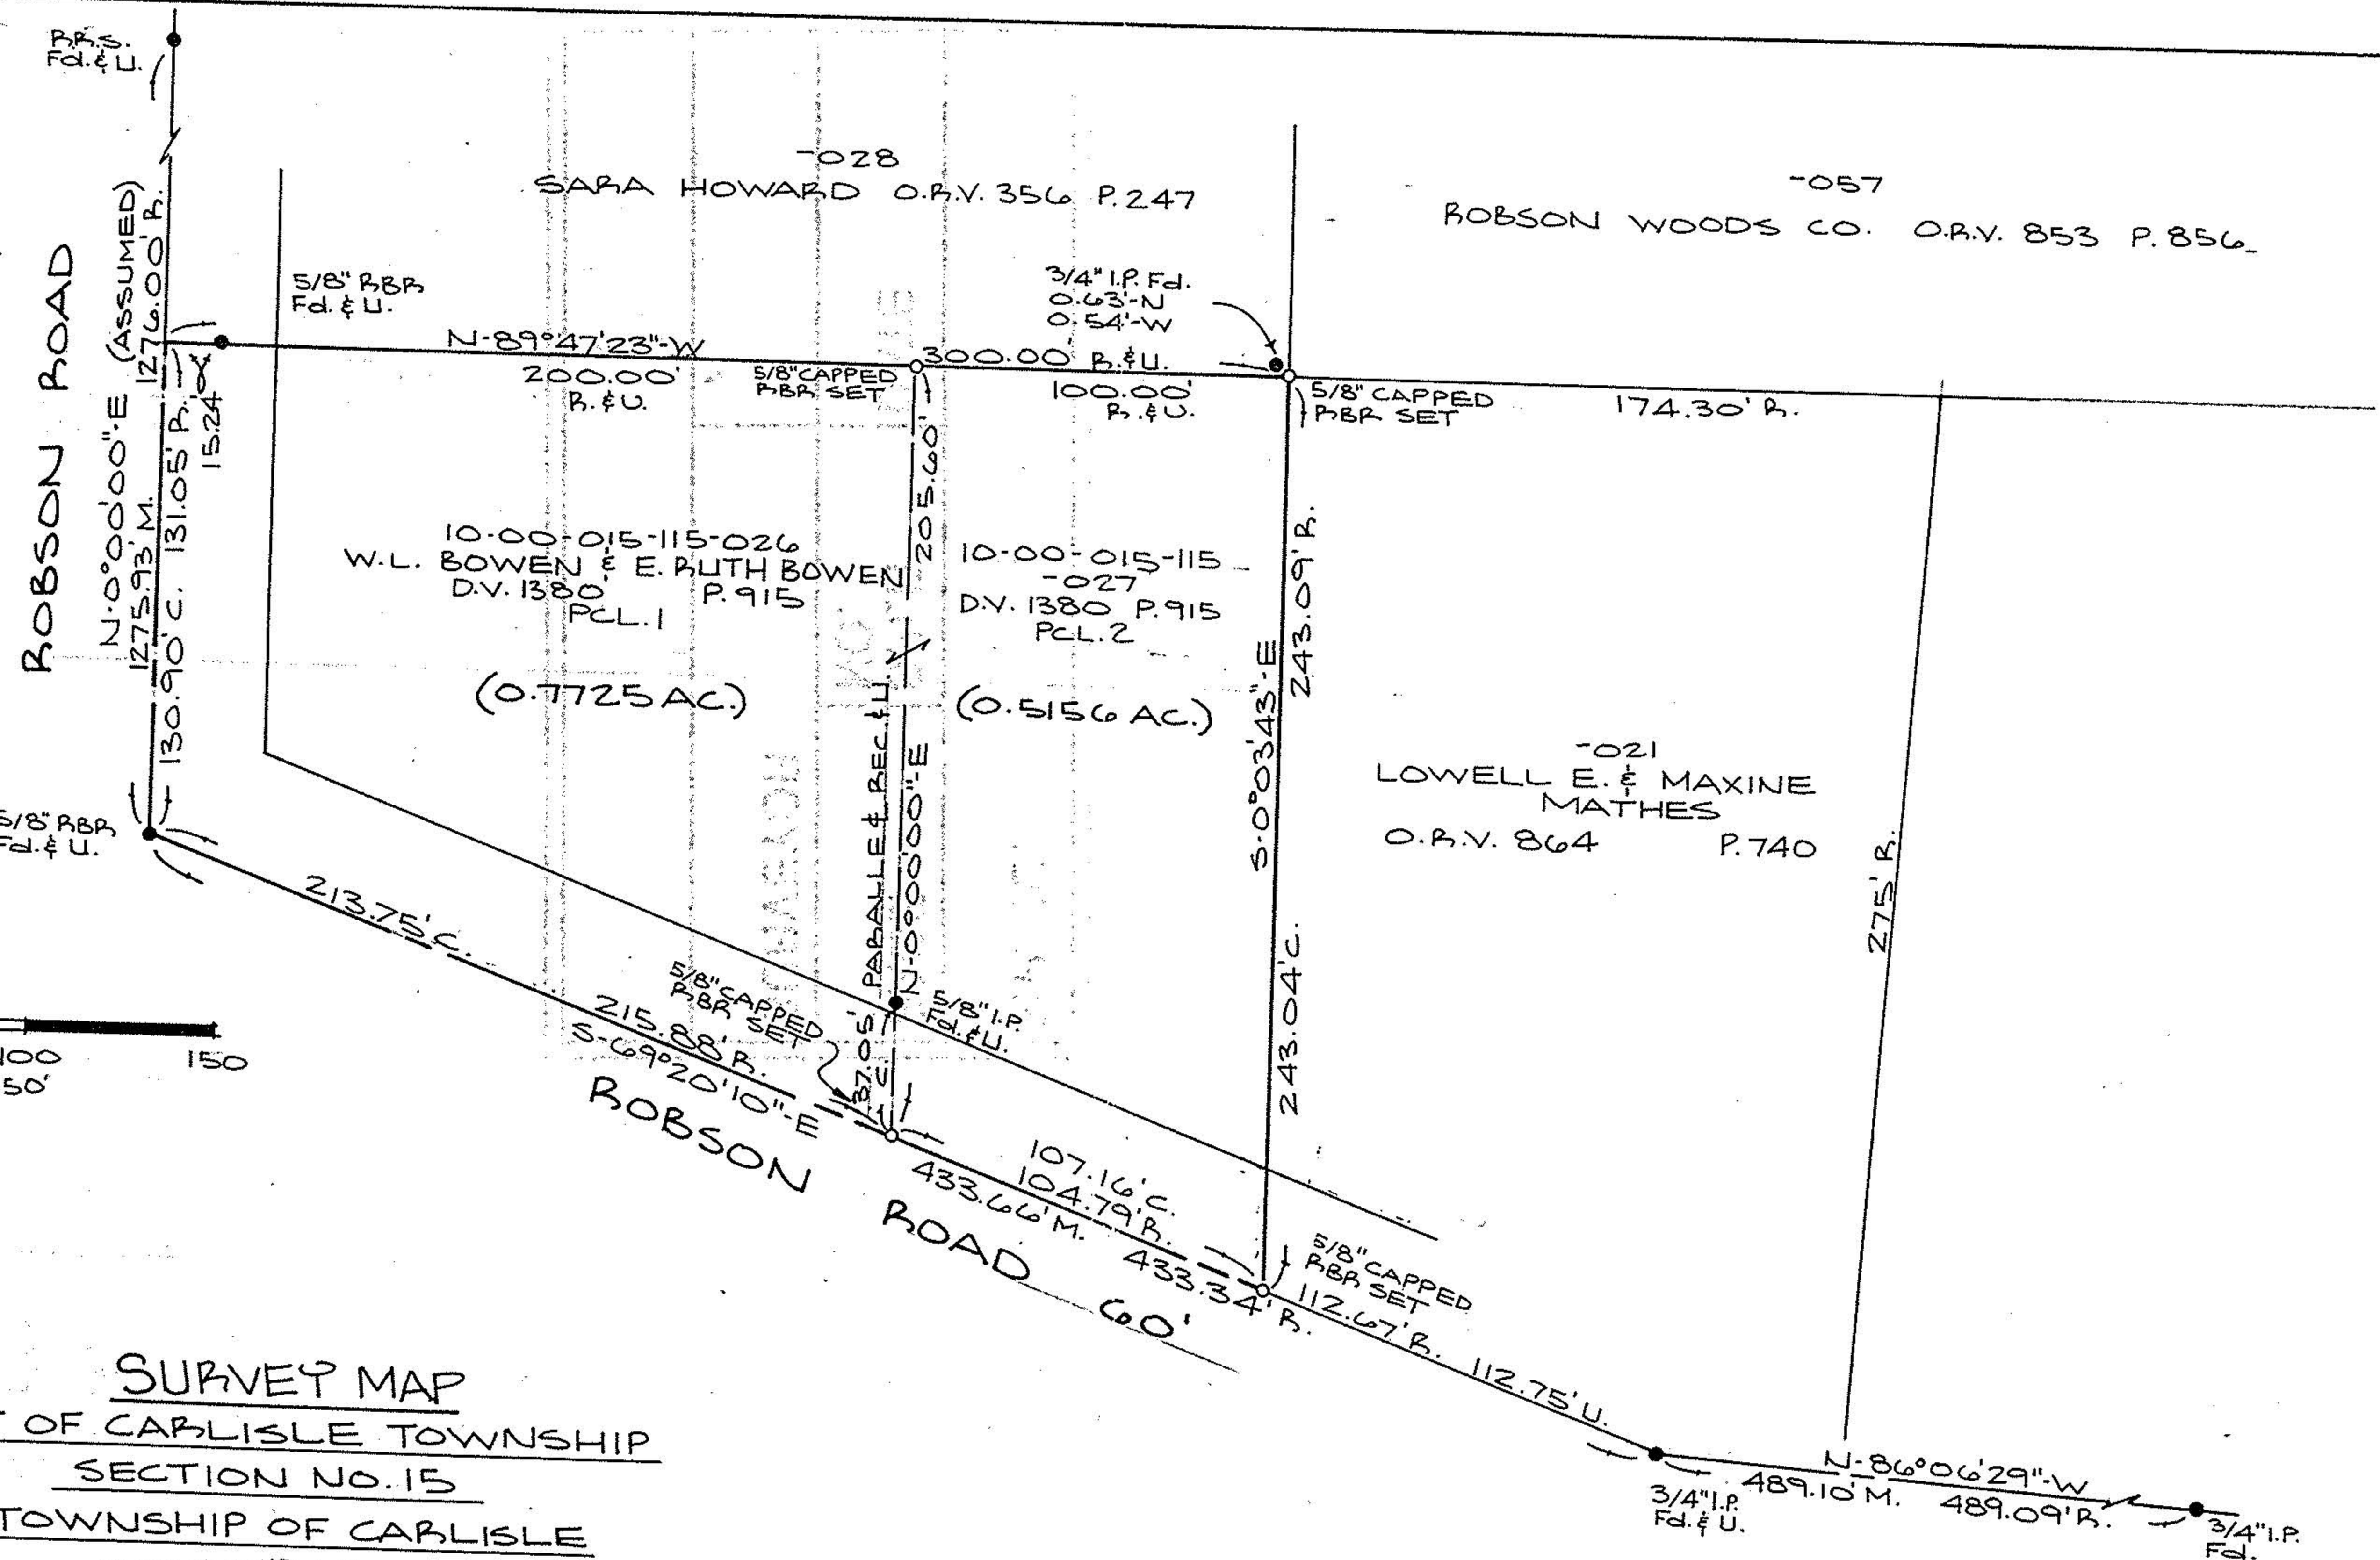

SURVEY MAP
PART OF CARLISLE TOWNSHIP
SECTION NO. 15
TOWNSHIP OF CARLISLE
COUNTY OF LOBAIN
STATE OF OHIO
 01-12-96

PREPARED BY:
KS ASSOCIATES, INC.
 ENGINEERS SURVEYORS

David L. Elwell
 REG. SURV. NO. 6333



#21641
 3/6/96
 10-00-015-F
 C. E. FRANCIS