

ROBSON RD

I.P.F.D

N 73° 10' - 48" W 433.34 P

#255

ROBSON RD 60'

N 89° 57' - 23" W 489.14 OBS

I.P.F.D DUE EAST 1660.10 OBS

I.P.F.D

I.P.F.D

212.06 R.F.U

200.

77.08

122.92

DATE: MAY 1999
SCALE: 1"=60'

JEFFREY & LINDA KRAPS
O.R. 394 / 111

N 0° 30' 10" E 377.50 ± R.F.U

2.2956 AC.
O.L. 15 1.73 AC
O.L. 16 0.57 AC

N 0° 30' 10" E 500. ±

2.3208 AC
O.L. 15 1.76 AC
O.L. 16 0.56 AC

DUE SOUTH 500. ±

SURVEY
OF PART OF
CARLISLE TOWNSHIP
LOT 15 & 16
COUNTY OF LORAIN STATE OF OHIO

LOT 15
LOT 16

LOT 15
LOT 16

USED SURVEY
OF K.S. & MOSLEY TO
VERIFY ANGLE SOUTH
OF LOT LINE

122.50
N 0° 30' 10" E

REBAR FO 0.345

REBAR SET

REBAR SET

REBAR SET

N 89° 57' - 23" W 260.


N 89° 58' - 42" W 204.39

WIRE FENCE FO.
6 FT ± EAST OF R.F.

PREPARED FOR:
DUANE DURKEE
13290 DURKEE RD
GRAFTON, OHIO

PREPARED BY:
HAPONEK & ASSOC INC
SURVEYORS
N. RIDGEVILLE, OH.

MICHAEL KOHARSKI
O.V. 1323 / 681

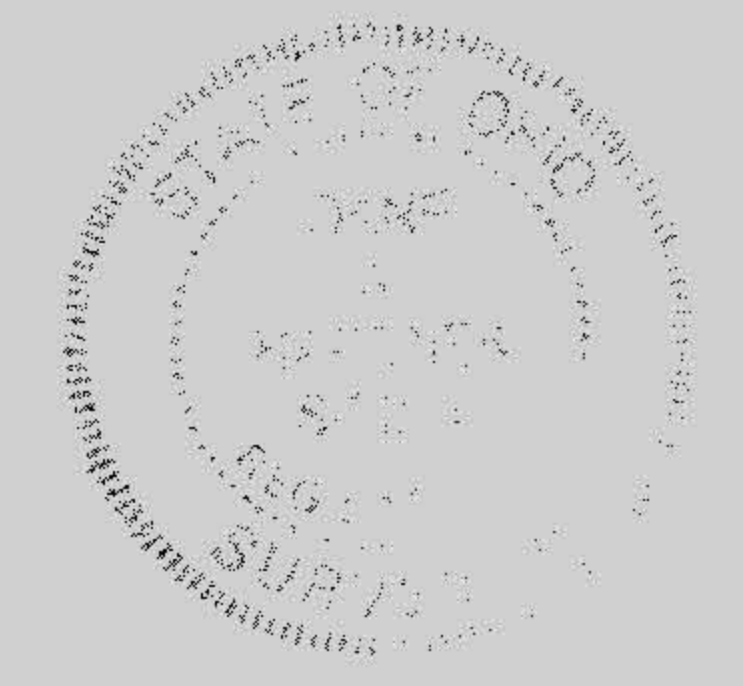

#00255
APPROVED
LORAIN CO.
MAP DEPT.
DATE 11/18/99
CASE 10-00-015-G # 016-C
BY 7. [Signature]
#00255