


APR 29 1977



SLIFE RD.

M.B. used

10452
10000167

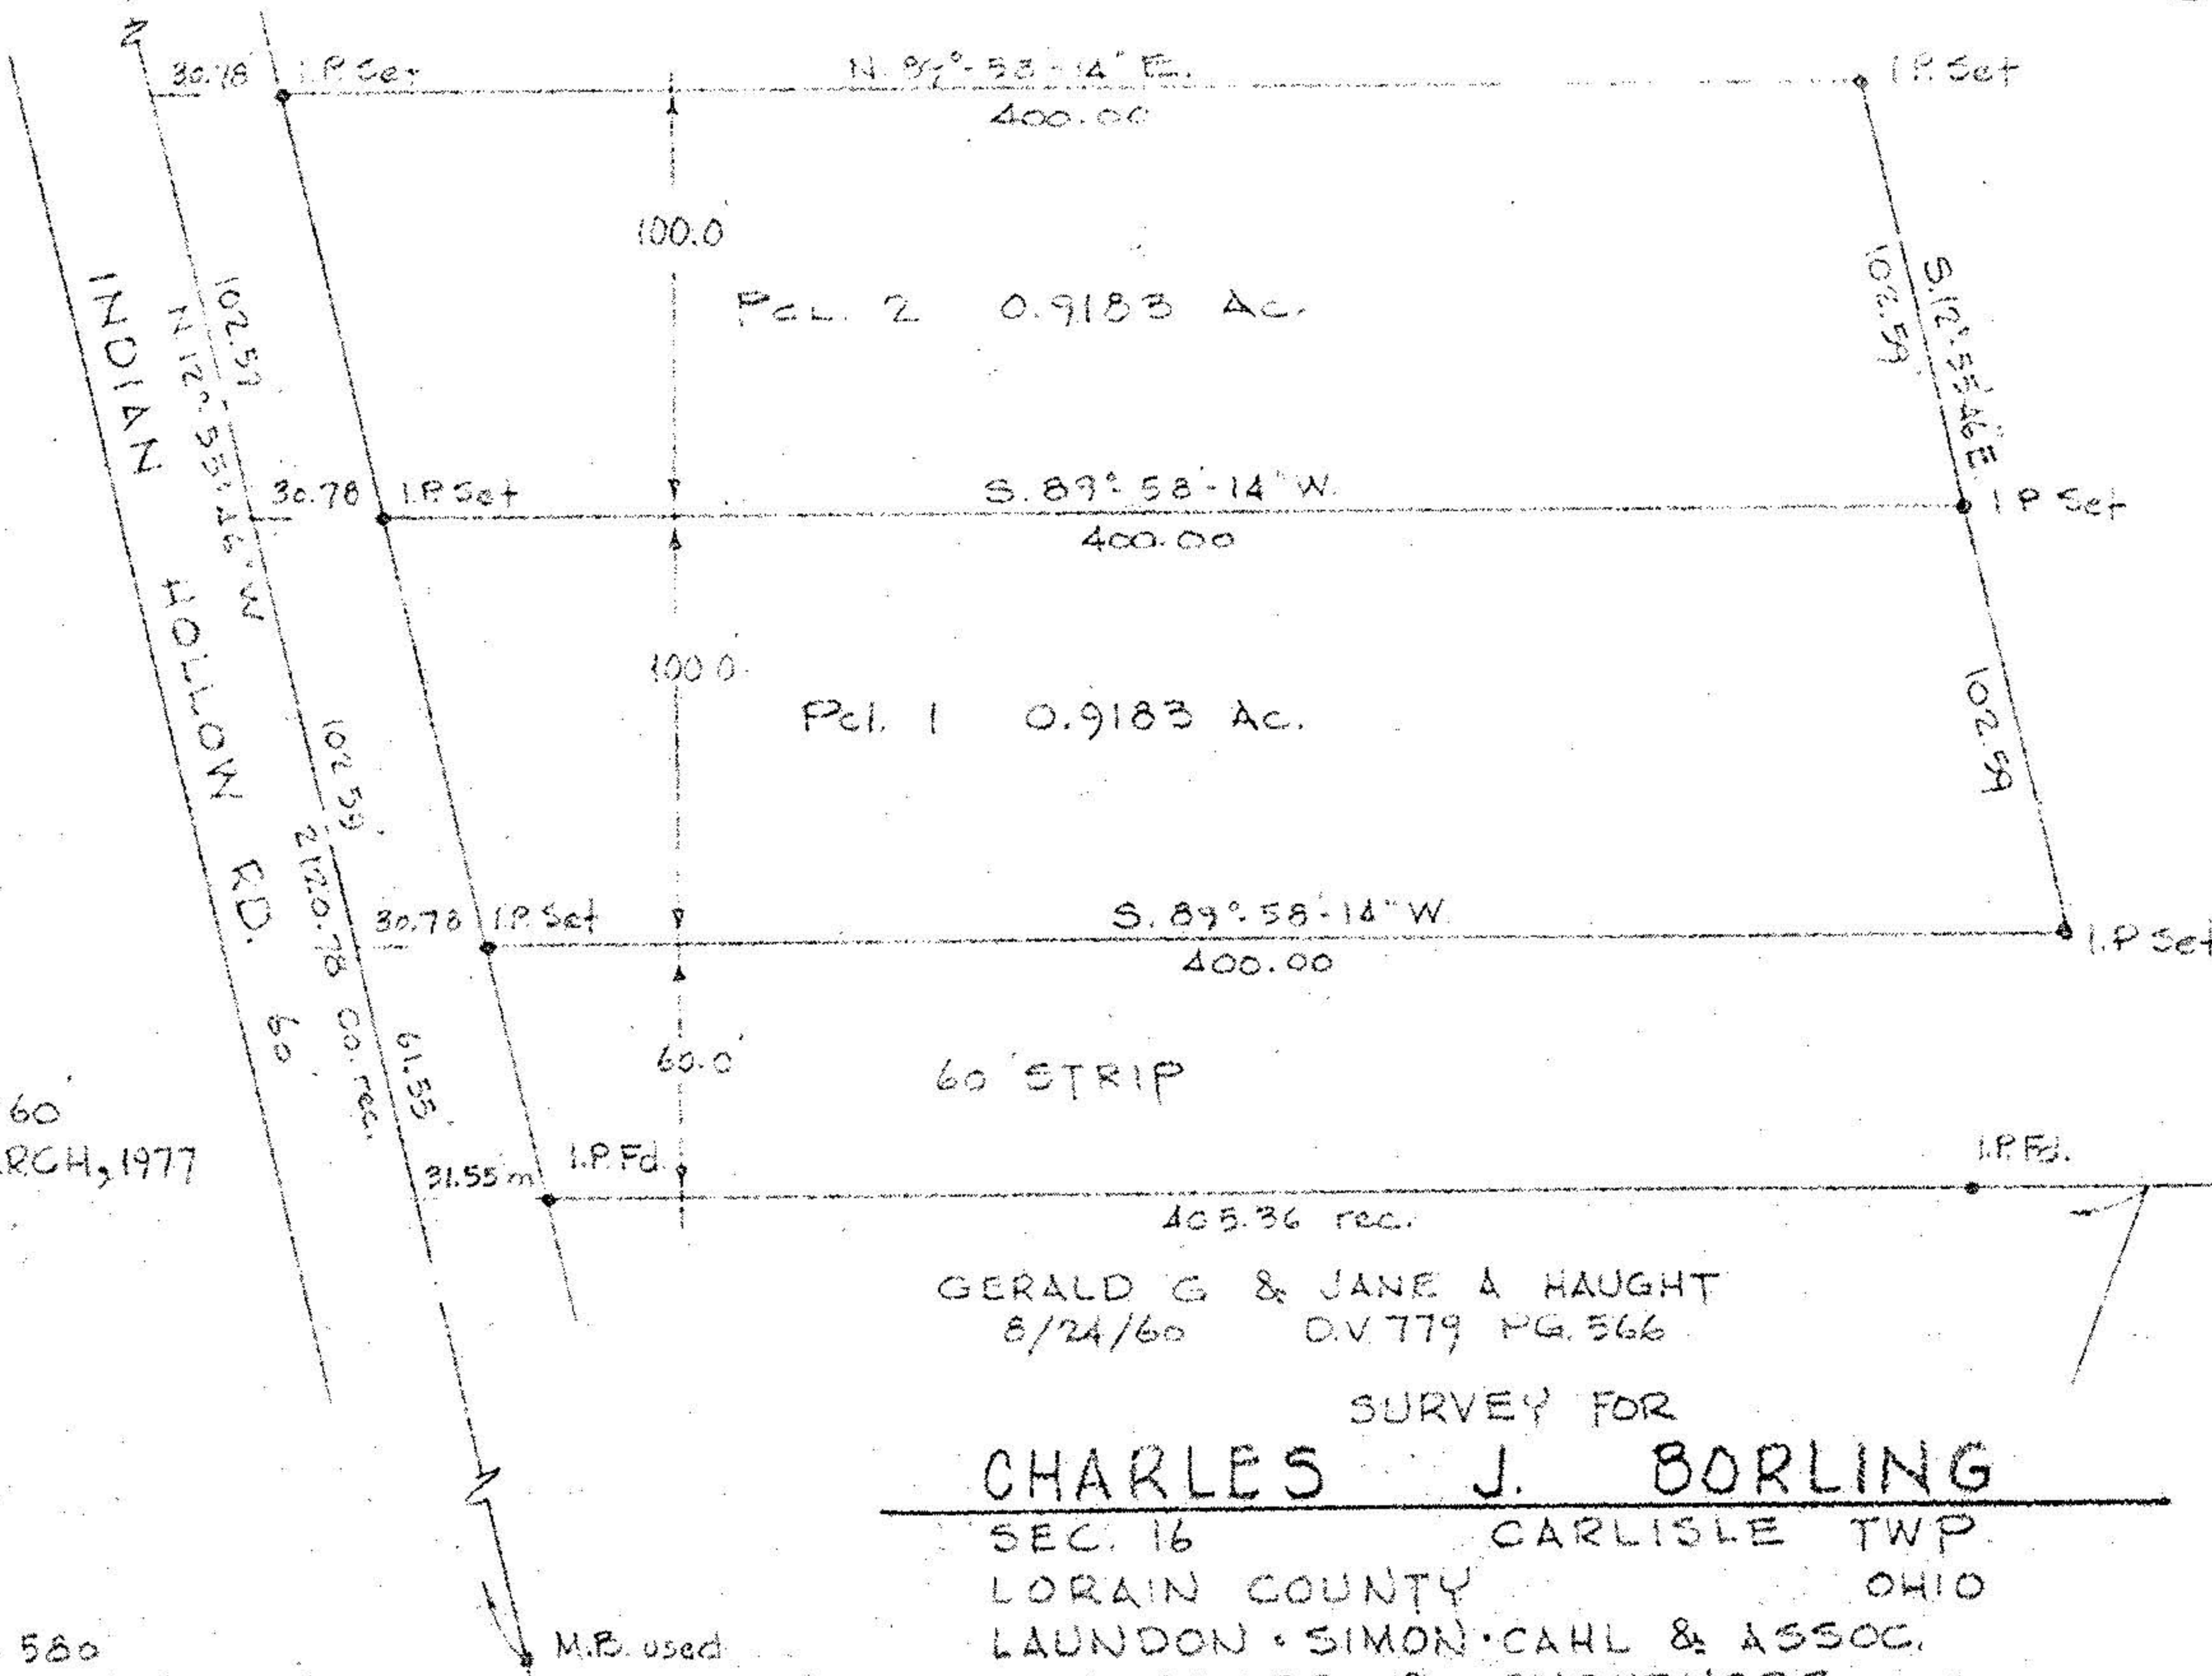

GERALD G & JANE A HAUGHT
8/24/60 D.V. 779 PG. 566

SURVEY FOR
CHARLES J. BORLING
SEC. 16 CARLISLE TWP.
LORAIN COUNTY OHIO
LAUNDON • SIMON • CAHL & ASSOC.
ENGINEERS & SURVEYORS