


11738

RANKS ROAD 60'

10-00-024-000

10-00-024-B

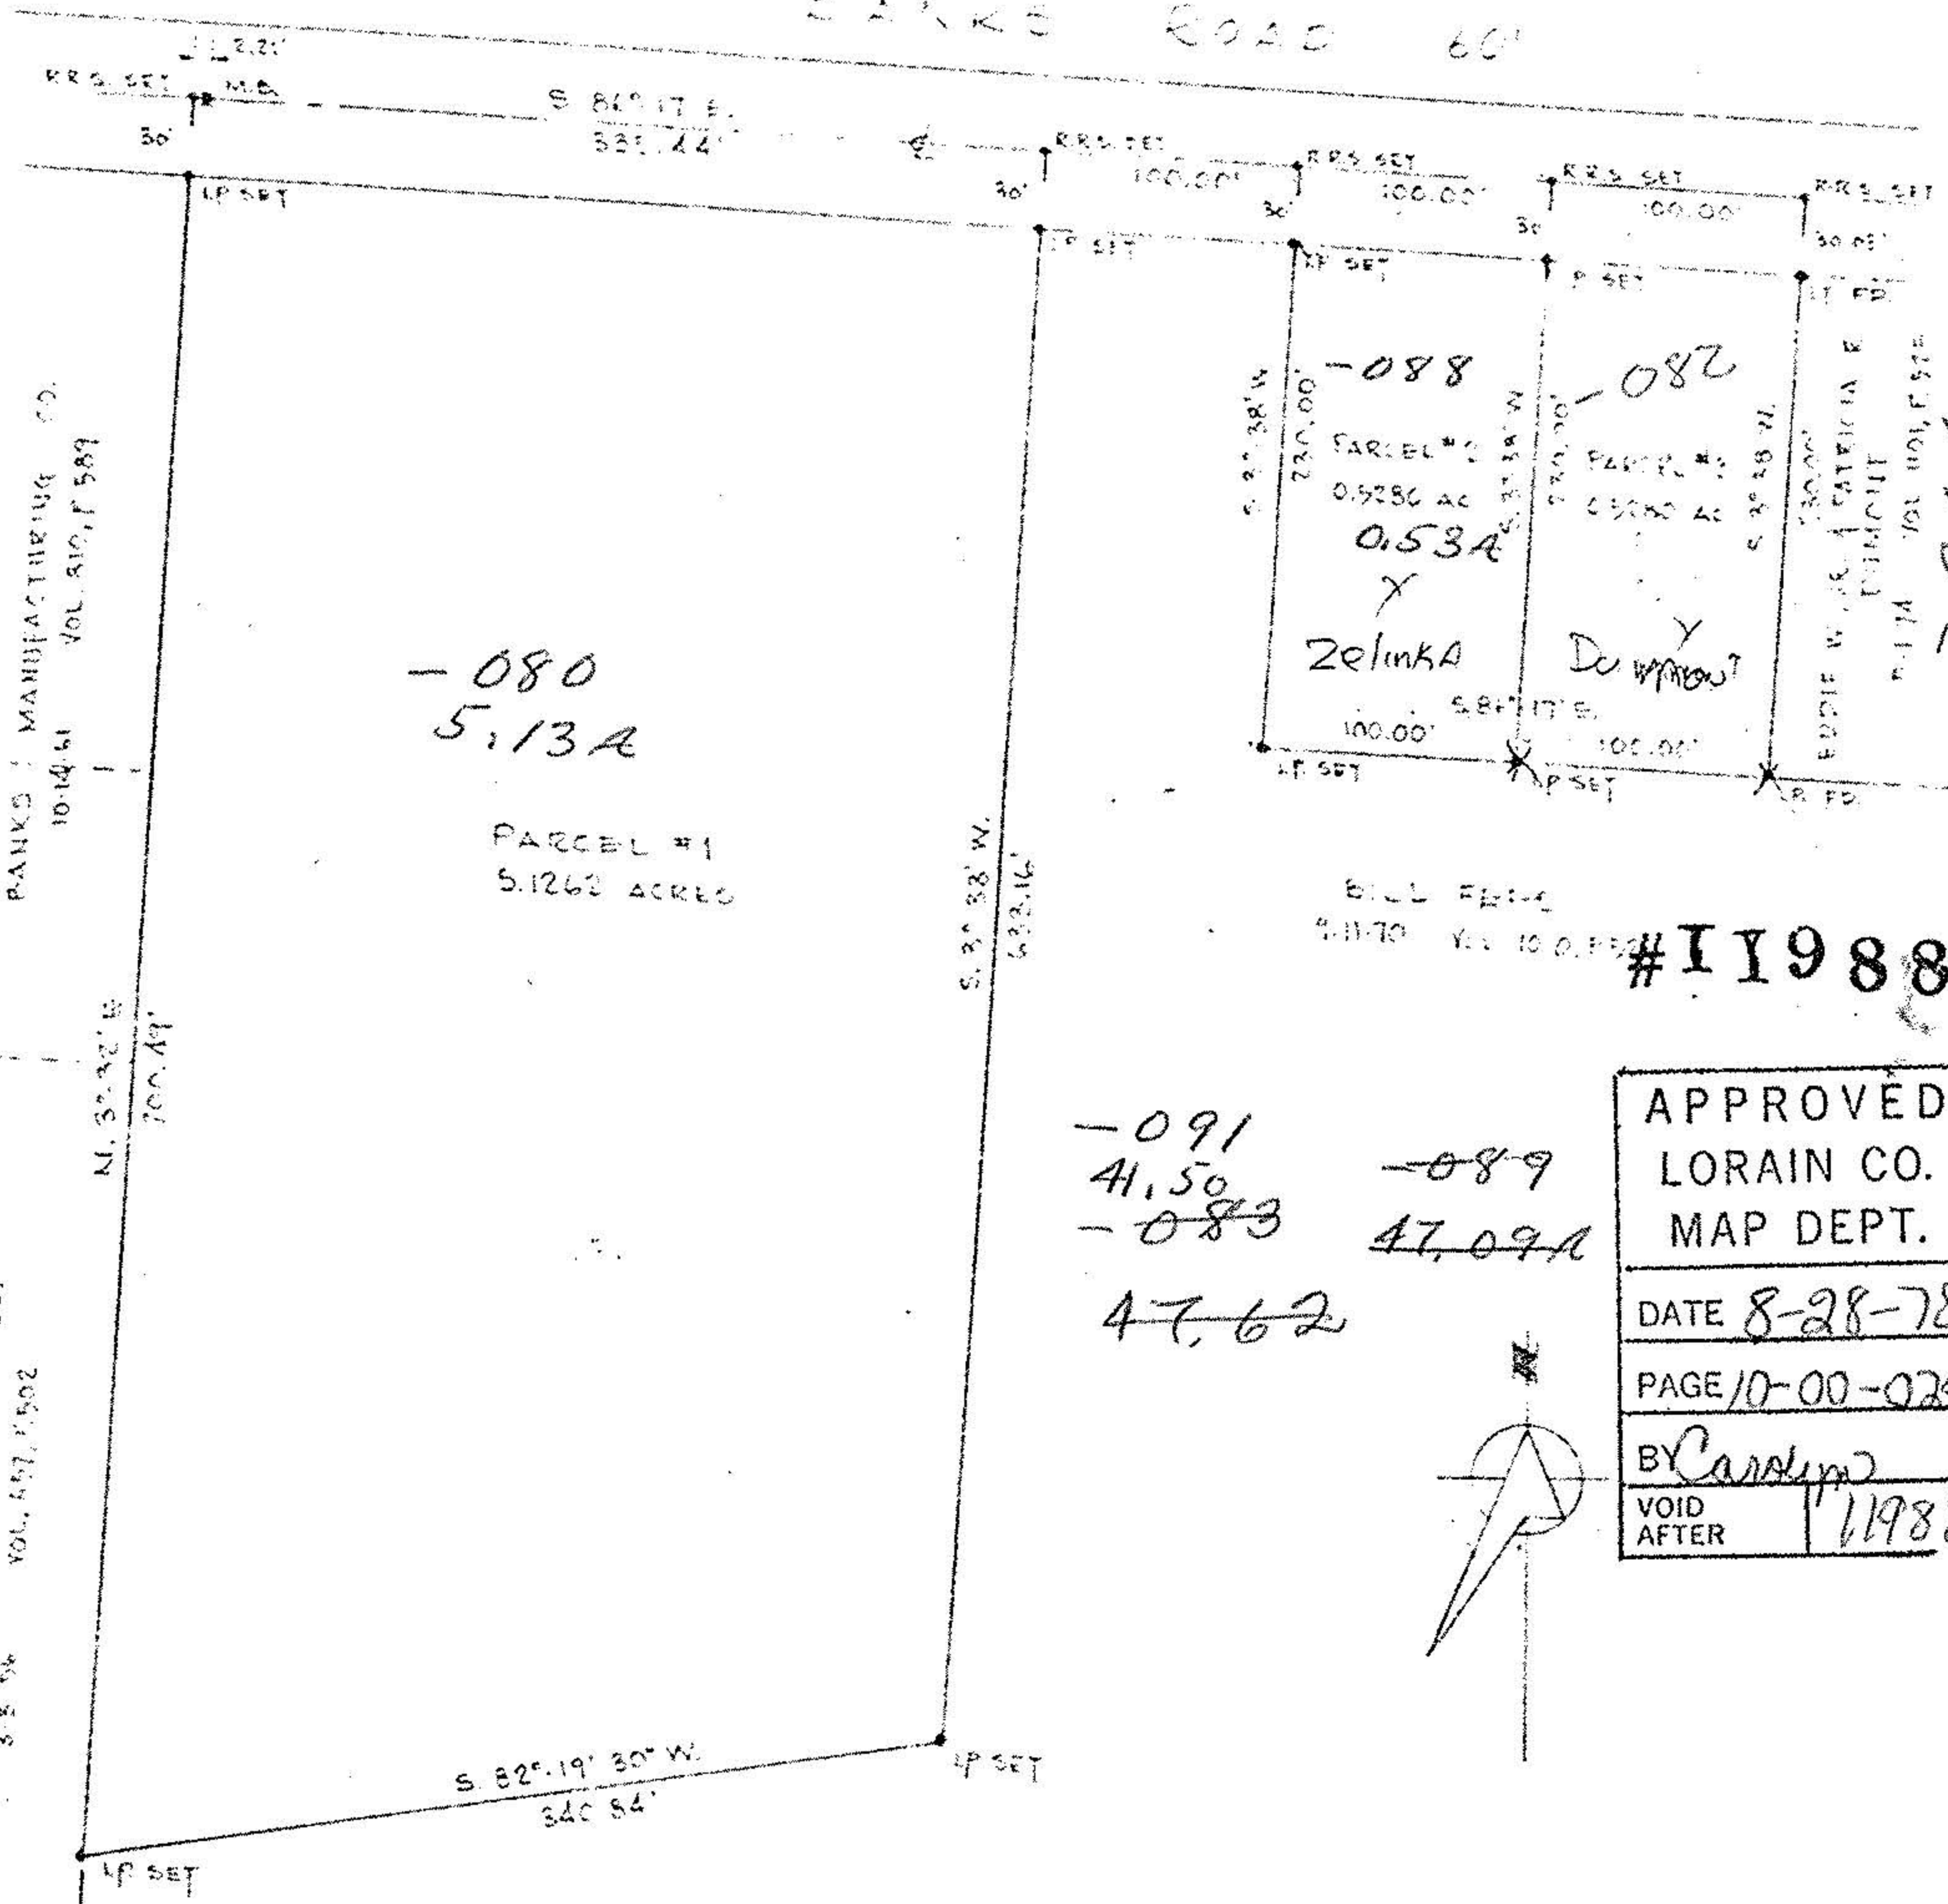

RANKS MANUFACTURING CO.
10-14-61 VOL. 519, P. 589

RANKS MANUFACTURING CO.
3-8-56 VOL. 457, P. 502

-080
5.13A

PARCEL #1
5.1262 ACRES

-088
PARCEL #2
0.5286 AC
0.534
Zelinka

-082
PARCEL #3
0.5286 AC
Dump


-091
41.50
~~-083~~
47.62

~~-089~~
47.09A

BILL FEES
\$11.70 VOL. 100, P. 502

#11988

APPROVED LORAIN CO. MAP DEPT.	
DATE	8-28-78
PAGE	10-00-024-B
BY	Caralyn
VOID AFTER	11988

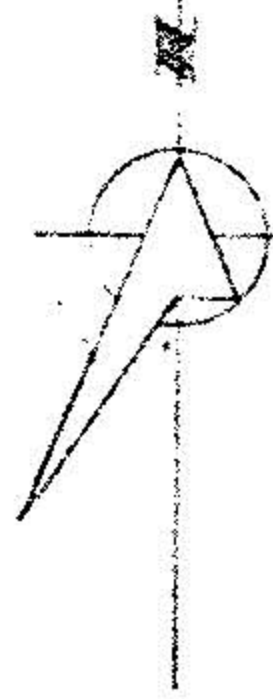

SURVEY

BILL FEES
O.L. 24 CARLISLE TWP.
LORAIN COUNTY, OHIO.

SCALE: 1"=100' APRIL 1978

LAUNDON SIMON CALL & ASSOC.
ENGINEERS SURVEYORS
78-716 R.F. #0, REC

10-00-024-B