


KS ASSOCIATES, INC.
 424 Middle Ave. P.O. Box 89
 ELYRIA, OHIO 44036
 (216) 322-6317

#18395

JOB _____
 SHEET NO. _____ OF _____
 CALCULATED BY _____ DATE _____
 CHECKED BY _____ DATE _____
 SCALE 1" = 100'

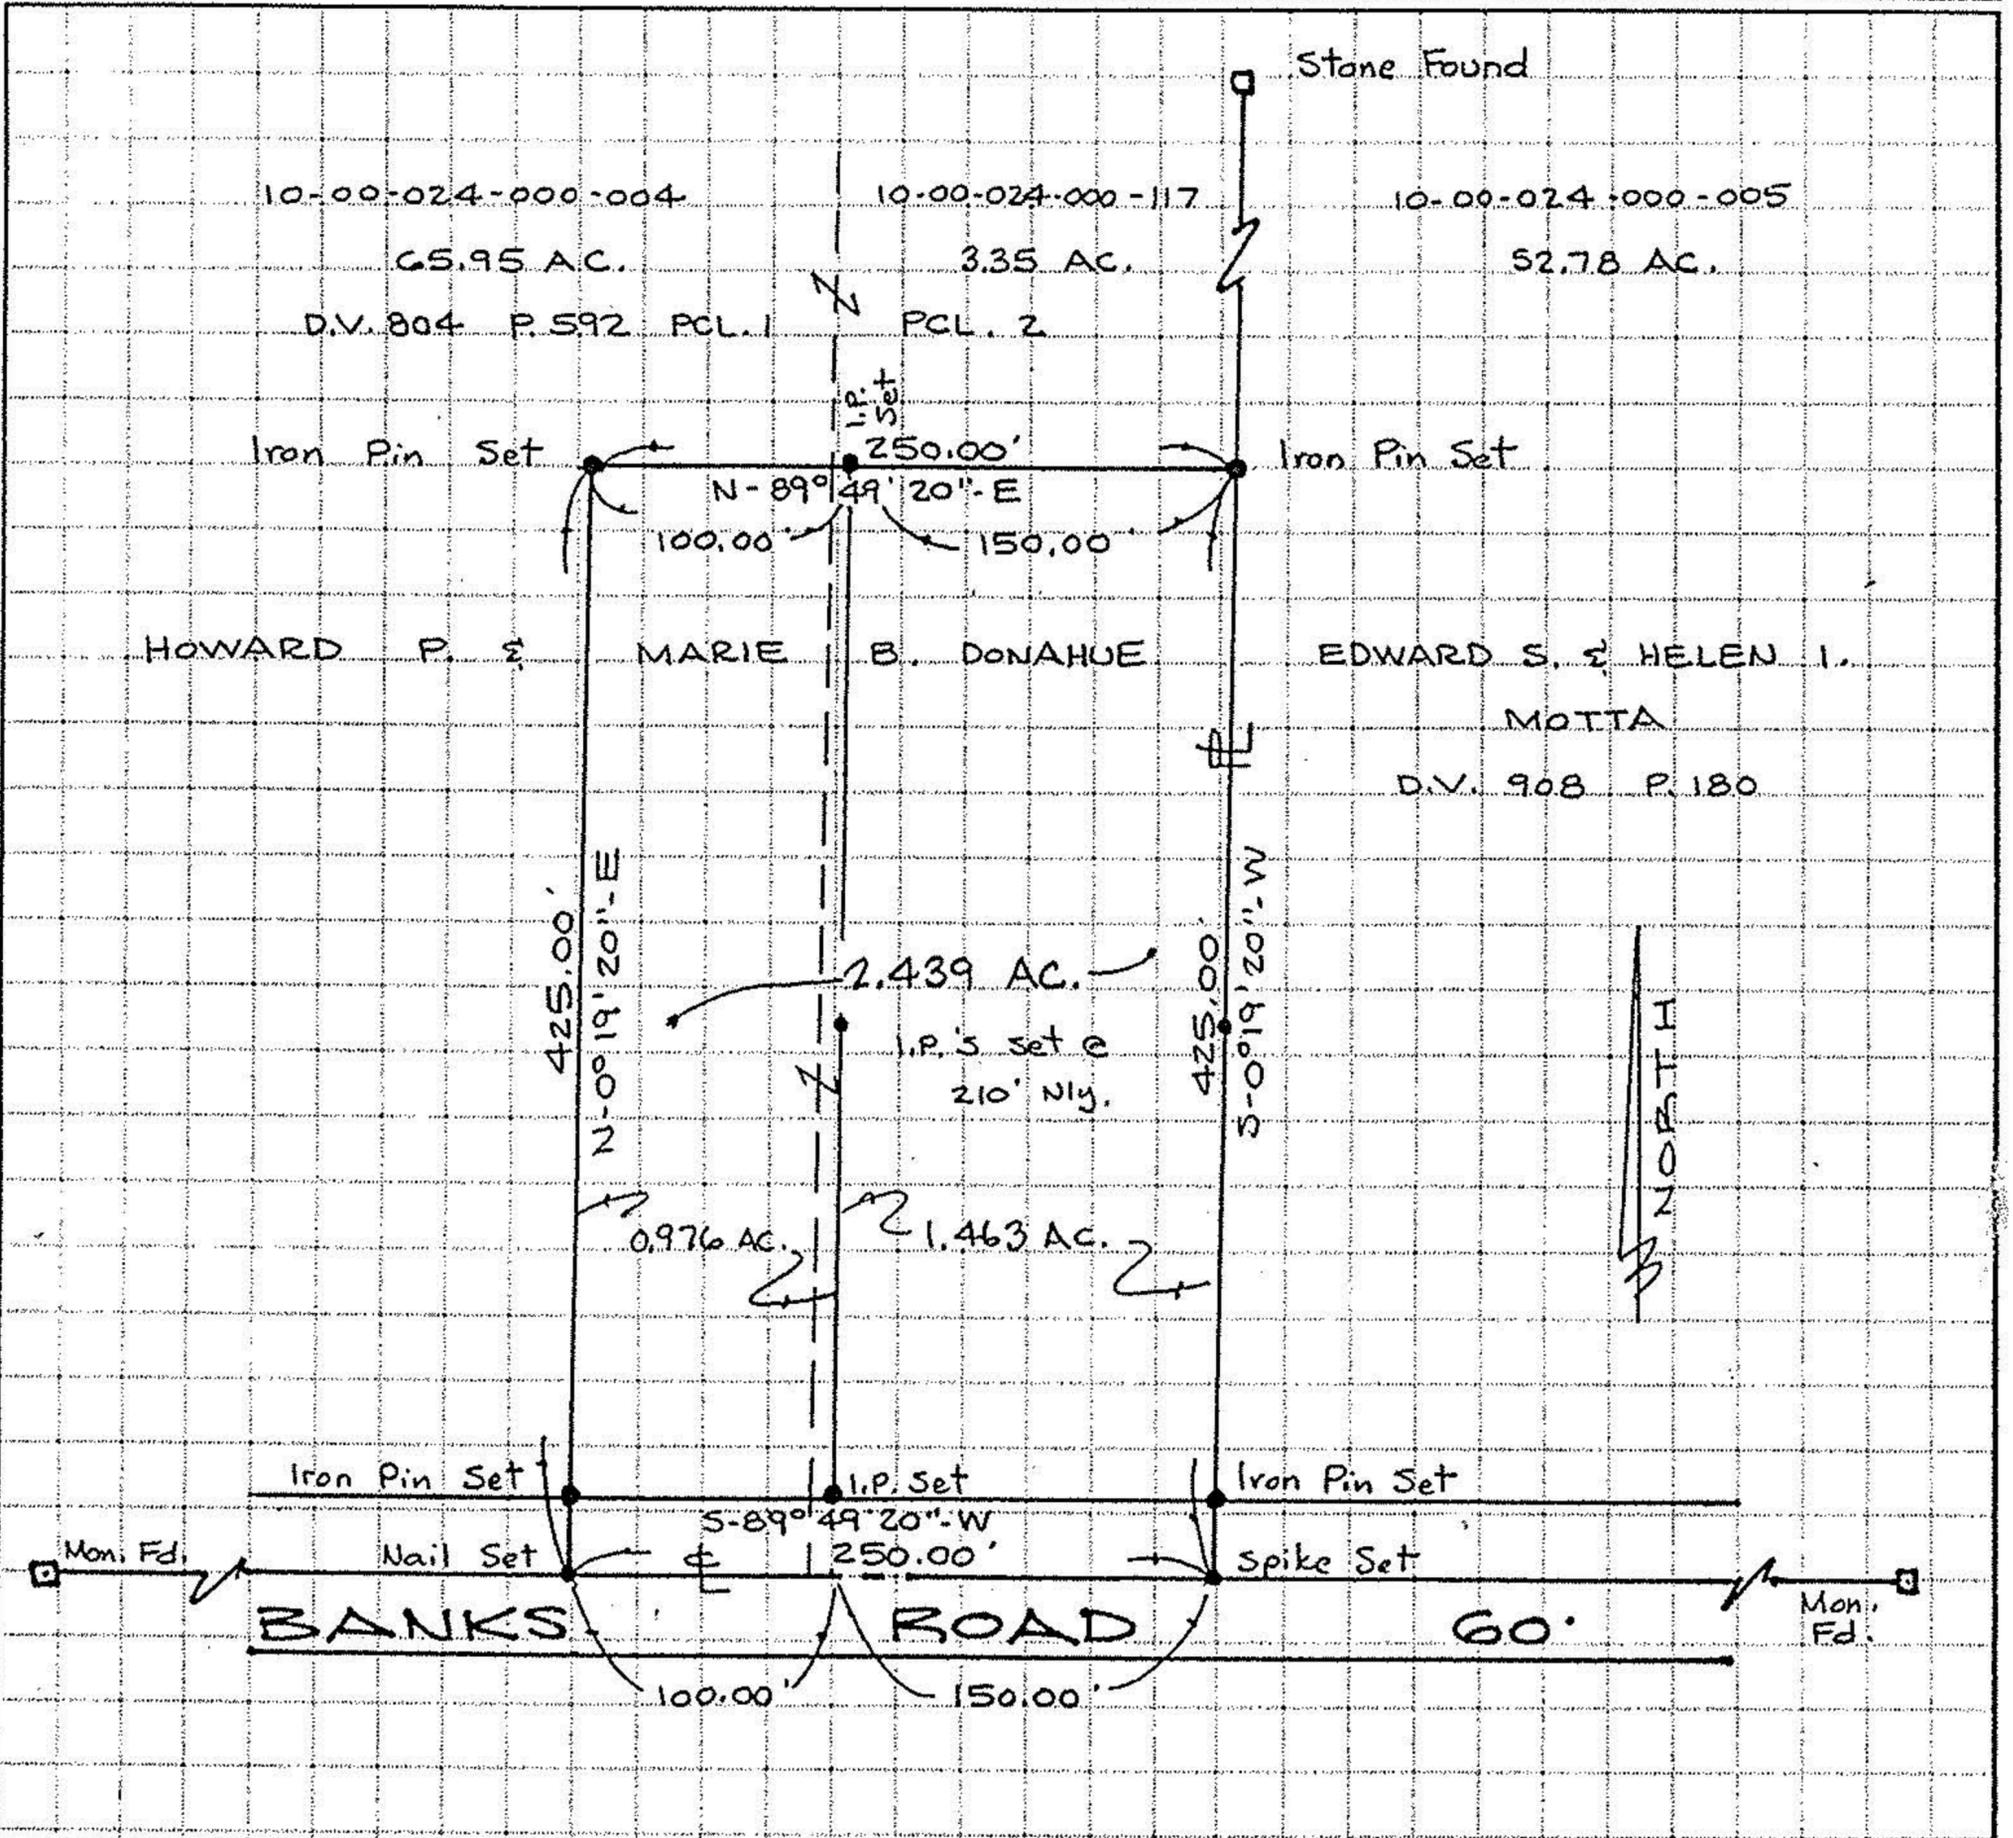


BOUNDARY SURVEY

PART OF CARLISLE TWP. SEC. NO. 24

TOWNSHIP OF CARLISLE

COUNTY OF LORAIN

STATE OF OHIO

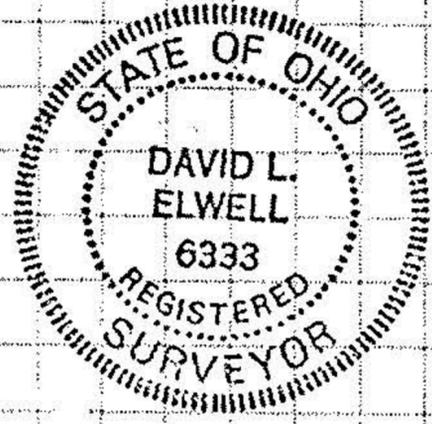

David L. Elwell
 REG. SURV. NO. 6333

REV. 4-7-89