


10-00-024-000  
#17786  
10-00-024-A



LAUNDON • SIMON • CAHL & ASSOC. INC.  
CONSULTING ENGINEERS & SURVEYORS  
504 MIDDLE AVENUE ELYRIA, OHIO 44035

SURVEY FOR  
**BANKS MANUFACTURING CO.**

Orig. Lot	City of	Date 3-29-84	Scale 1"=150'
Orig. Sec 24	Village of	Dwn. by R.G.S.	Chkd. by
Tract	County of LORAIN	Job No. 84-1269	F.B.
Township of CARLISLE	State of OHIO	Printed	

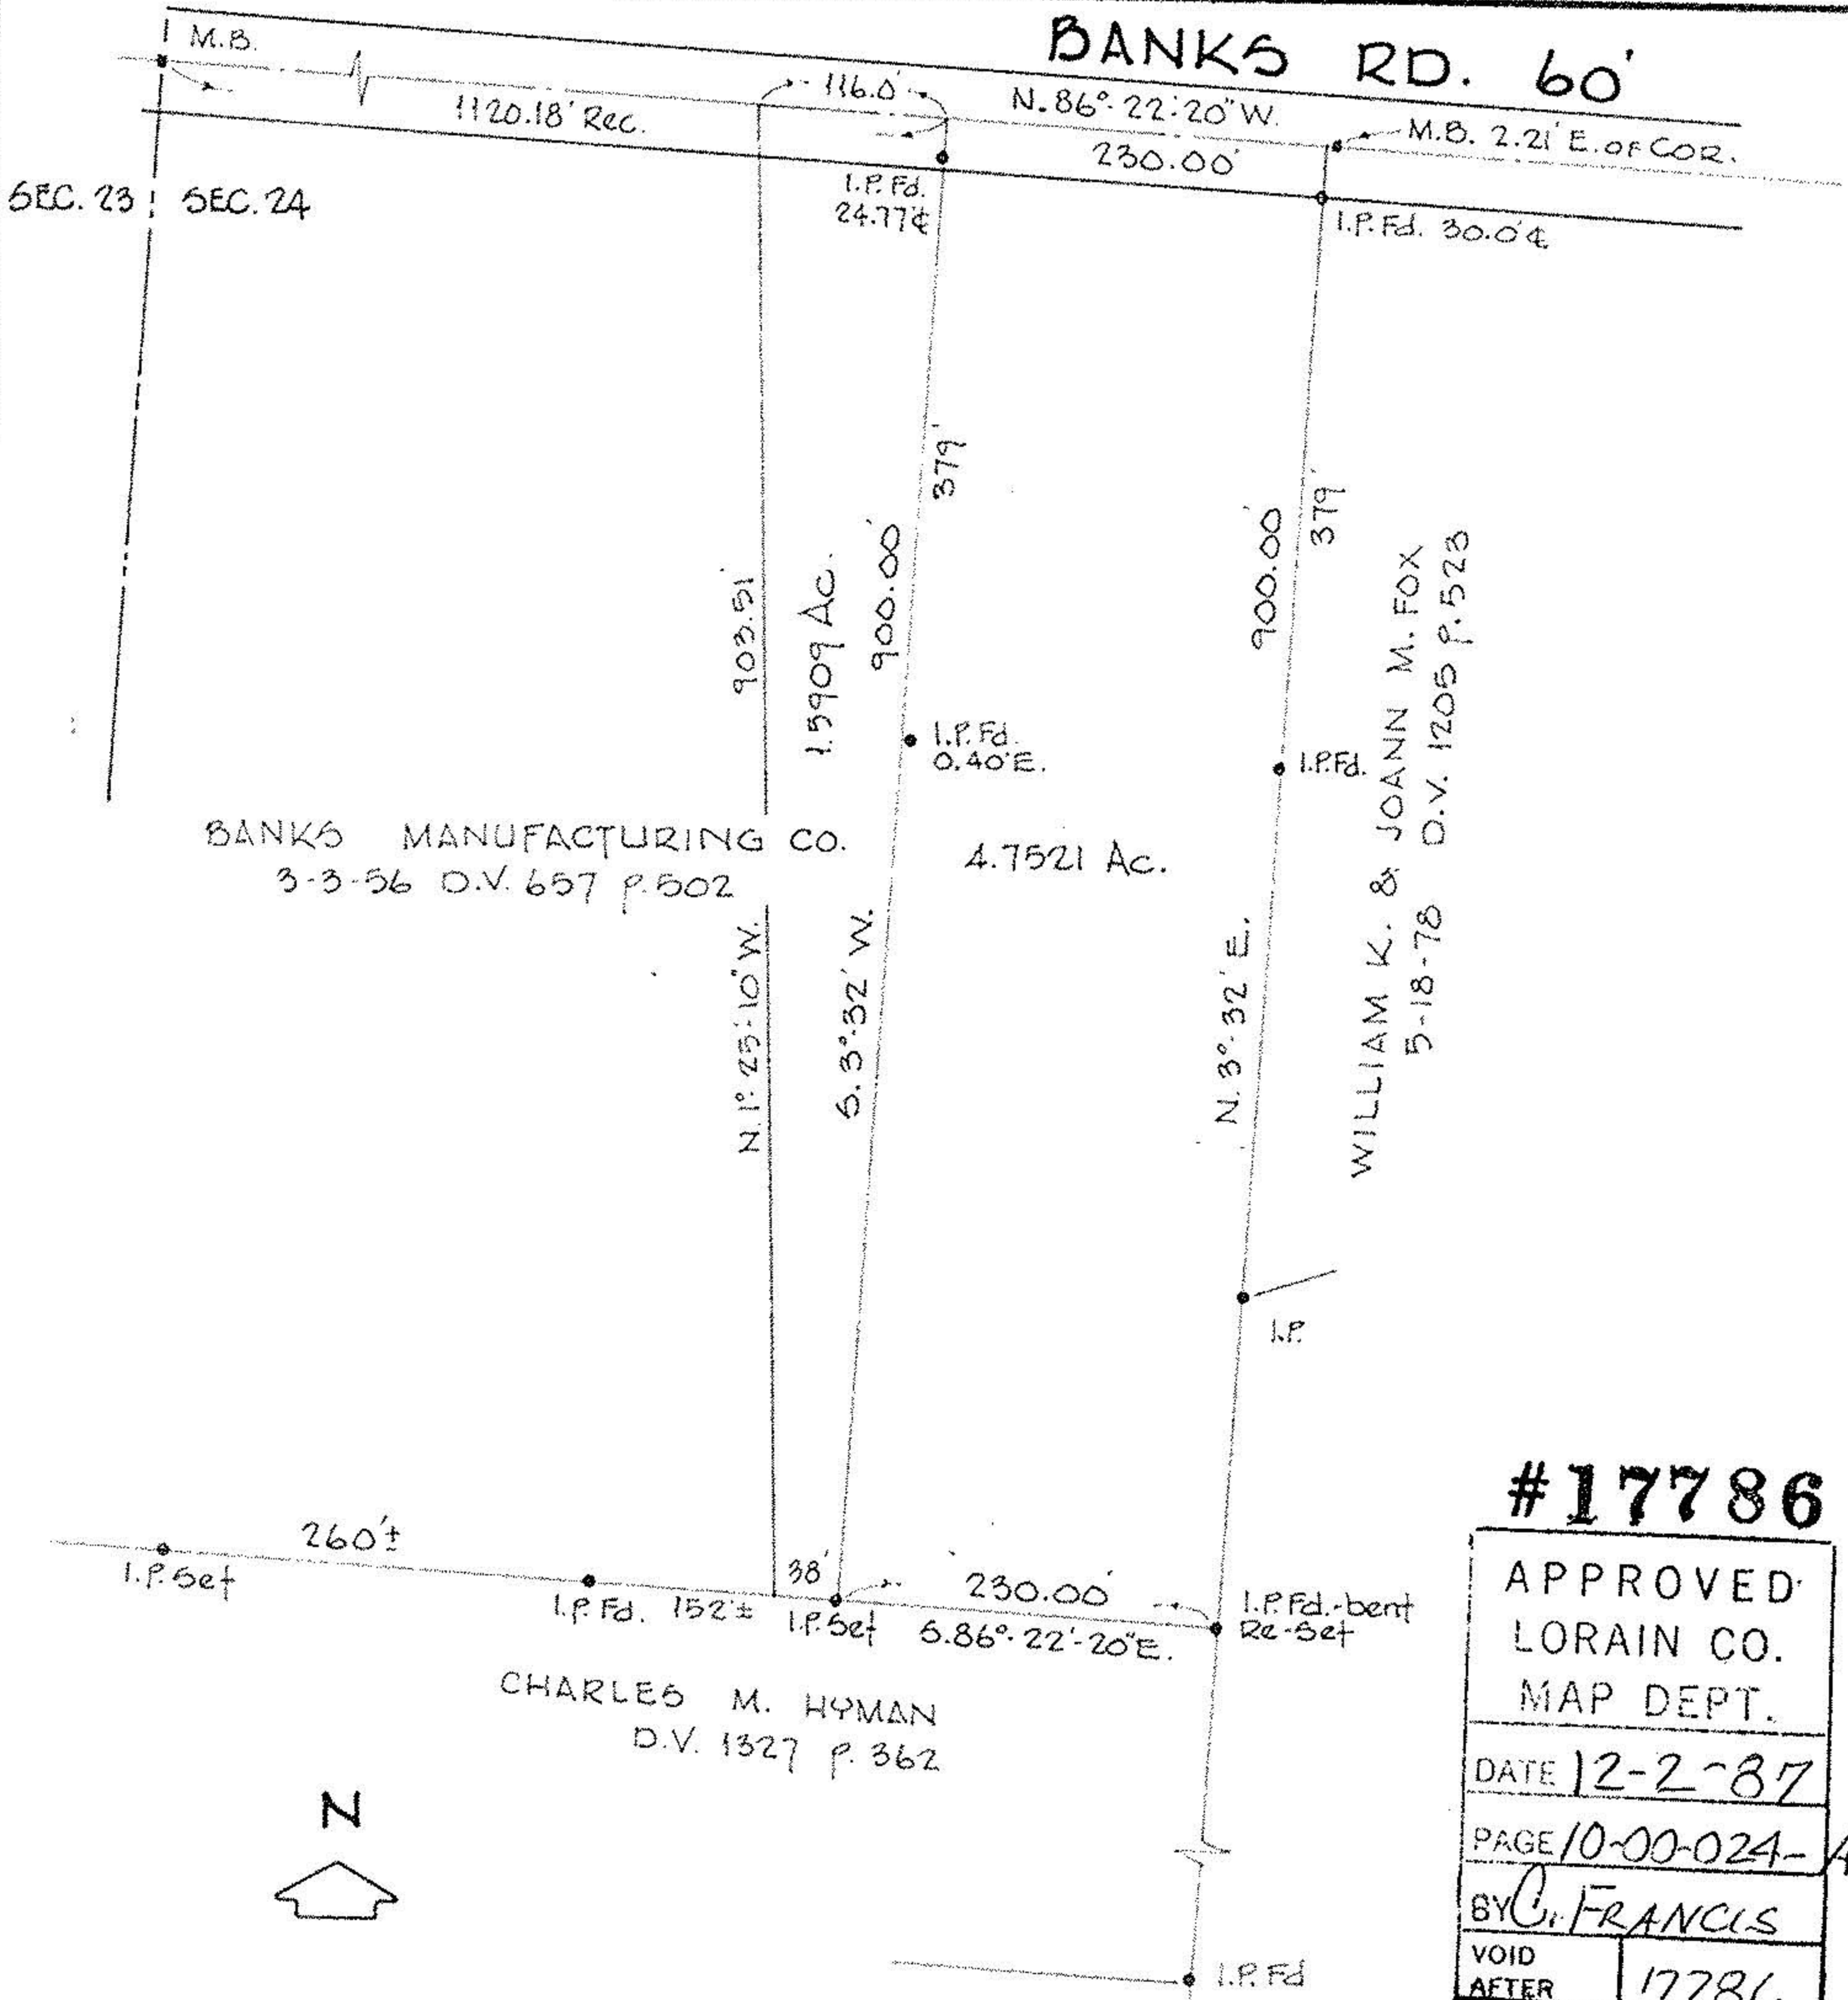

**#17786**

APPROVED  
LORAIN CO.  
MAP DEPT.

DATE 12-2-87

PAGE 10-00-024-A

BY G. FRANCIS

VOID AFTER 17786