



LAUNDON • SIMON • CAHL and ASSOC.
ENGINEERS
504 MIDDLE AVE.

SURVEYORS
ELYRIA, OHIO 4035

FOR: JAMES CHANDLEY

TOWNSHIP CARLISLE
ORIG. LOT or SEC. 20
CITY


VILLAGE
COUNTY LORAIN
STATE OHIO

DATE 2-28-80
SCALE 1" = 80
JOB NO. 80-953 F.B. 125/39

HASTINGS RD.

10-00-010-103-076

10-00-010-F

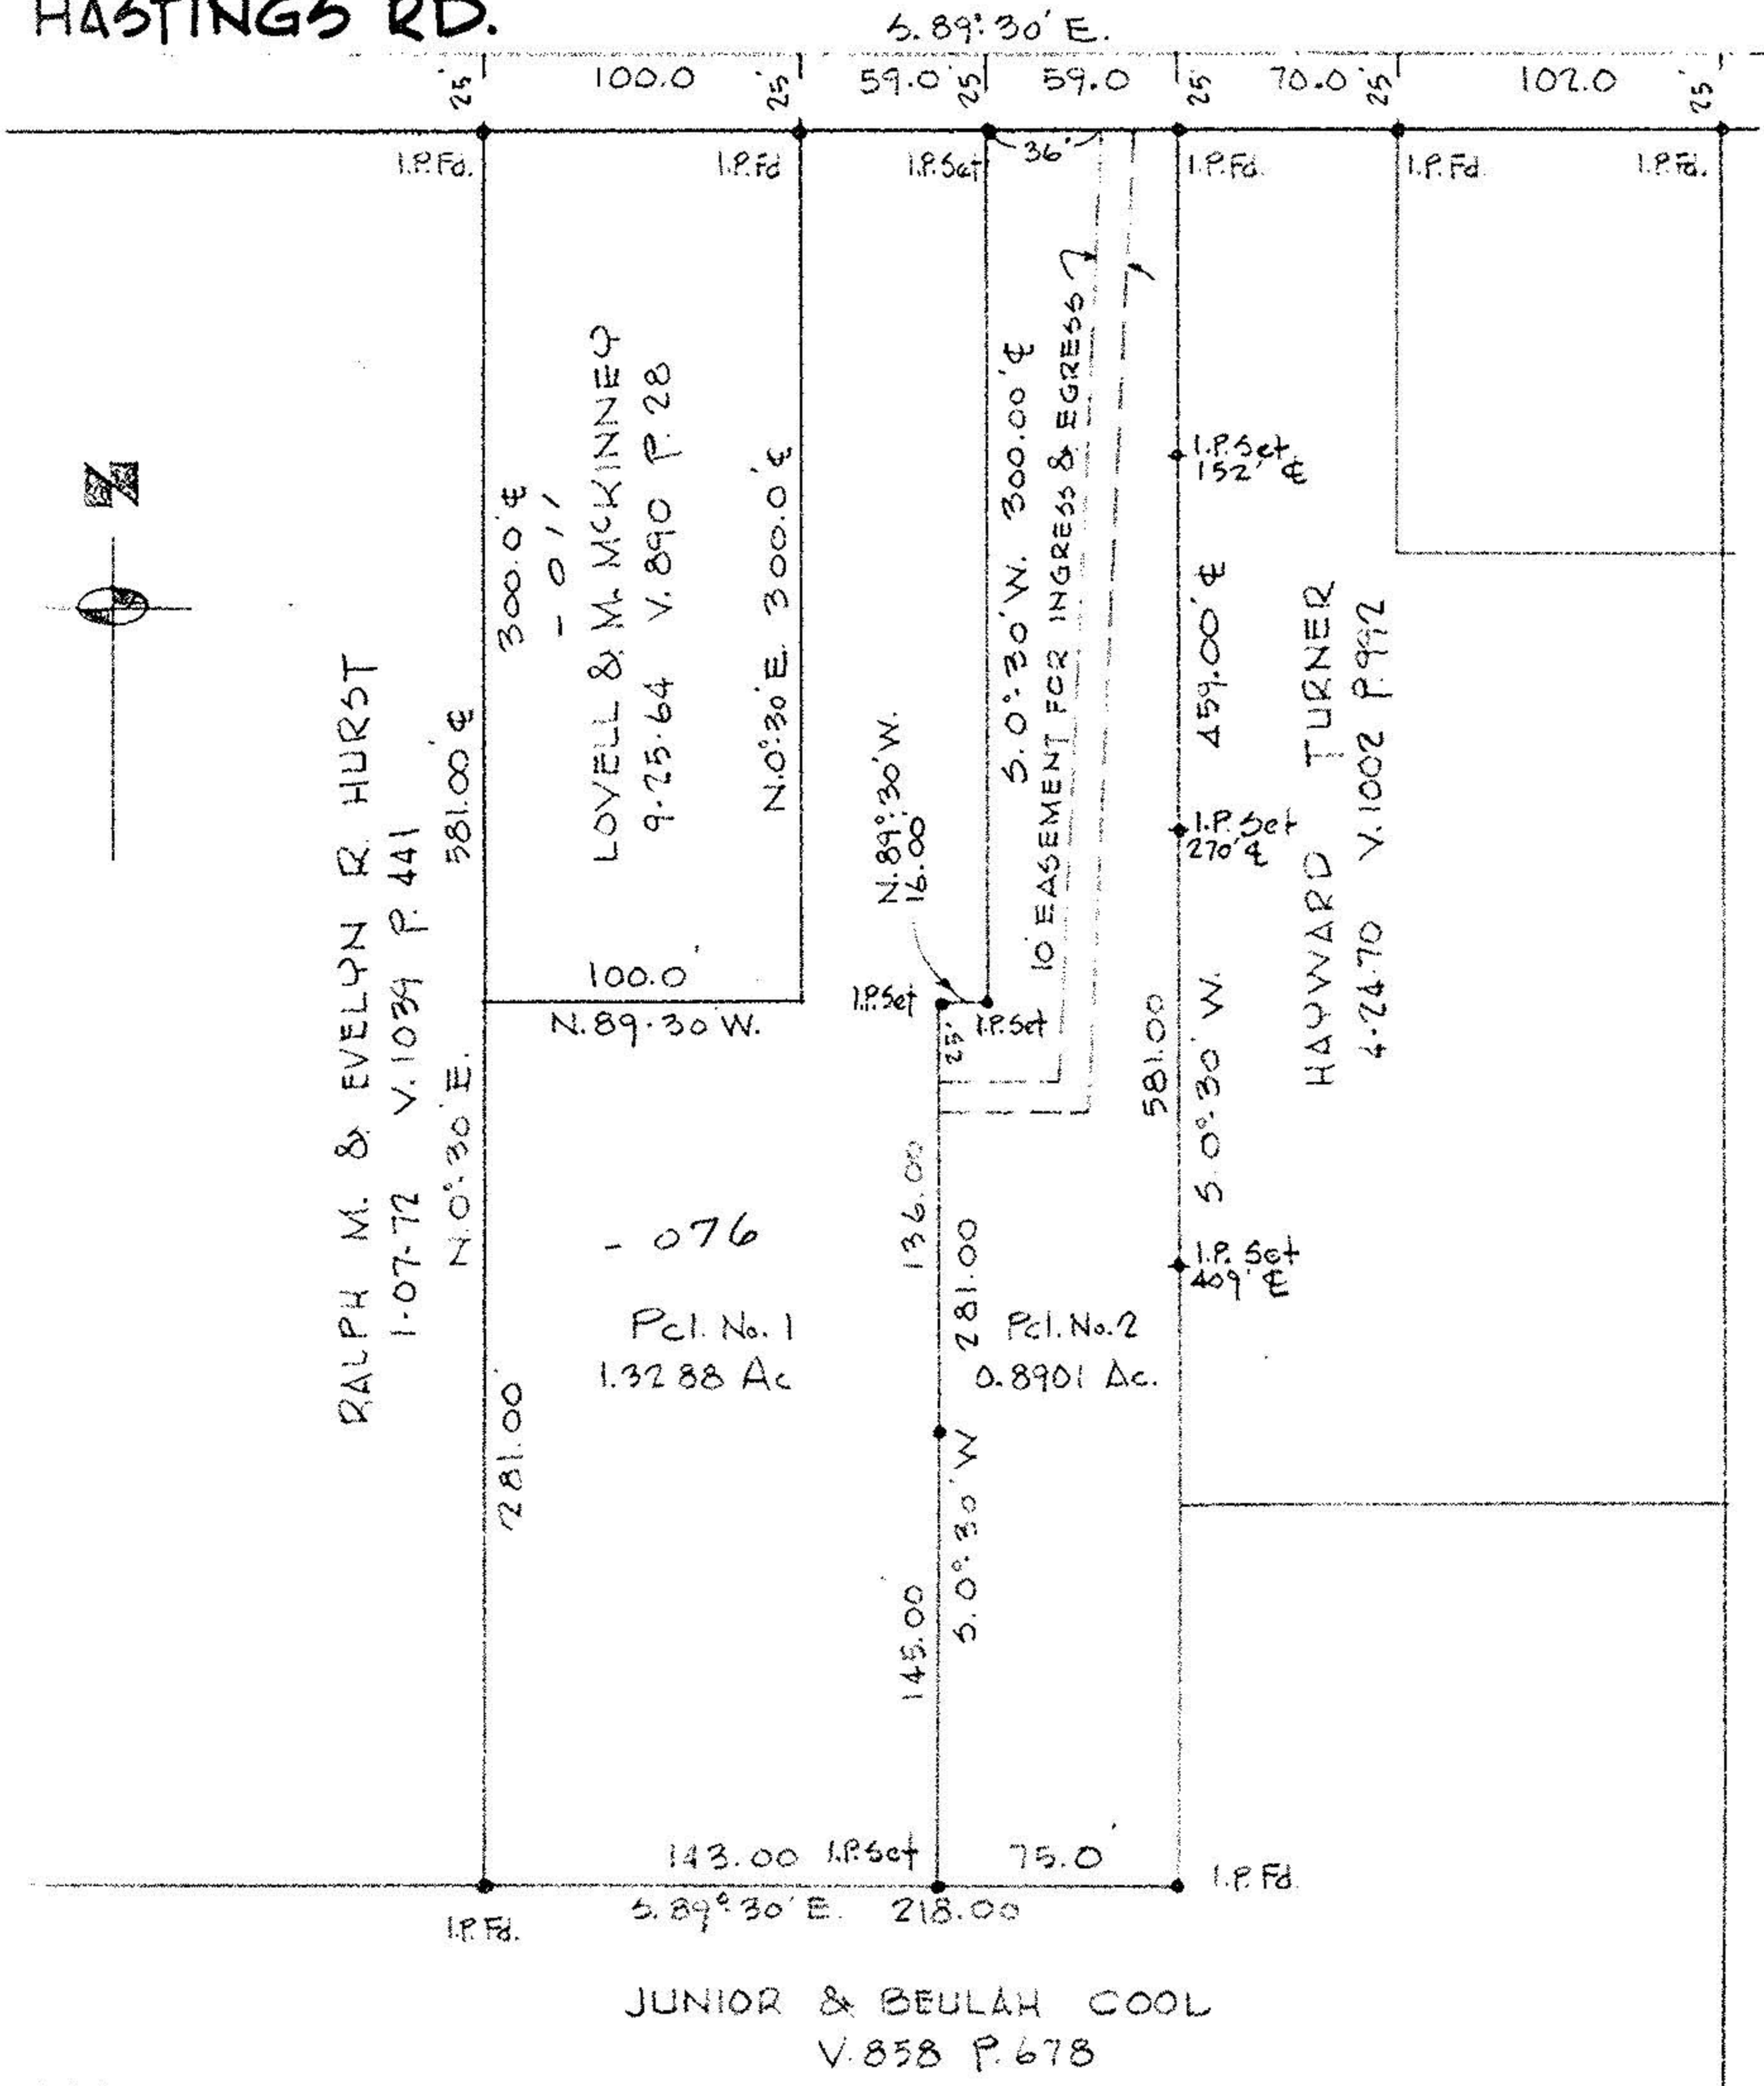

RALPH M. & EVELYN R. HURST
1-07-72 V. 1039 P. 441

LOVELL & M. MCKINNEY
9-25-64 V. 890 P. 28

HAYWARD TURNER
4-24-70 V. 1002 P. 992

- 076
Pct. No. 1
1.3288 Ac

Pct. No. 2
0.8901 Ac

JUNIOR & BEULAH COOL
V. 858 P. 678