

10516  
**SURVEY**

**KLEINOEDER-SCHMIDT**  
and ASSOCIATES  
ENGINEERS — SURVEYORS — CONSULTANTS IN LAND PLANNING  
ELYRIA - NORWALK - MEDINA OHIO


Sublot(s) \_\_\_\_\_  
Subd'n \_\_\_\_\_

Township CARLISLE Tract \_\_\_\_\_  
Orig. Lot(s) \_\_\_\_\_ Sec. 20  
County of LORAIN State of Ohio  
Corporation \_\_\_\_\_

020-00-01

MAY 20 1977

SEC. NO. 11  
SEC. NO. 20

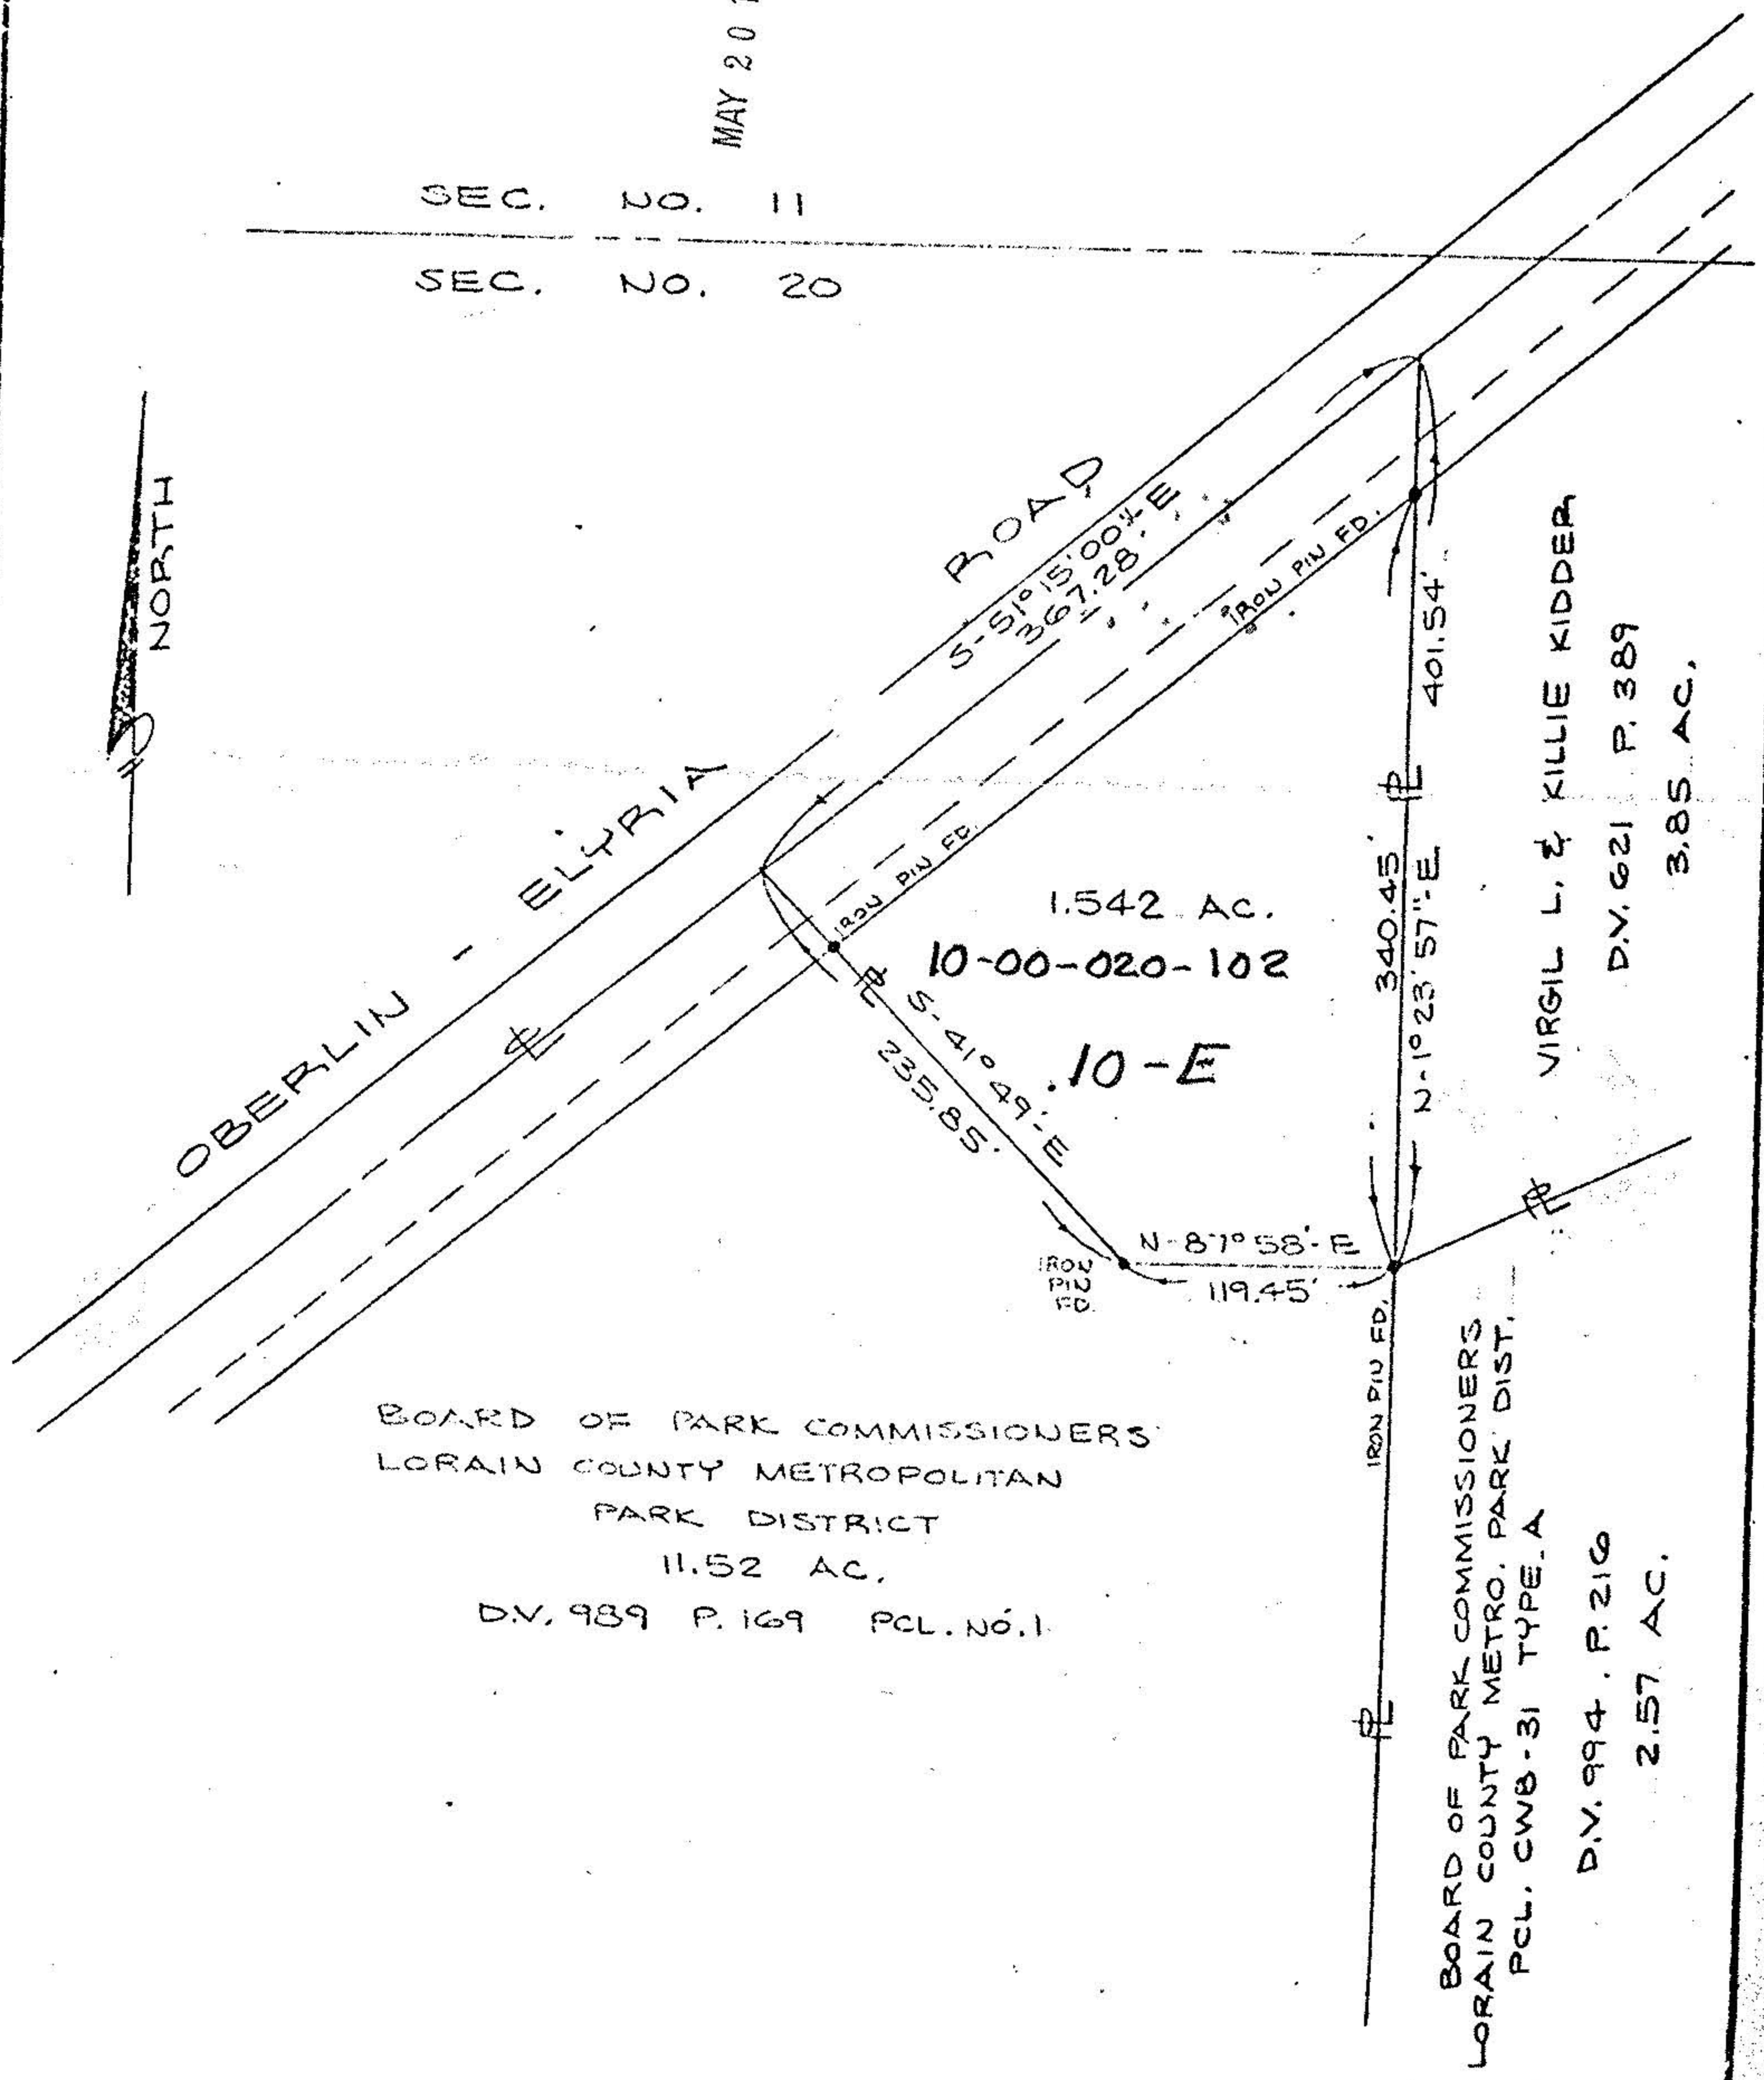

Prepared for:

Scale: 1" = 100'

Date: MAR. 14, 1977

Dr. by: *ES*

Job No 68-221

10-00-020