


Twin Creek Farms,  
 Inc. - Pct. No. 2  
 Clarence Faber  
 D. Vol. 212 Pg. 337

NOTE: ● indicates iron pin set.  
 □ indicates iron pin found  
 in monument box.

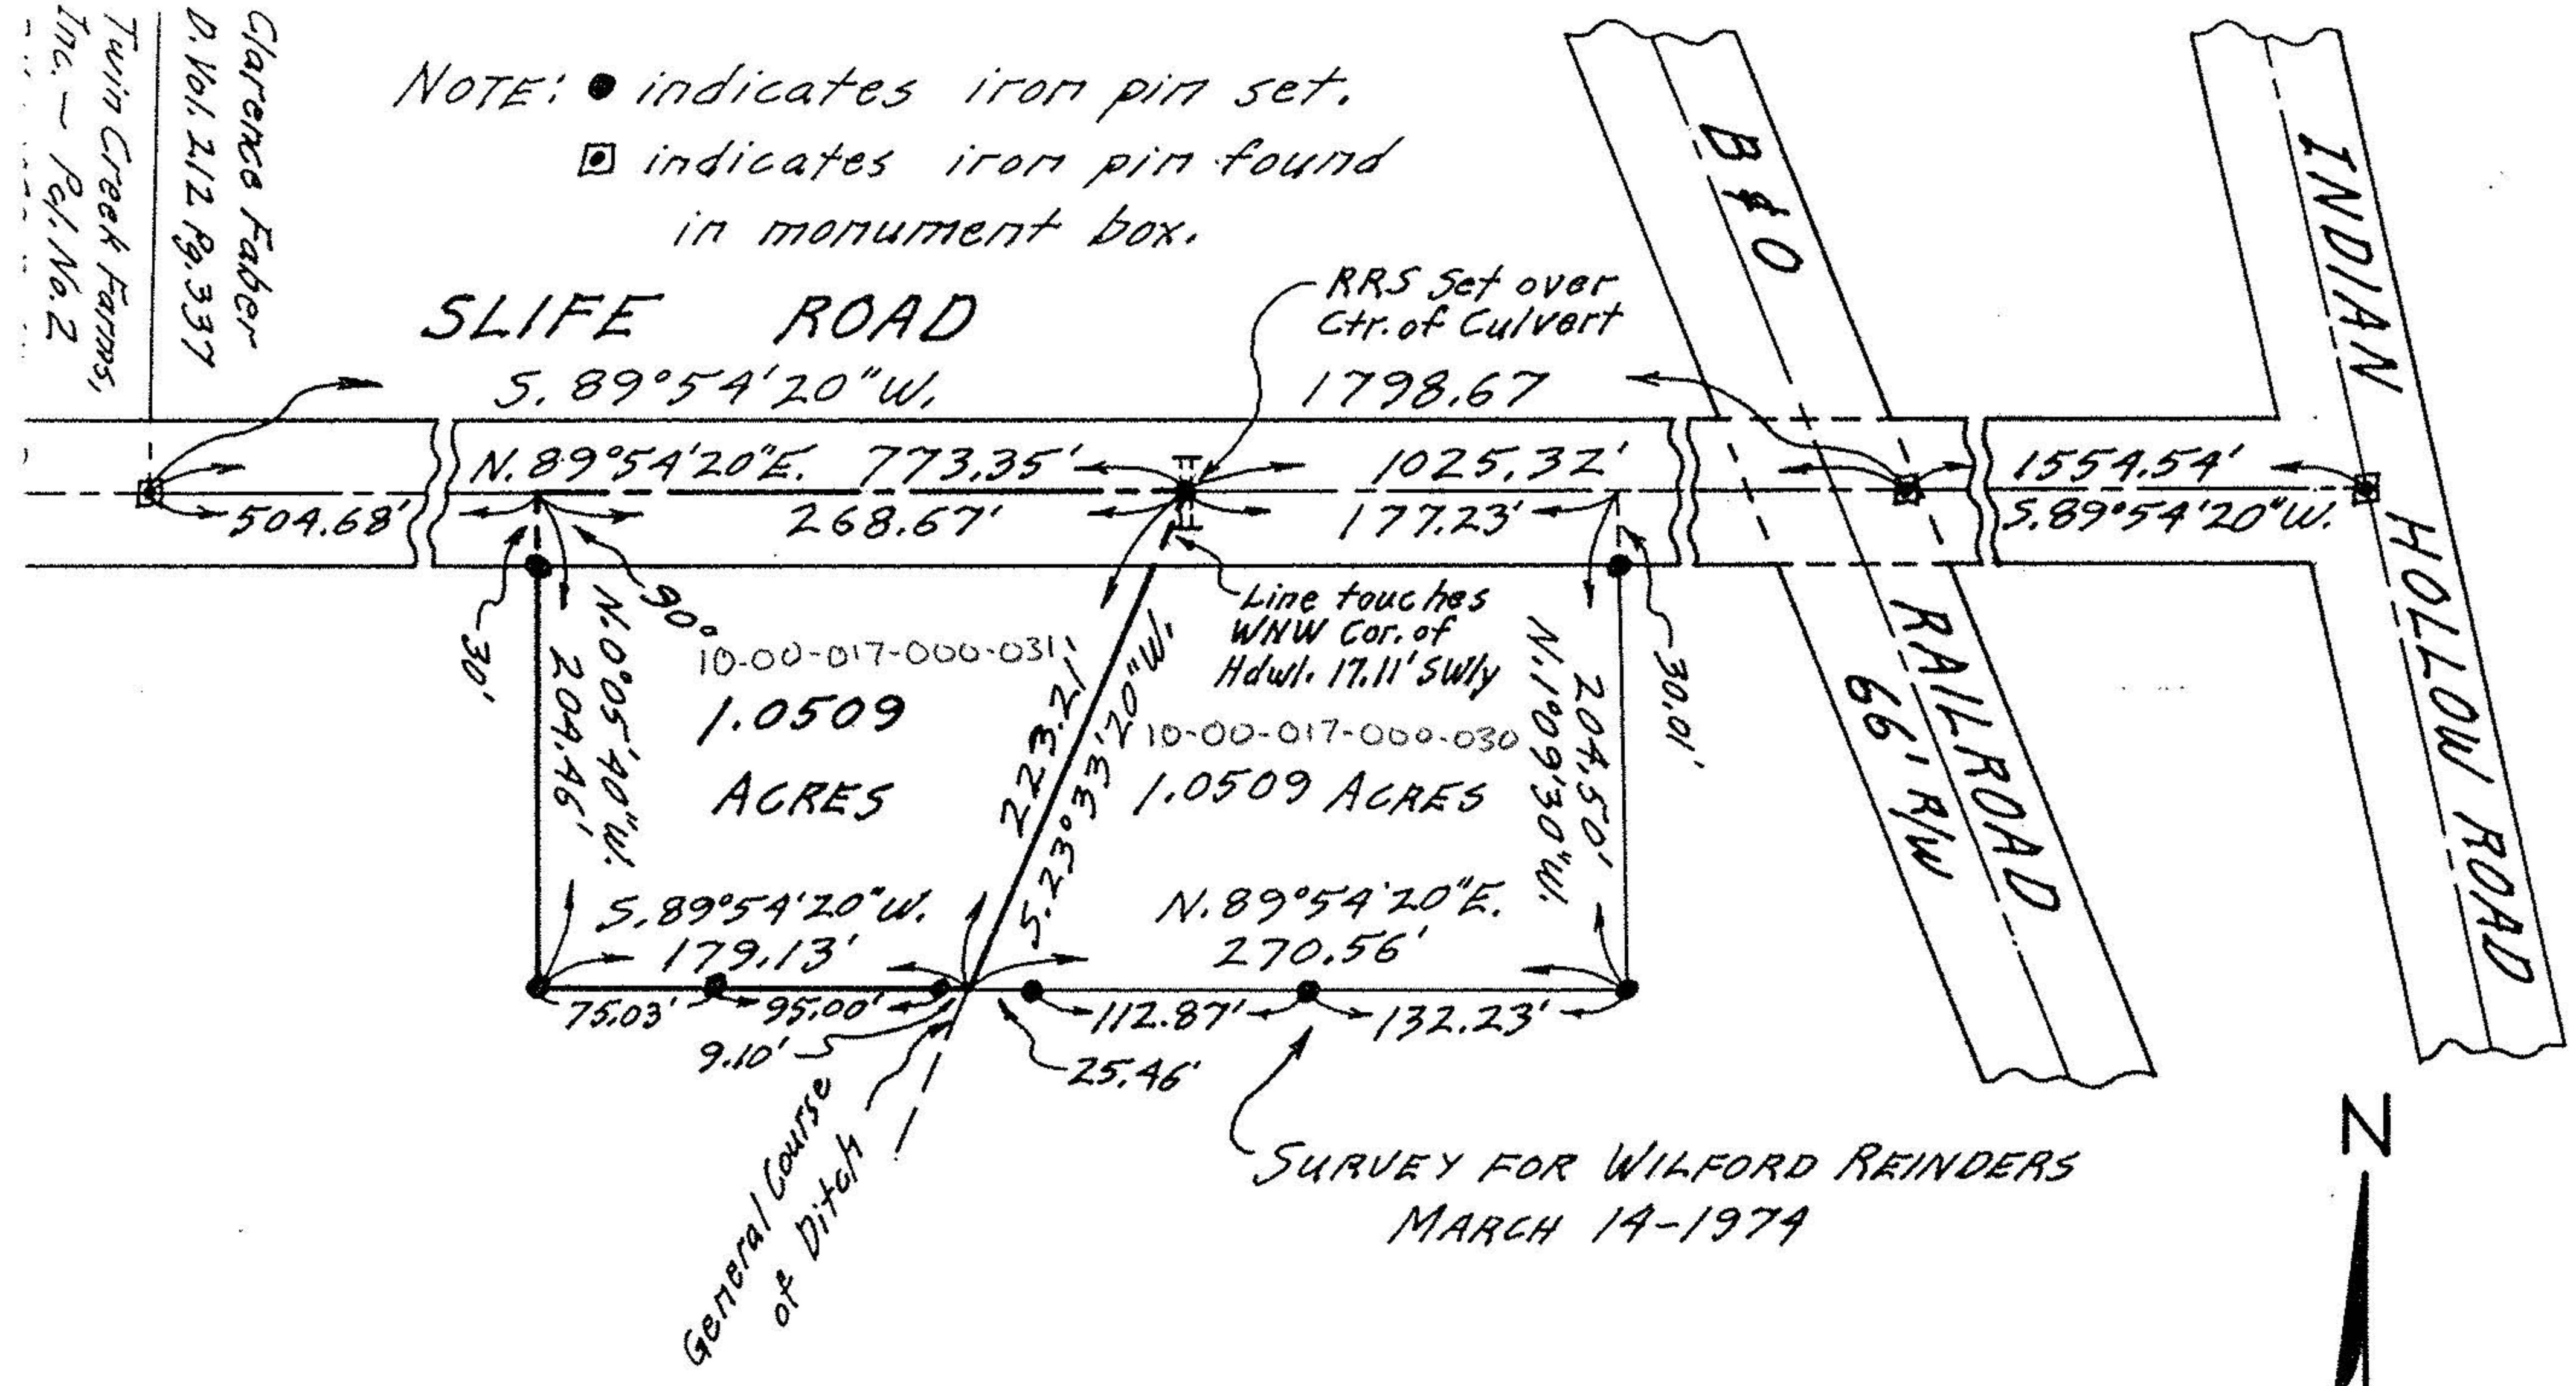

PLAT OF SURVEY FOR RICHARD REINDERS  
 PART OF LAND OF TWIN CREEK FARMS, INC.  
 ORIGINAL SECTION NO. 17 CARLISLE TWP.  
 LORAIN COUNTY OHIO  
 SCALE: 1" = 100' MARCH 18 - 1974  
 Gary E. Penfound Reg. Surveyor No. 4457